


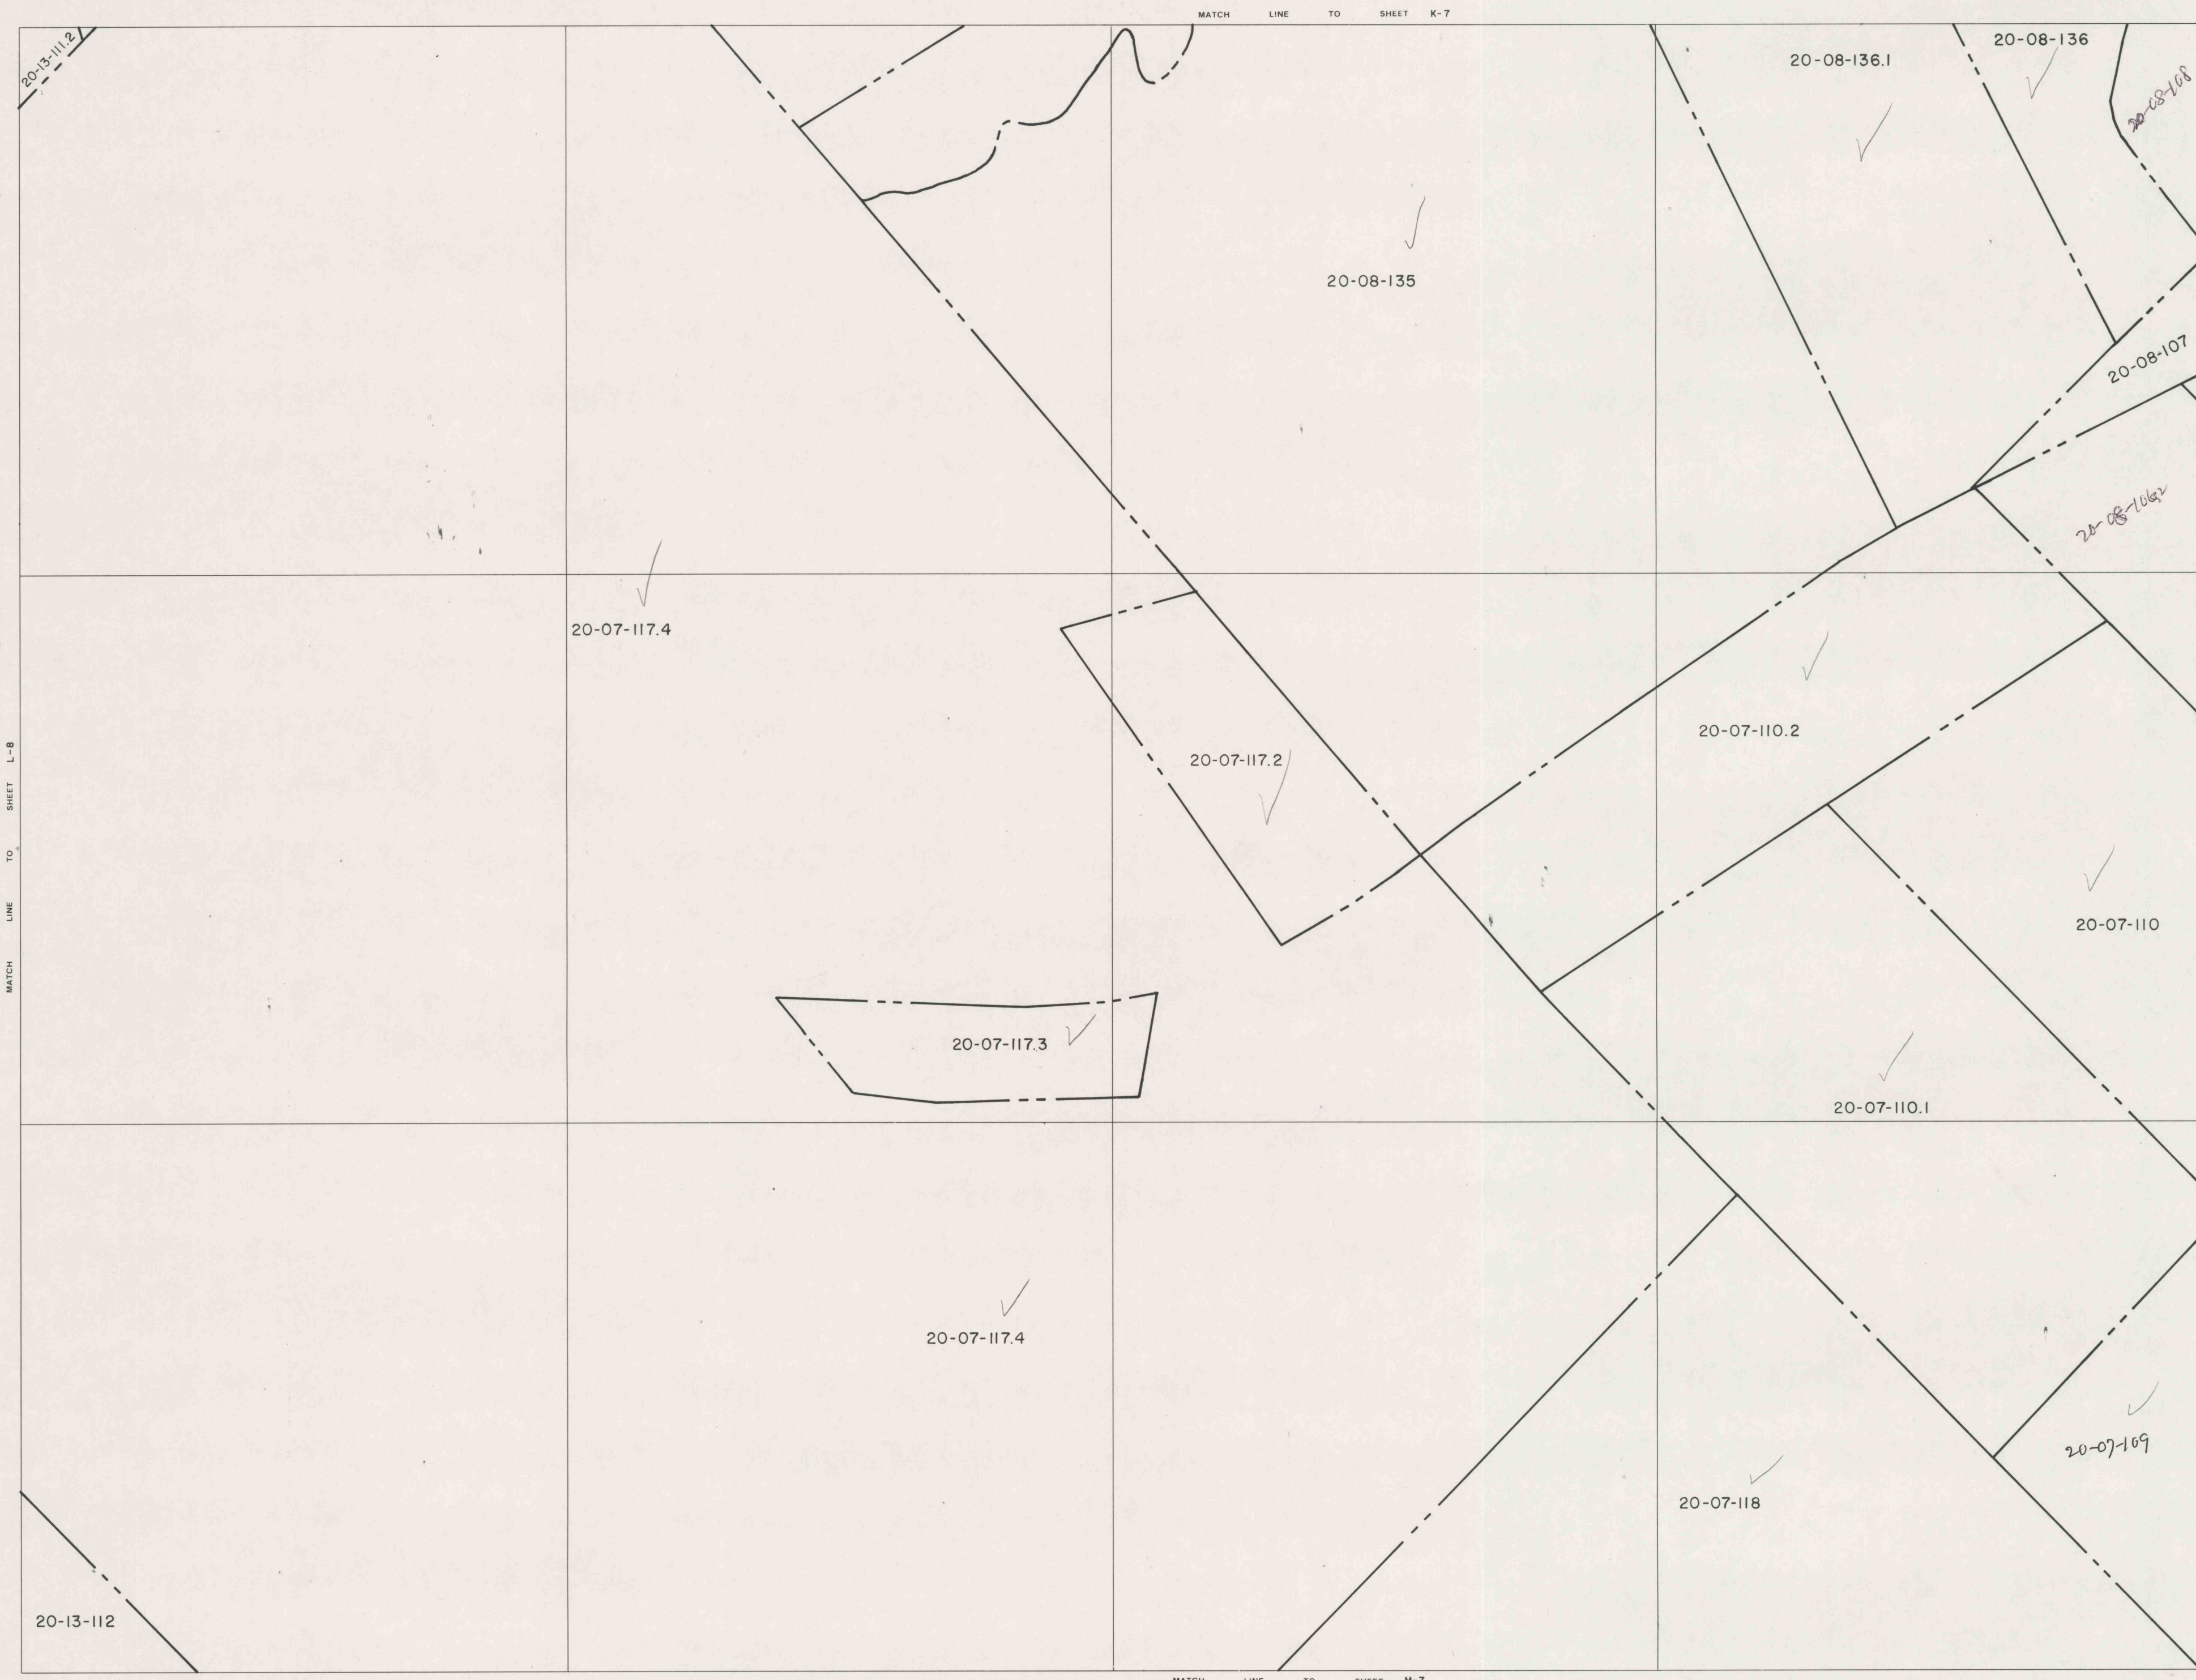

NOTE:
BOUNDARY LINES AND LOT DIMENSIONS WERE INTERPRETED
FROM AERIAL PHOTOGRAPHS, COUNTY TAX MAPS, AND EXISTING
COUNTY RECORDS. AT NO TIME WERE MEASUREMENTS VERIFIED
BY FIELD SURVEYS.



DER COAL MINING ACTIVITY PERMIT NO. 22840302

GREENWICH COLLIERIES
MINE NO. 1 U.S.B.M. No. 36-02405-0
MINE NO. 2 U.S.B.M. No. 36-02404-0
MAIN COMPLEX U.S.B.M. No. 36-05931
Location GREEN TWP., INDIANA CO., PA
Address Box 267, ERENSBURG, PA 15521

GREENWICH
SURFACE OWNERSHIP
SCALE 1" = 200' SHEET L-7
INDIANA & CAMBRIA COUNTIES

RECEIVED
DIVISION OF MINE
SUBSIDENCE REGULATION
DEC 13 1985
McMURRAY, PA