


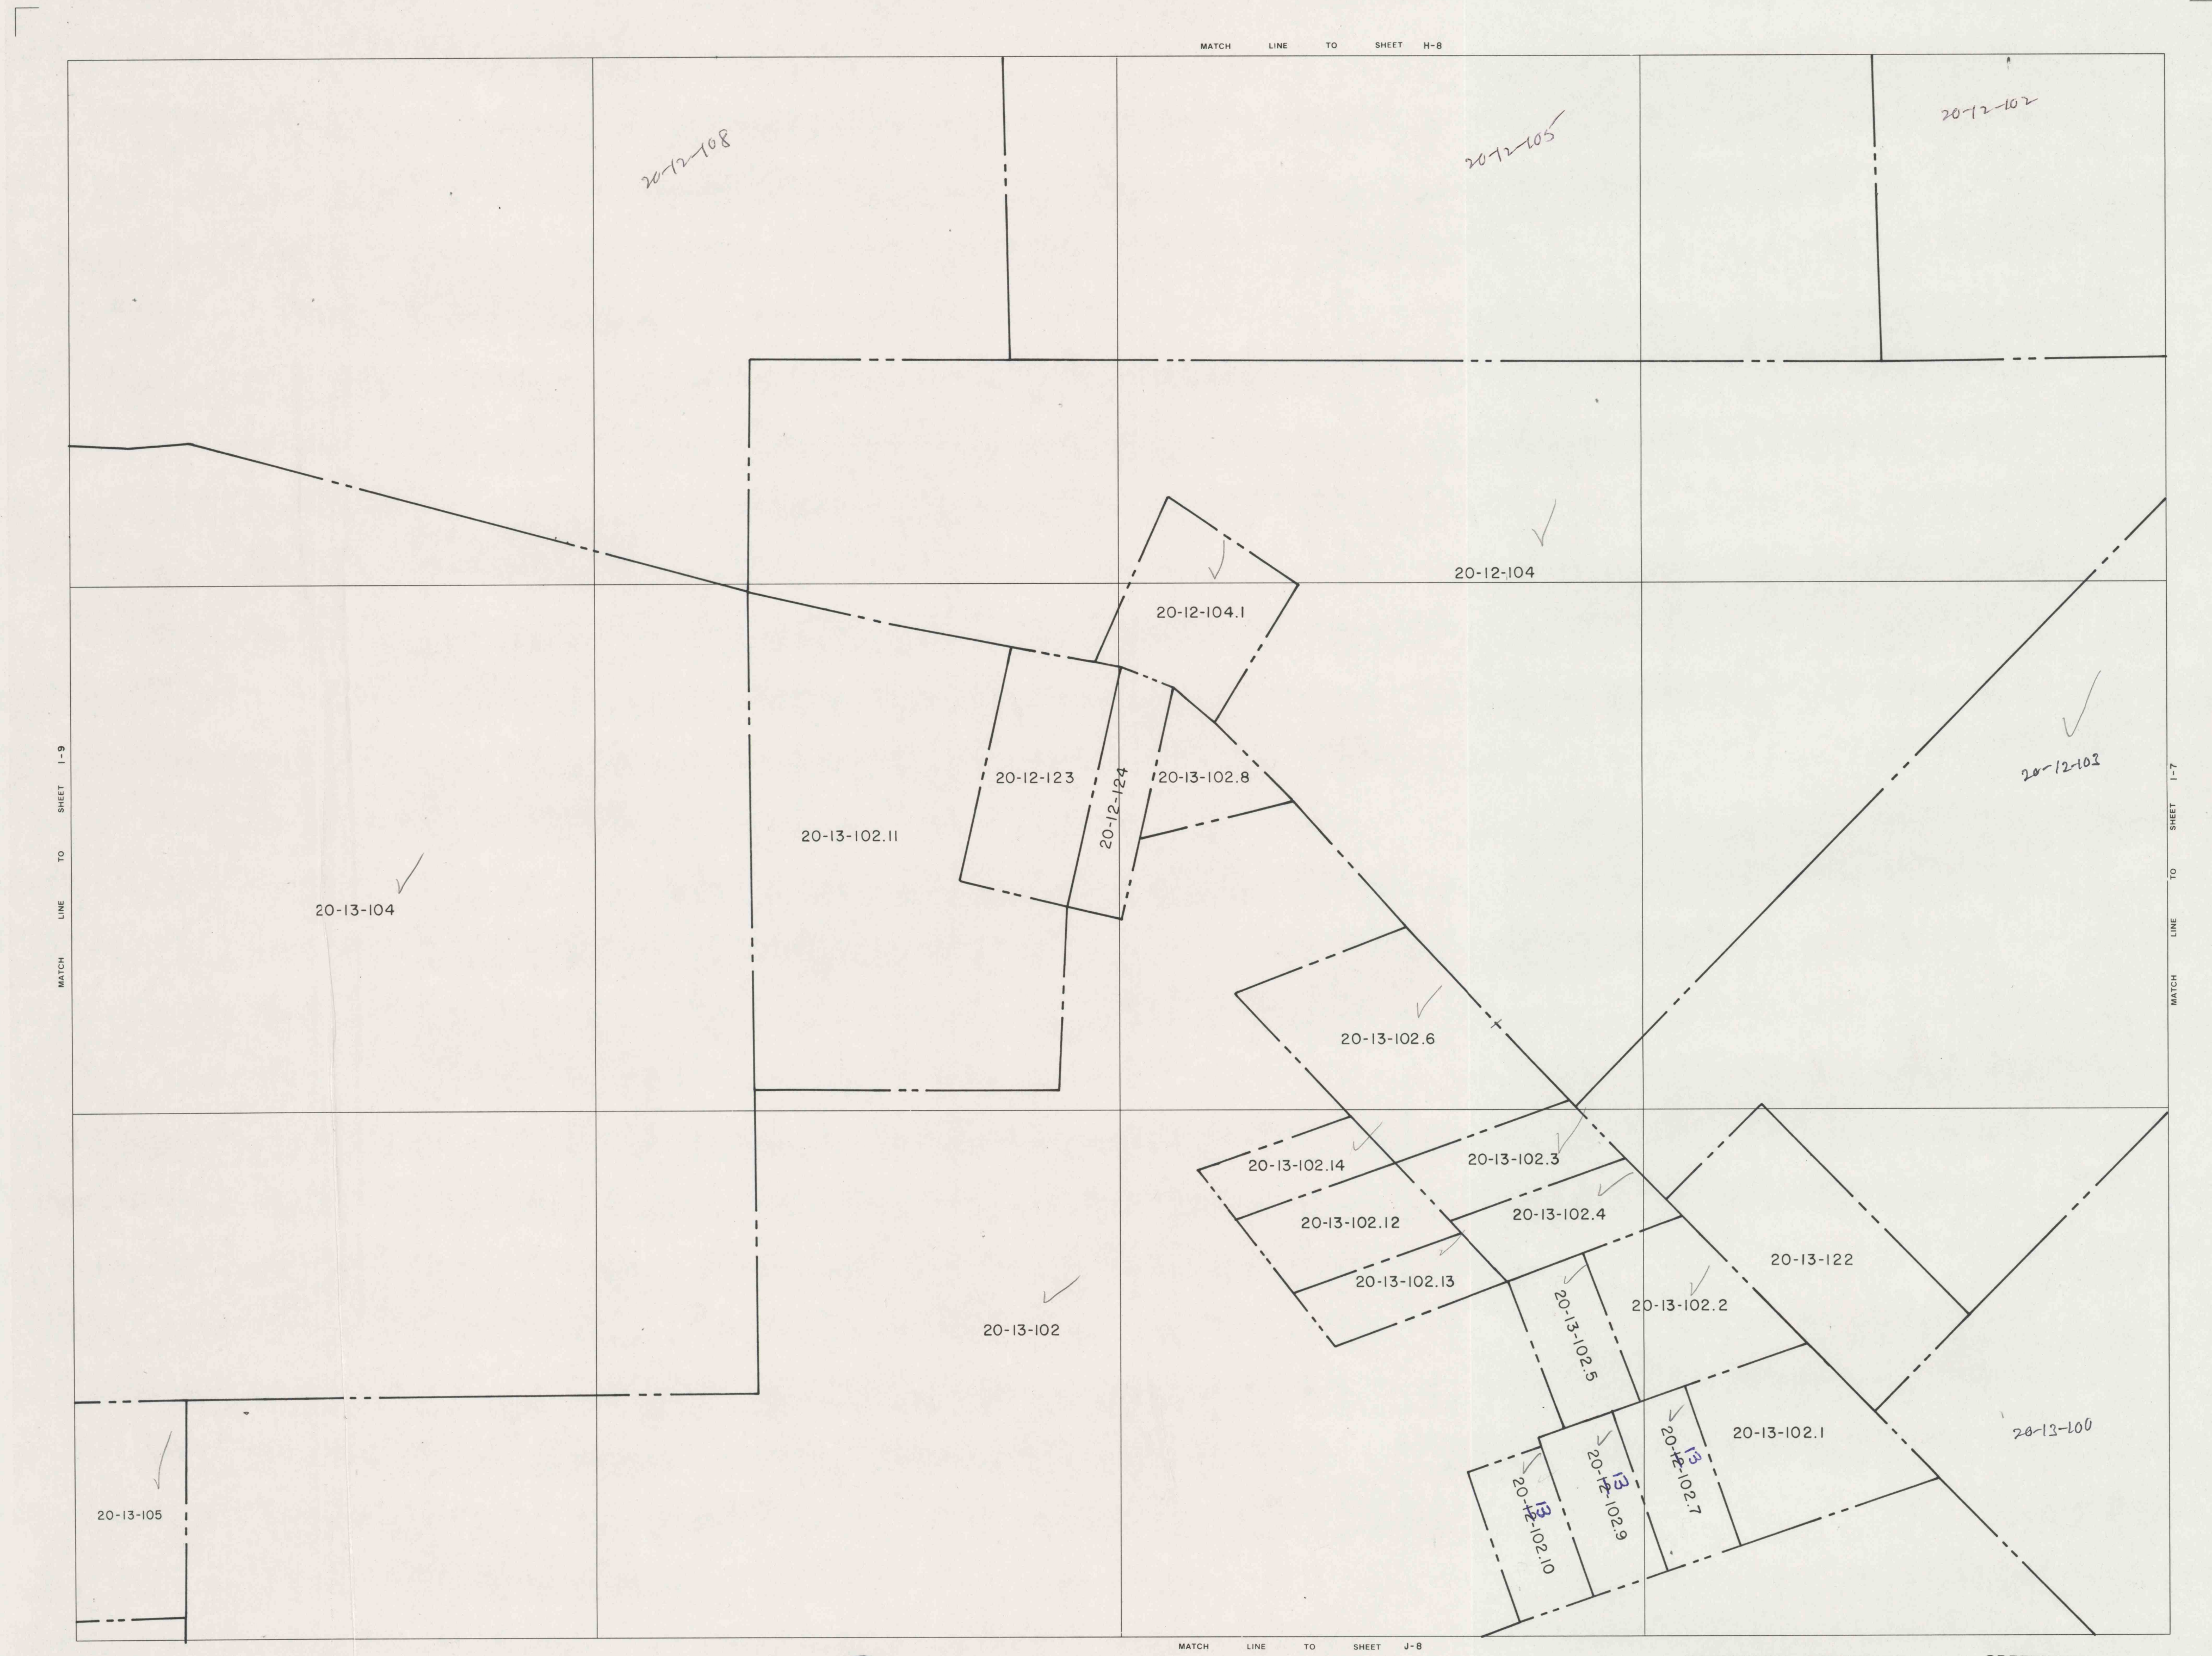

NOTE:
BOUNDARY LINES AND LOT DIMENSIONS WERE INTERPRETED
FROM AERIAL PHOTOGRAPHS, COUNTY TAX MAPS, AND EXISTING
COUNTY RECORDS. AT NO TIME WERE MEASUREMENTS VERIFIED
BY FIELD SURVEYS.



DER COAL MINING ACTIVITY PERMIT NO. 2284782

GREENWICH COLLIERIES
MINE NO. 1 U.S.B.M. No. 36-02405-0
MINE NO. 2 U.S.B.M. No. 36-02404-0
MAIN COMPLEX U.S.B.M. No. 36-05021
Location GREEN TWP., INDIANA CO., PA
Address Box 267, ERENSBURG, PA 15521

GREENWICH
SURFACE OWNERSHIP
SCALE 1" = 200'
INDIANA & CAMBRIA COUNTIES
SHEET 1-8

RECEIVED
DIVISION OF MINE
SUBSIDENCE REGISTRATION
DEC 13 1985
McMURRAY, PA