


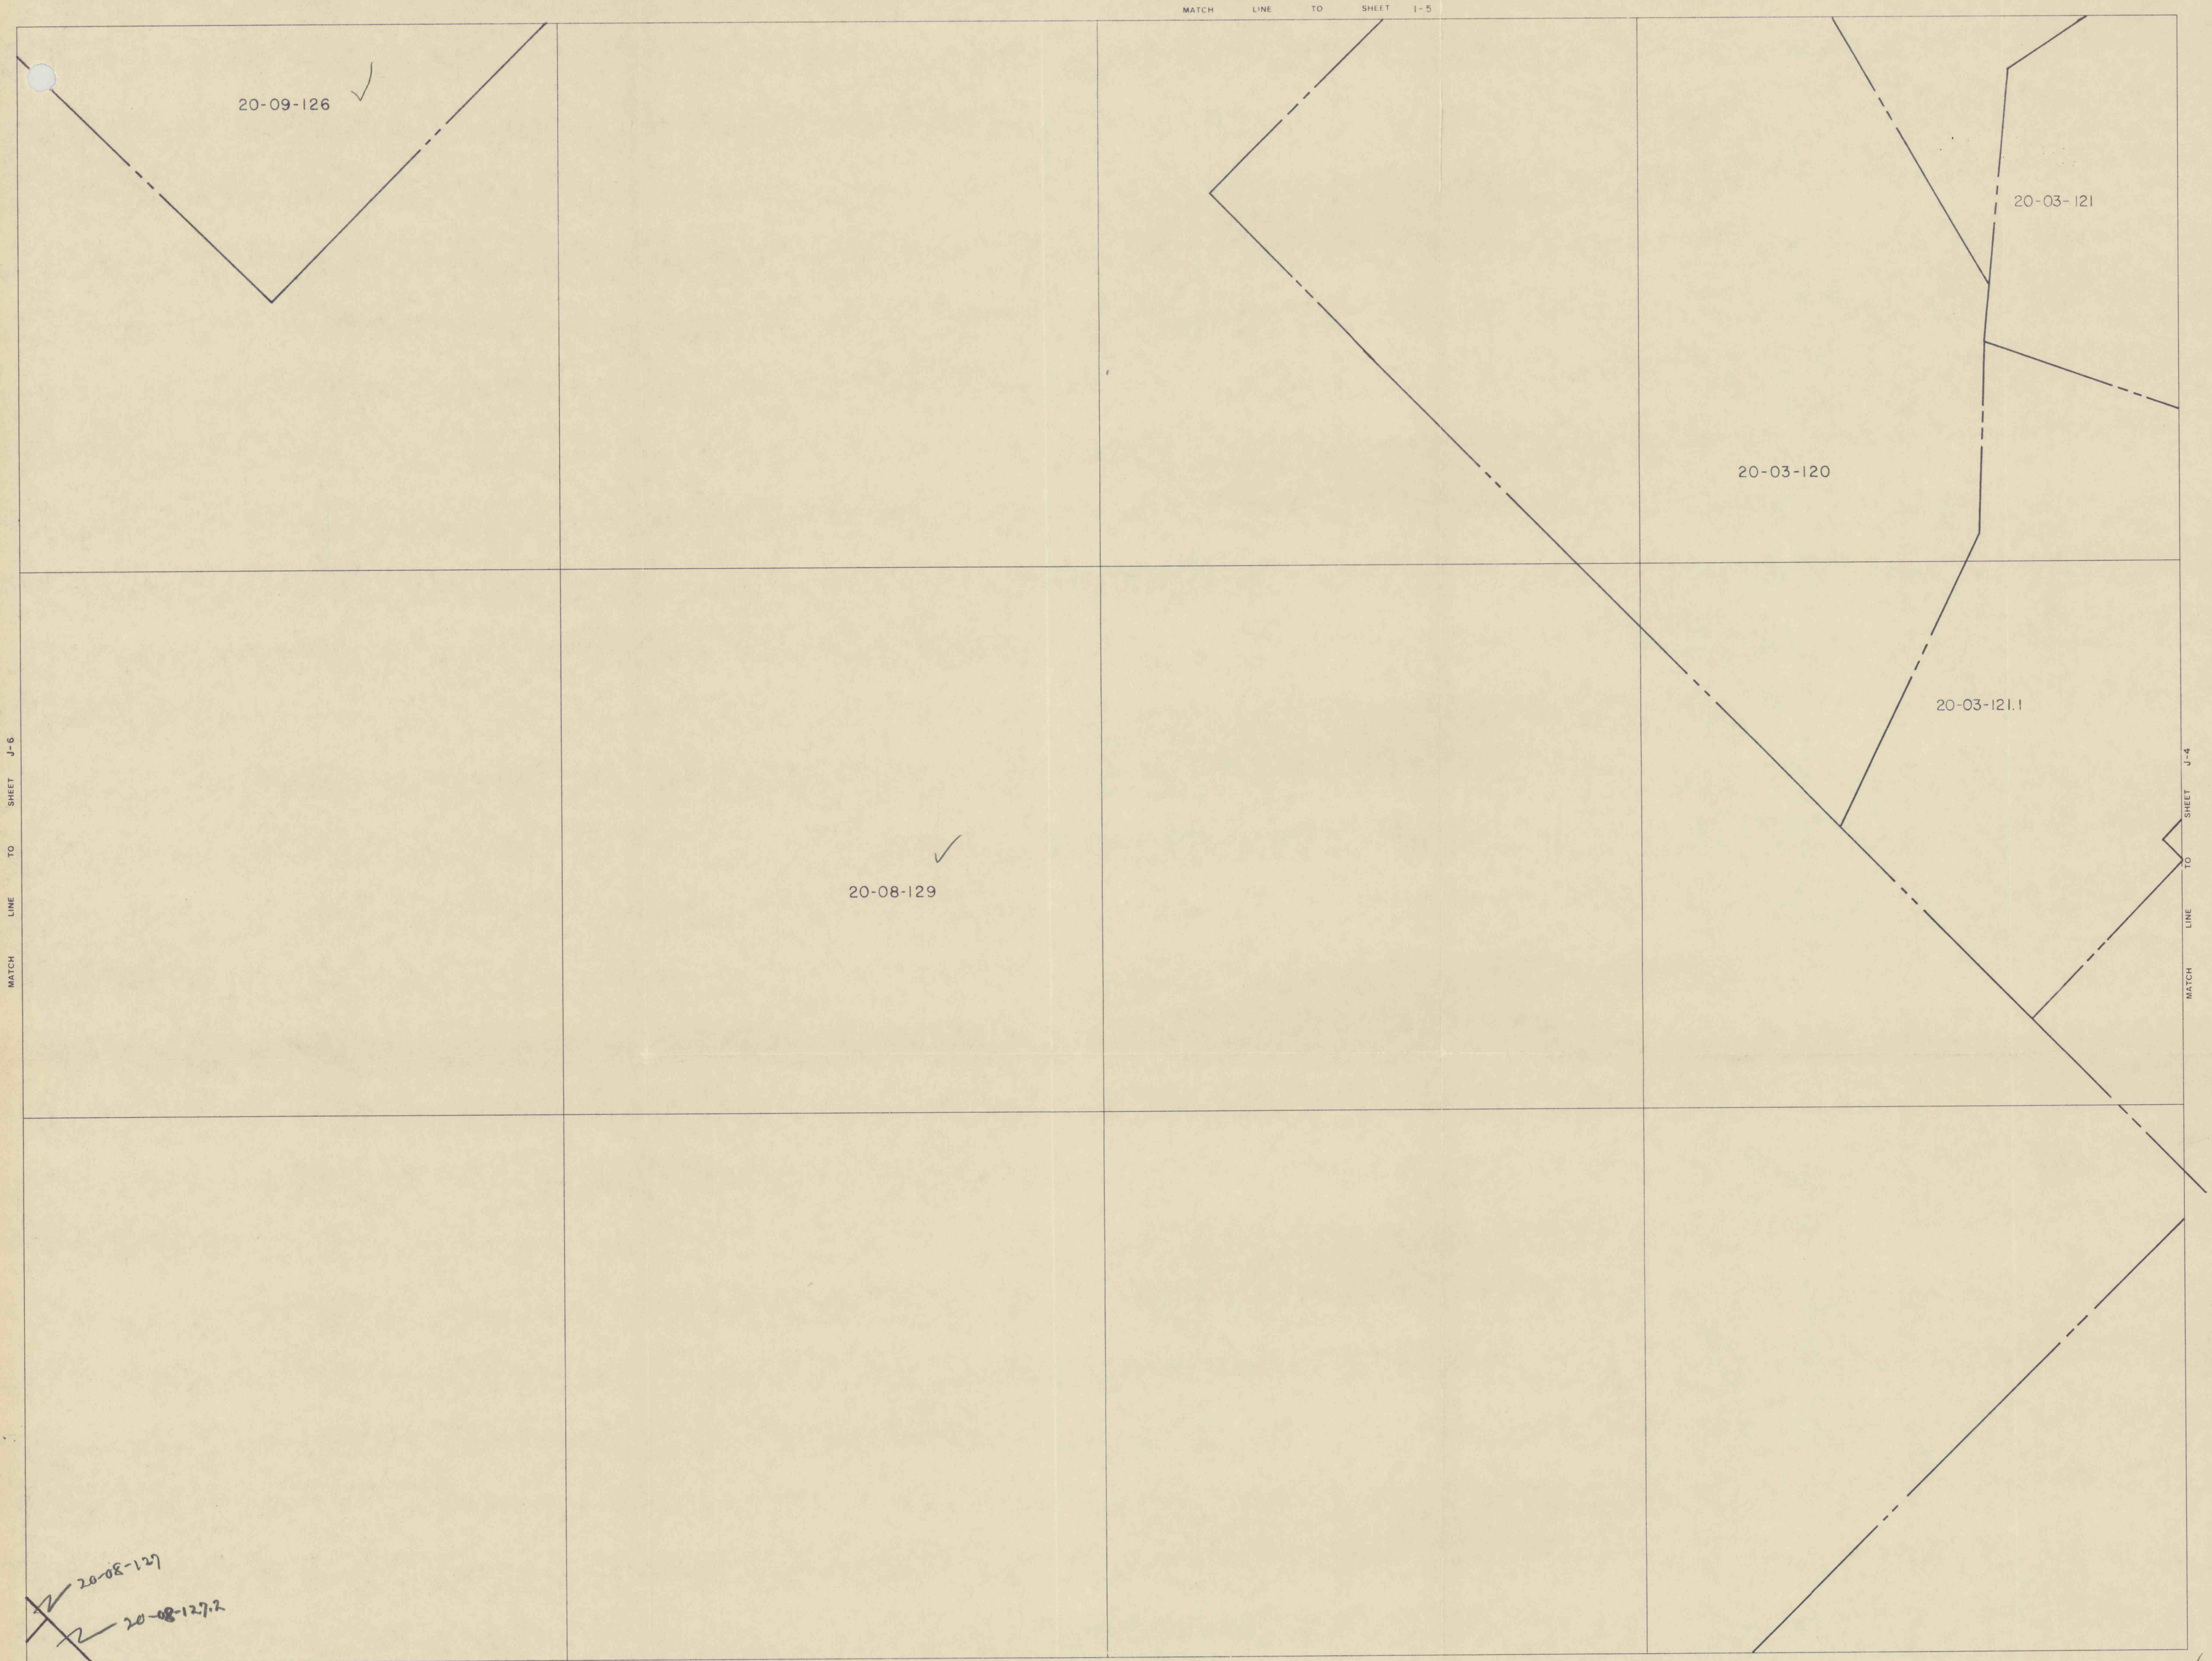

NOTE:
BOUNDARY LINES AND LOT DIMENSIONS WERE INTERPRETED
FROM AERIAL PHOTOGRAPHS, COUNTY TAX MAPS, AND EXISTING
COUNTY RECORDS. AT NO TIME WERE MEASUREMENTS VERIFIED
BY FIELD SURVEYS.



DER COAL MINING ACTIVITY PERMIT NO. 3244302

GREENWICH COLLIERIES
MINE NO. 1 U.S.B.M. No. 36-02405-0
MINE NO. 2 U.S.B.M. No. 36-02404-0
MAIN COMPLEX U.S.B.M. No. 36-05031
Location GREEN TWP., INDIANA CO., PA
Address Box 367, EBENSBURG, PA 15931

GREENWICH
SURFACE OWNERSHIP
SCALE: 1" = 200' SHEET J-5
INDIANA & CAMBRIA COUNTIES

RECEIVED
SEP 25 1989

Dept. of Environmental Resources
McMurray District Office

SEP 22 1989