


UNITED STATES  
DEPARTMENT OF THE INTERIOR  
GEOLOGICAL SURVEY

CLYMER QUADRANGLE  
PENNSYLVANIA-INDIANA CO.  
7.5 MINUTE SERIES (TOPOGRAPHIC)  
NE/4 INDIANA 15' QUADRANGLE

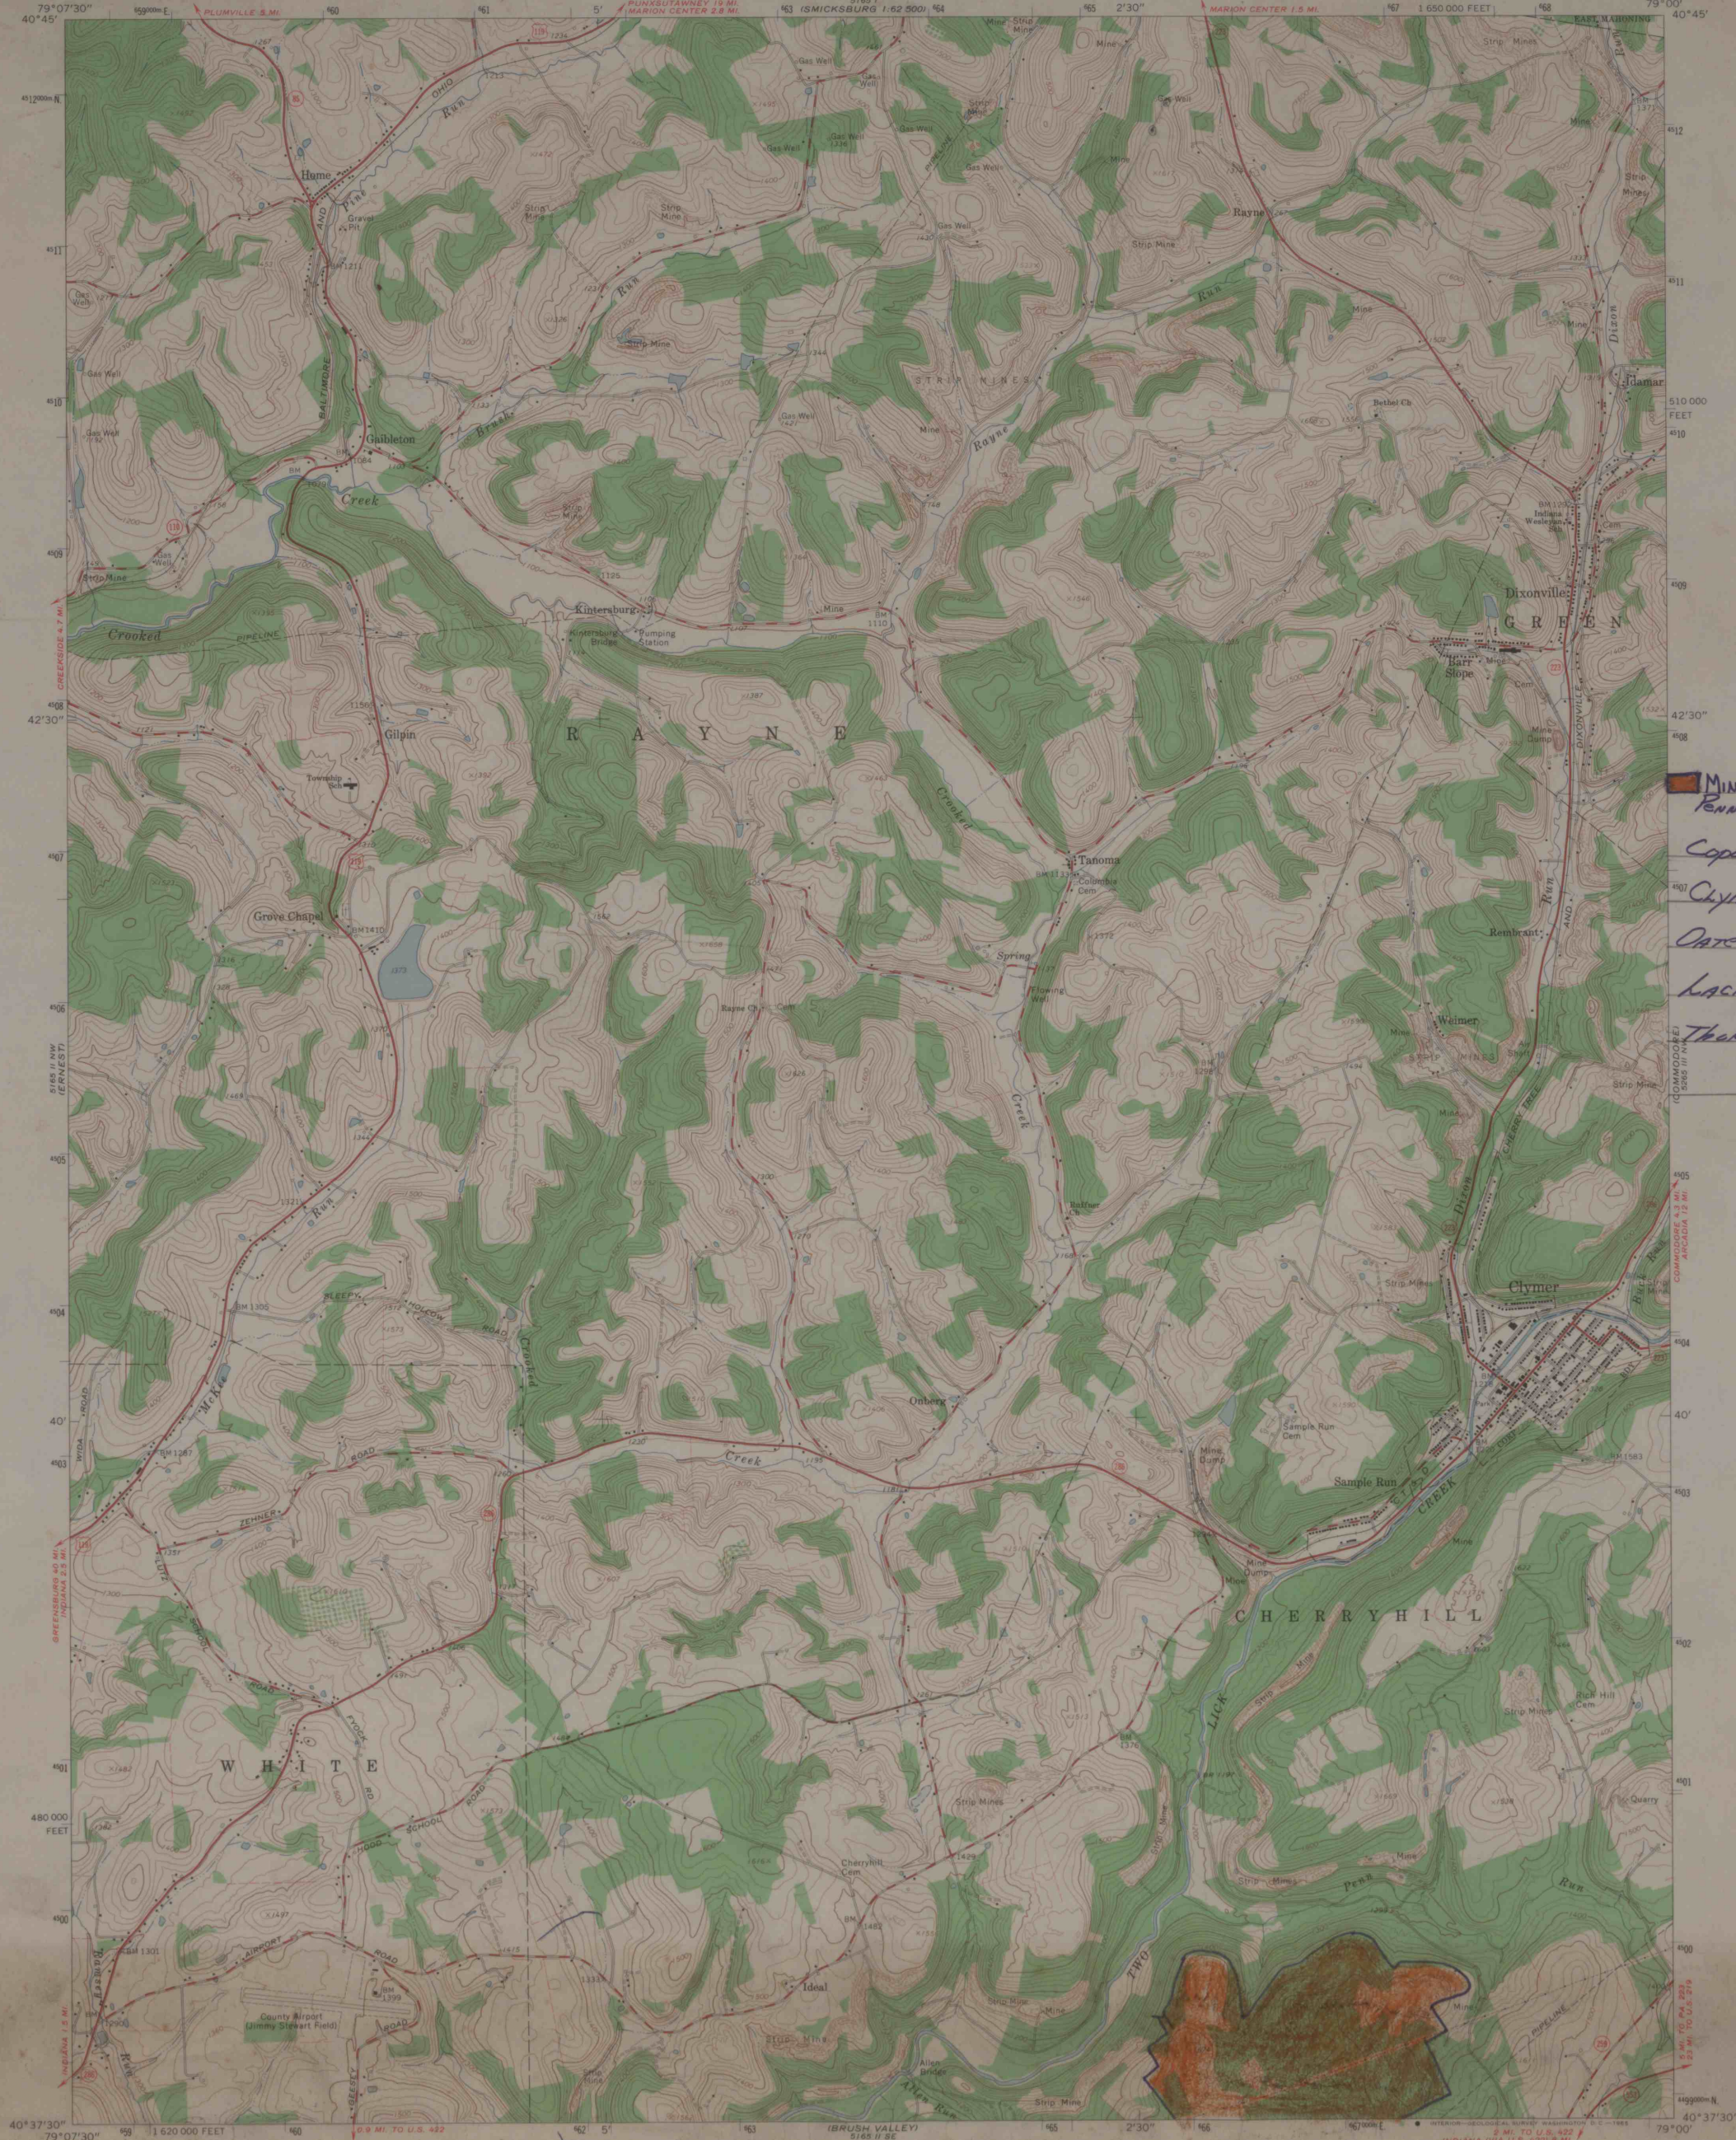

MINE BOUNDARY  
PENN HILL COAL  
CORPORATION  
CLYMER, PENN.  
DATE-6-30-71  
LOCATED BY  
THOMAS HOSCH

Mapped, edited, and published by the Geological Survey

Control by USGS and USC&GS

Topography by photogrammetric methods from aerial

photographs taken 1961. Field checked 1963

Polyconic projection. 1927 North American datum



10,000-foot grid based on Pennsylvania coordinate system, south zone

1000-meter Universal Transverse Mercator grid ticks,

zone 17, shown in blue

Fine red dashed lines indicate selected fence and field lines where

generally visible on aerial photographs. This information is unchecked

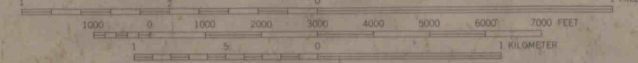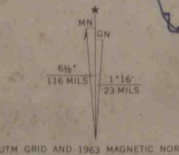

CONTOUR INTERVAL 20 FEET  
DATUM IS MEAN SEA LEVEL


THIS MAP COMPLIES WITH NATIONAL MAP ACCURACY STANDARDS  
FOR SALE BY U.S. GEOLOGICAL SURVEY, WASHINGTON 25, D. C.  
A FOLDER DESCRIBING TOPOGRAPHIC MAPS AND SYMBOLS IS AVAILABLE ON REQUEST

ROAD CLASSIFICATION

Heavy duty Light duty

Medium duty Unimproved dirt

U.S. Route State Route

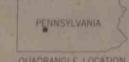

CLYMER, PA.

NE/4 INDIANA 15' QUADRANGLE

N4037.5-W7900.7.5

1963

AMS 5165 II NE-SERIES V851

INAPS #  
20127