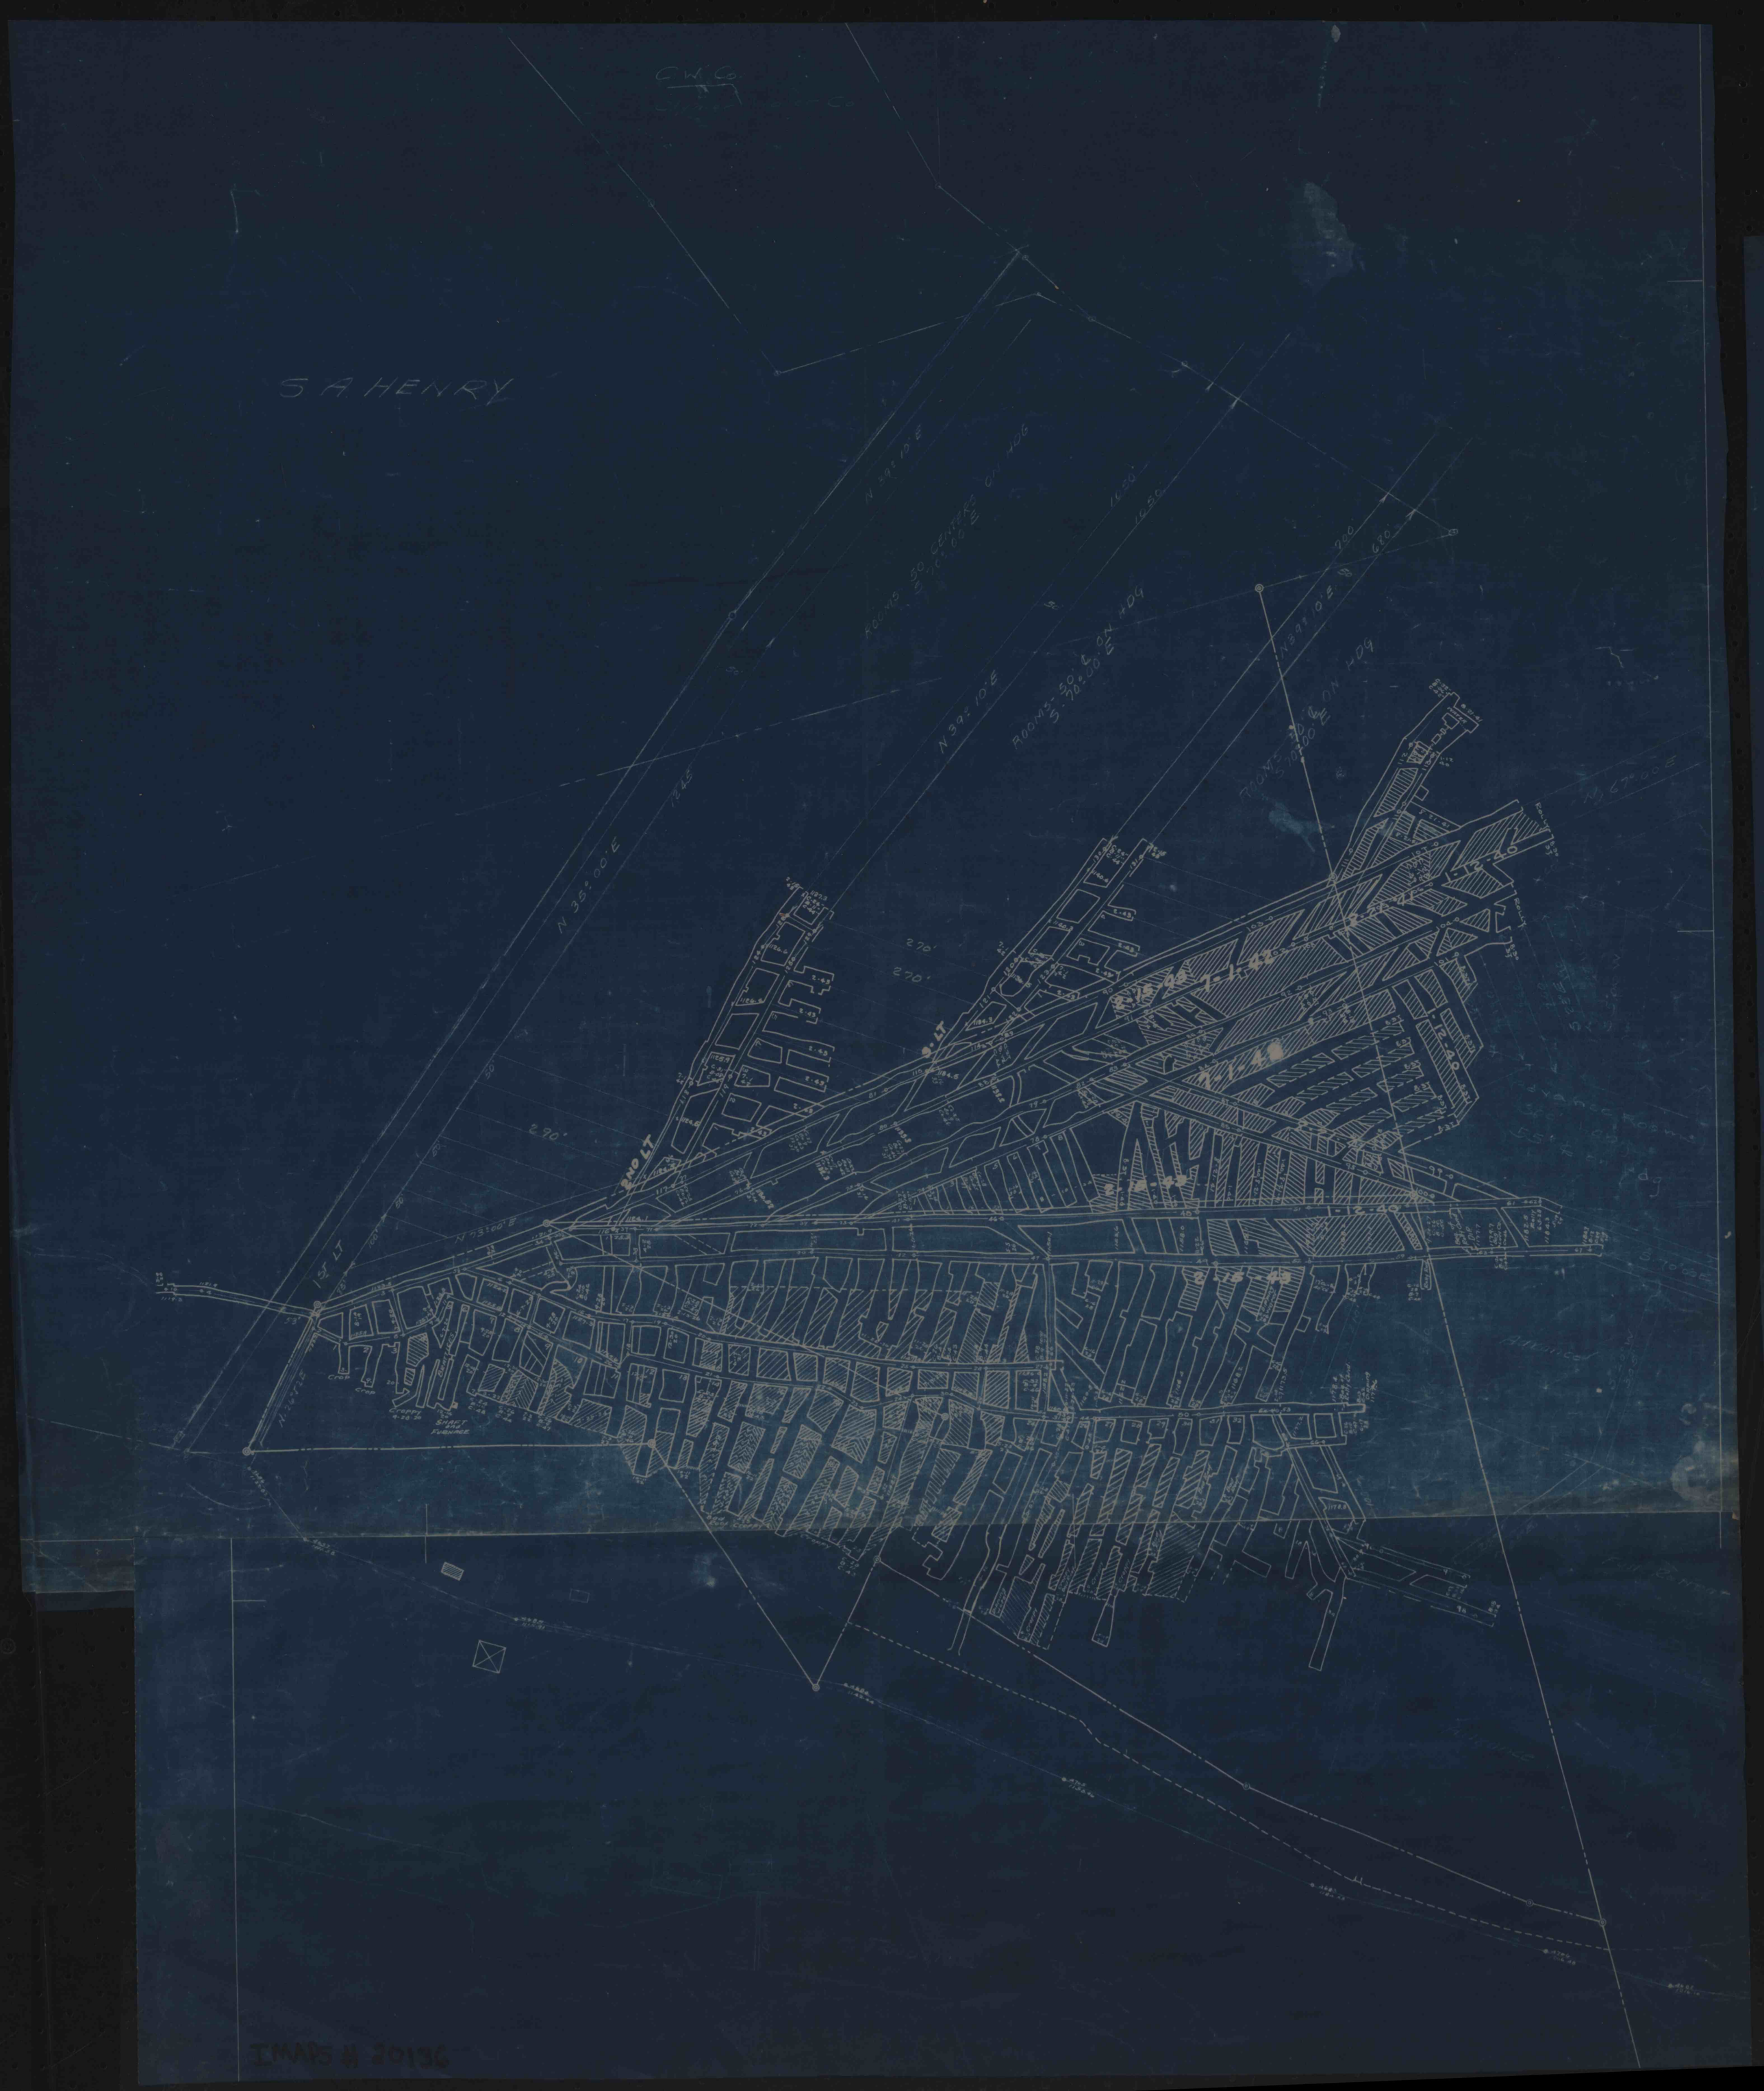
S A HENRY
N 39° 10' E
ROOMS 50 CENTERS ON HDG
S 70° 00' E
1050'
1050'
N 39° 10' E
700
680'
ROOMS 50' CENTERS ON HDG
S 70° 00' E
N 35° 00' E
1245
270'
270'
290'
9 LT
2ND LT
1ST LT
N 35° 00' E
N 67° 00' E
Crop
Crop
Crop