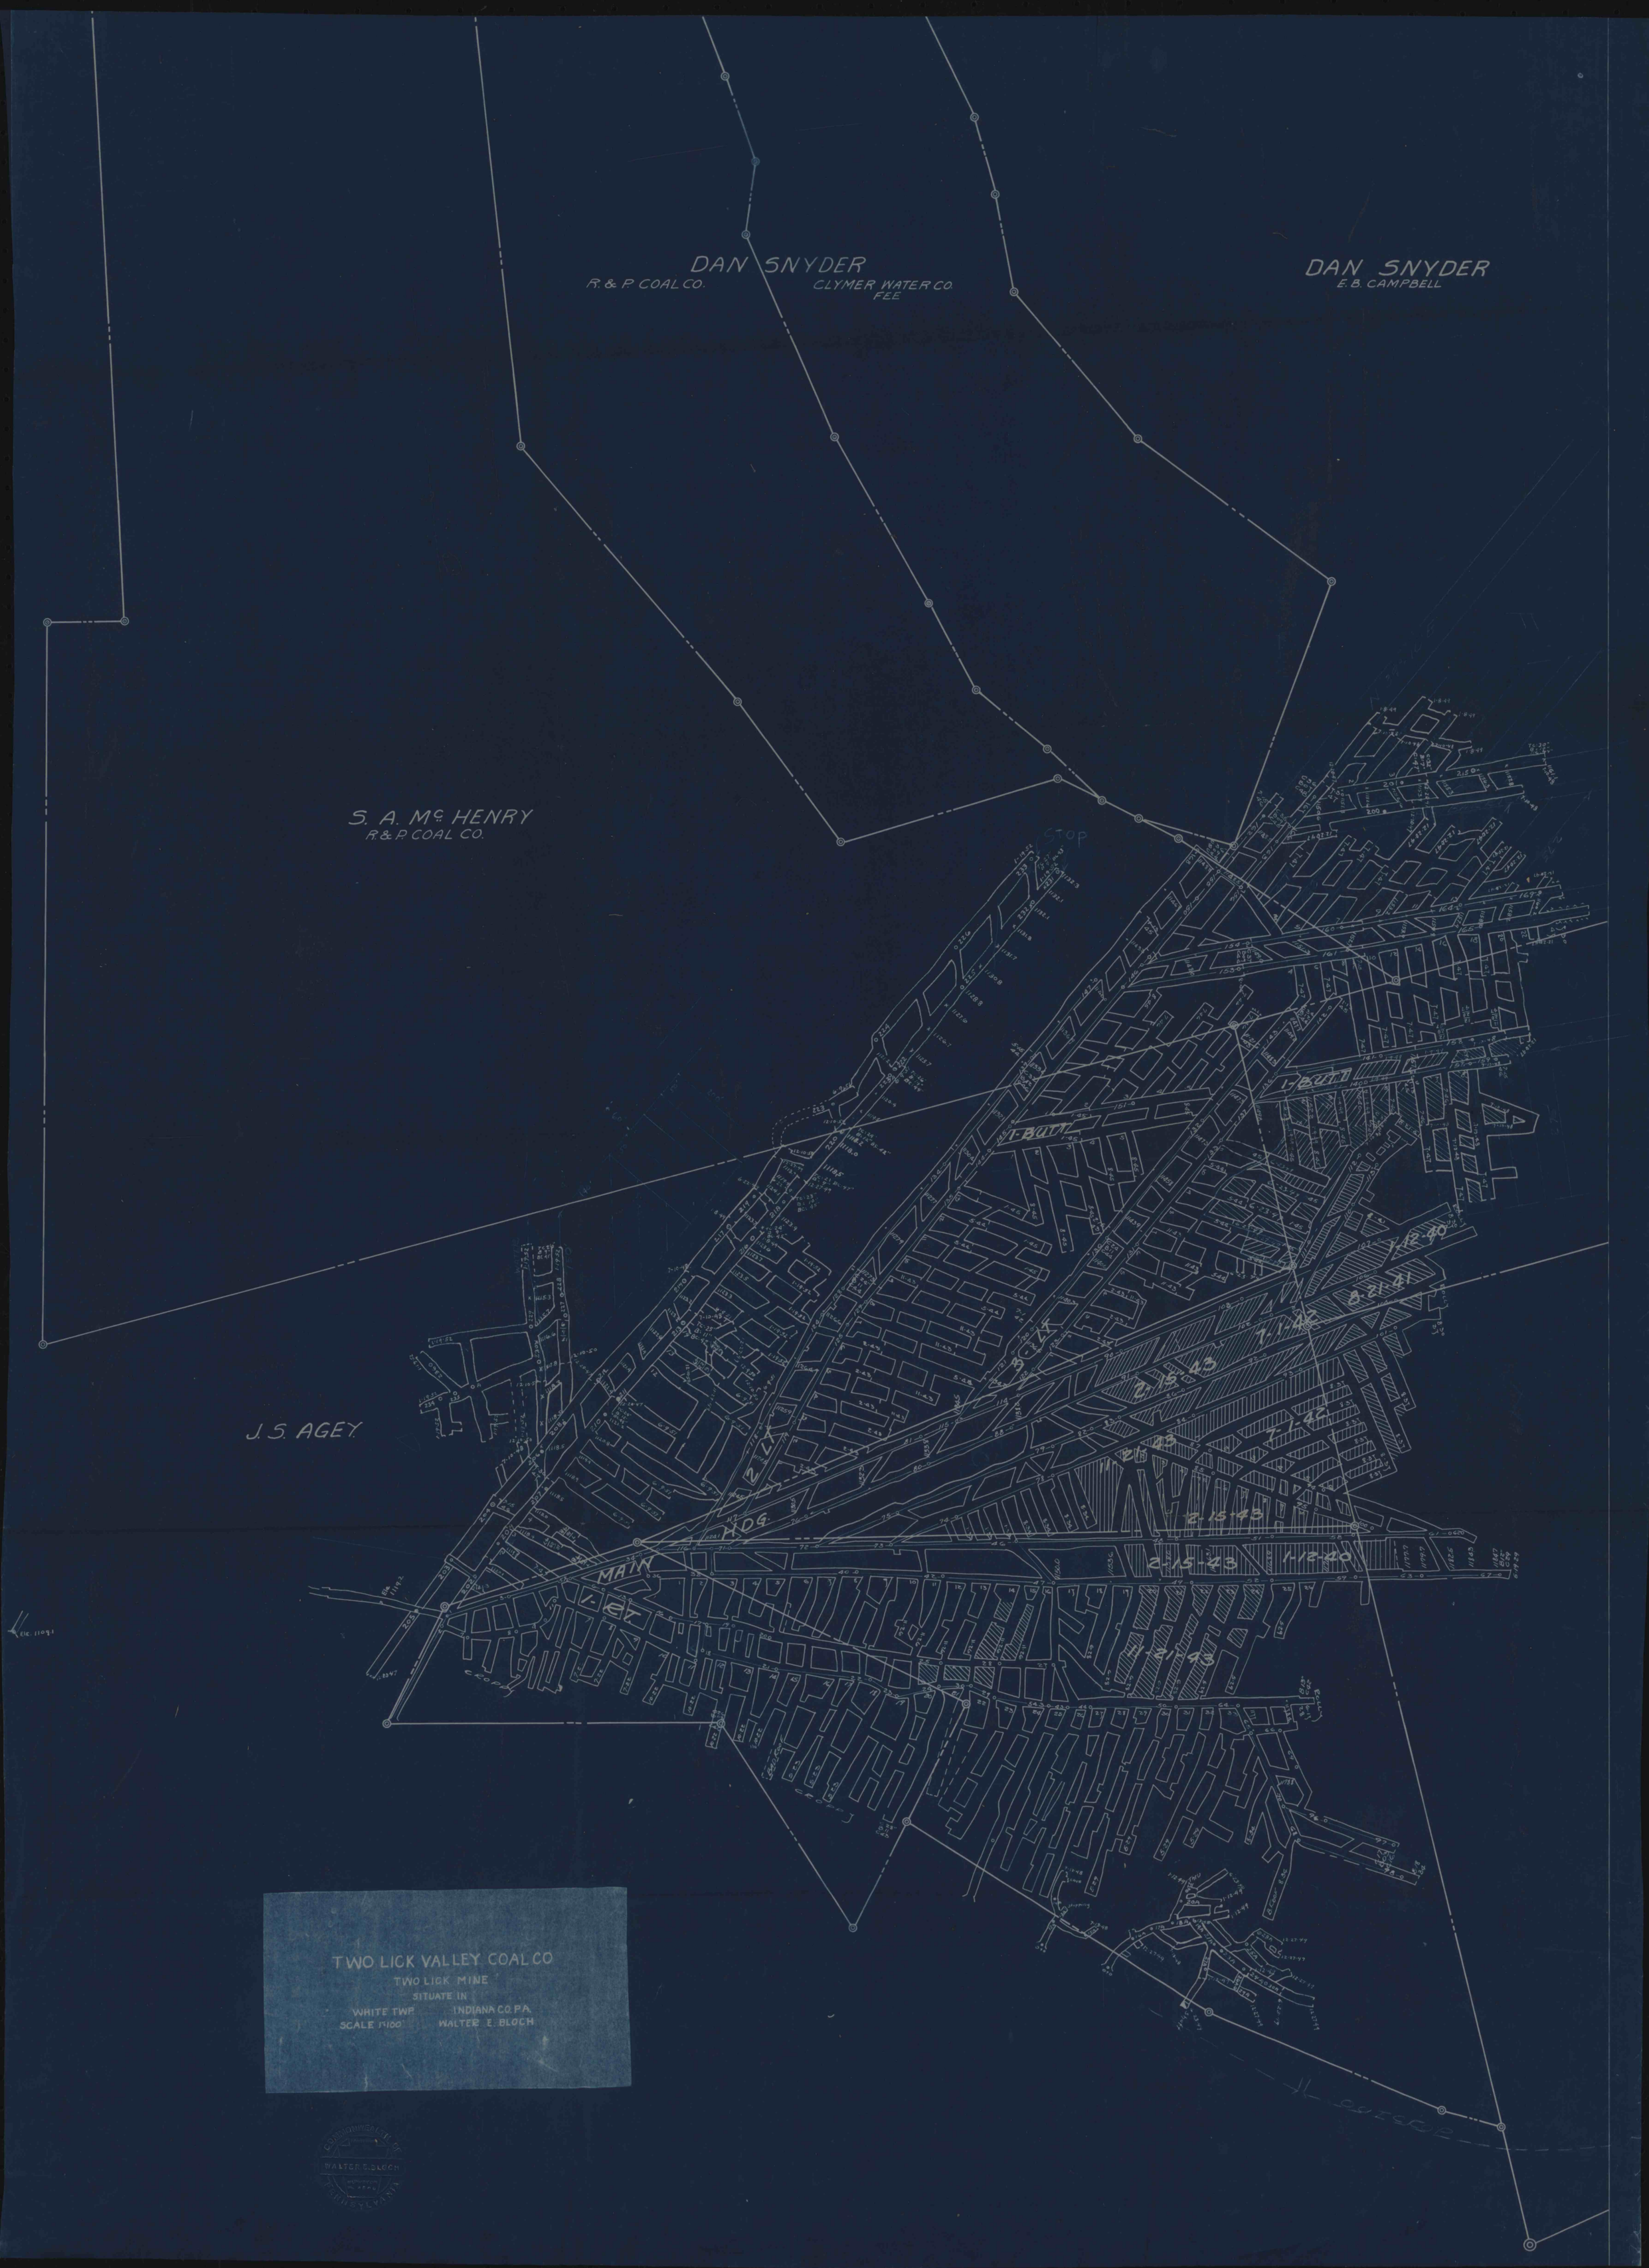
DAN SNYDER
R. & P. COAL CO.
CLYMER WATER CO.
FEE
DAN SNYDER
E. B. CAMPBELL
S. A. Mc HENRY
R. & P. COAL CO.
J. S. AGEY
STOP
1-BUTT
MAIN
HDG.
2-LIFT
1-ENT
2-15-43
1-12-40
1-21-43
2-21-43
1-12-40
TWO LICK VALLEY COAL CO
TWO LICK MINE
SITUATE IN
WHITE TWP. INDIANA CO. PA.
SCALE 1"=100' WALTER E. BLOCH