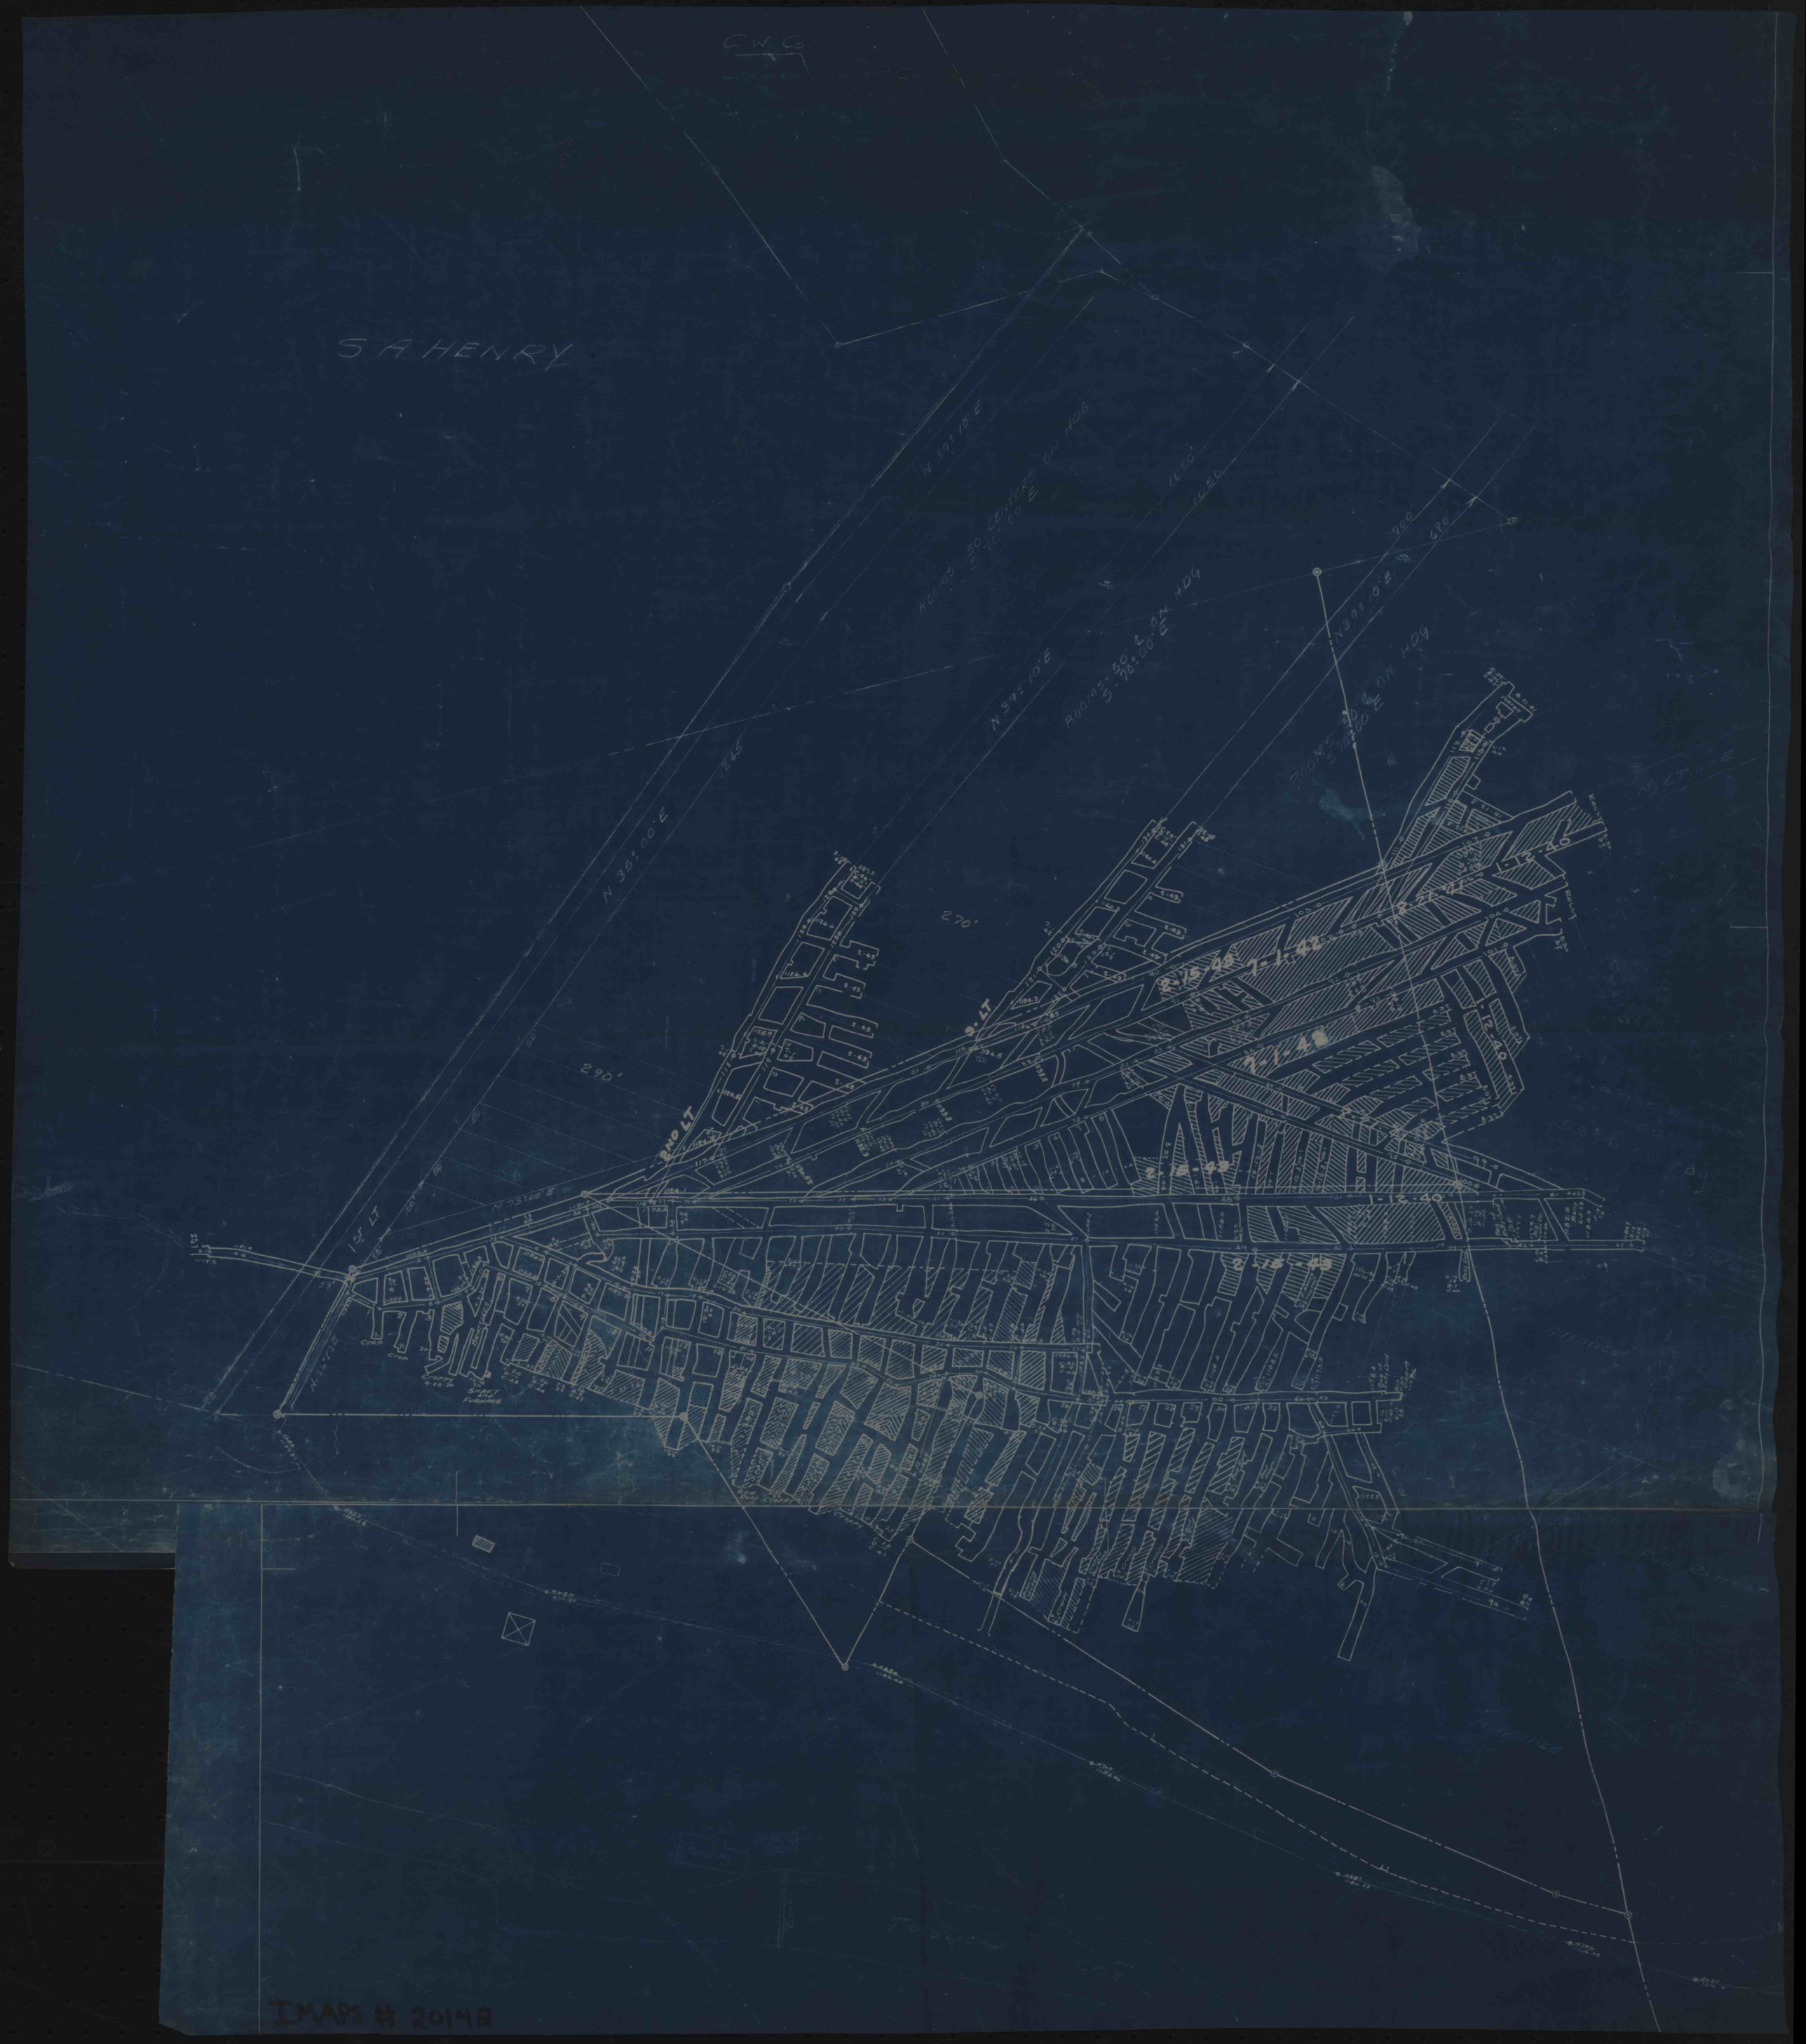
S.A. HENRY
N 39° 10' E
N 35° 00' E
N 67° 00' E
1245
270'
290'
1650
1050
900
630
1-12-40
2-15-49
1-1-42
2-15-43
1ST LT
2ND LT
3RD LT
Crop
Crop
Crop
SHAFT
SHAFT
FURNACE

IMAPS # 20148