

Formerly W. S. Wetzel

Township Road No. 557




HOWARD WETZEL
TRACK

Township Road No. 626

KESLAR

Lower Freepit Coal
STRIP Mined
1958 - 1959

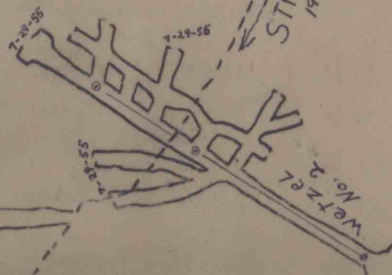

WM. KRAMP

Wetzel Mine No. 3	
Rayne Township Indiana, Co.	
Operator: Stear, Fetsko, Wetzel	
Marion Center, Penna.	
SCALE 1"=100' Dec. 20 1961	

h198 # 26144