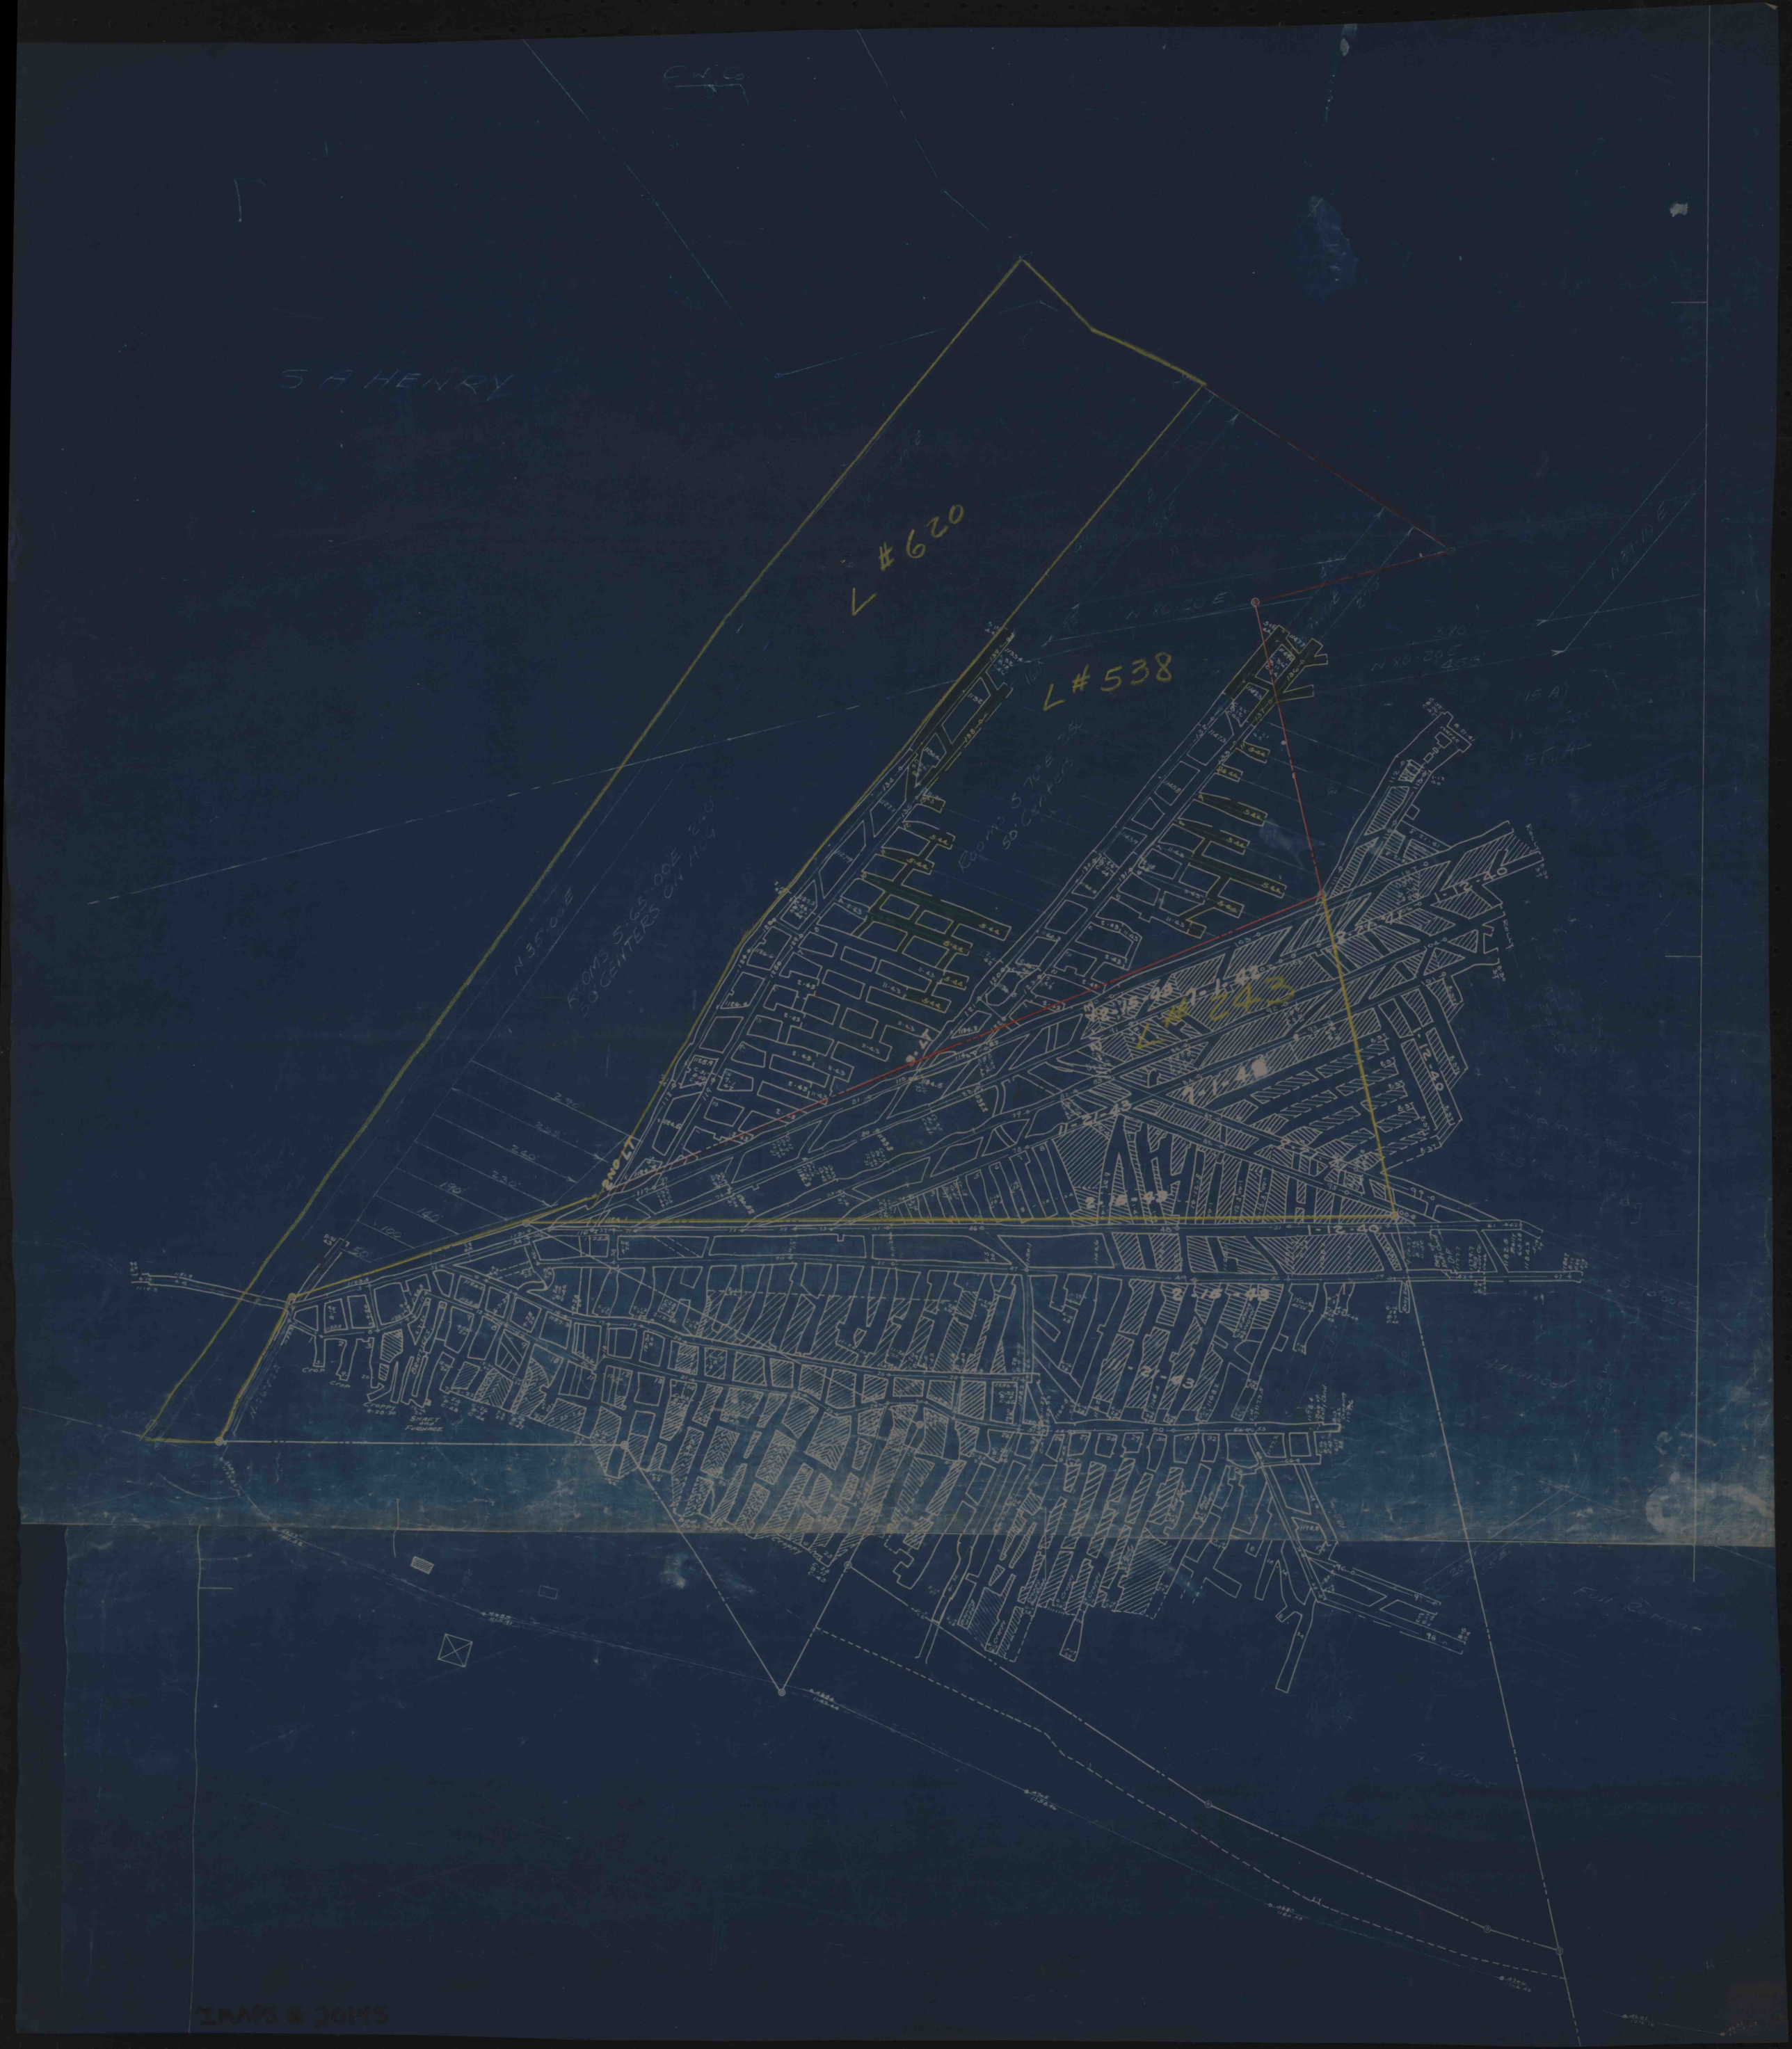
S A HENRY
L #620
#538
N 35°-00 E
ROOMS 5-65'-00 E 220
50 CENTERS ON HIGH
ROOMS 5 70 E 238
50' CENTERS
N 10-20 E
N 10-20 E
2ND LT
CROP
CROP
SHAFT AND FURNACE
FULL BRIDGE

