


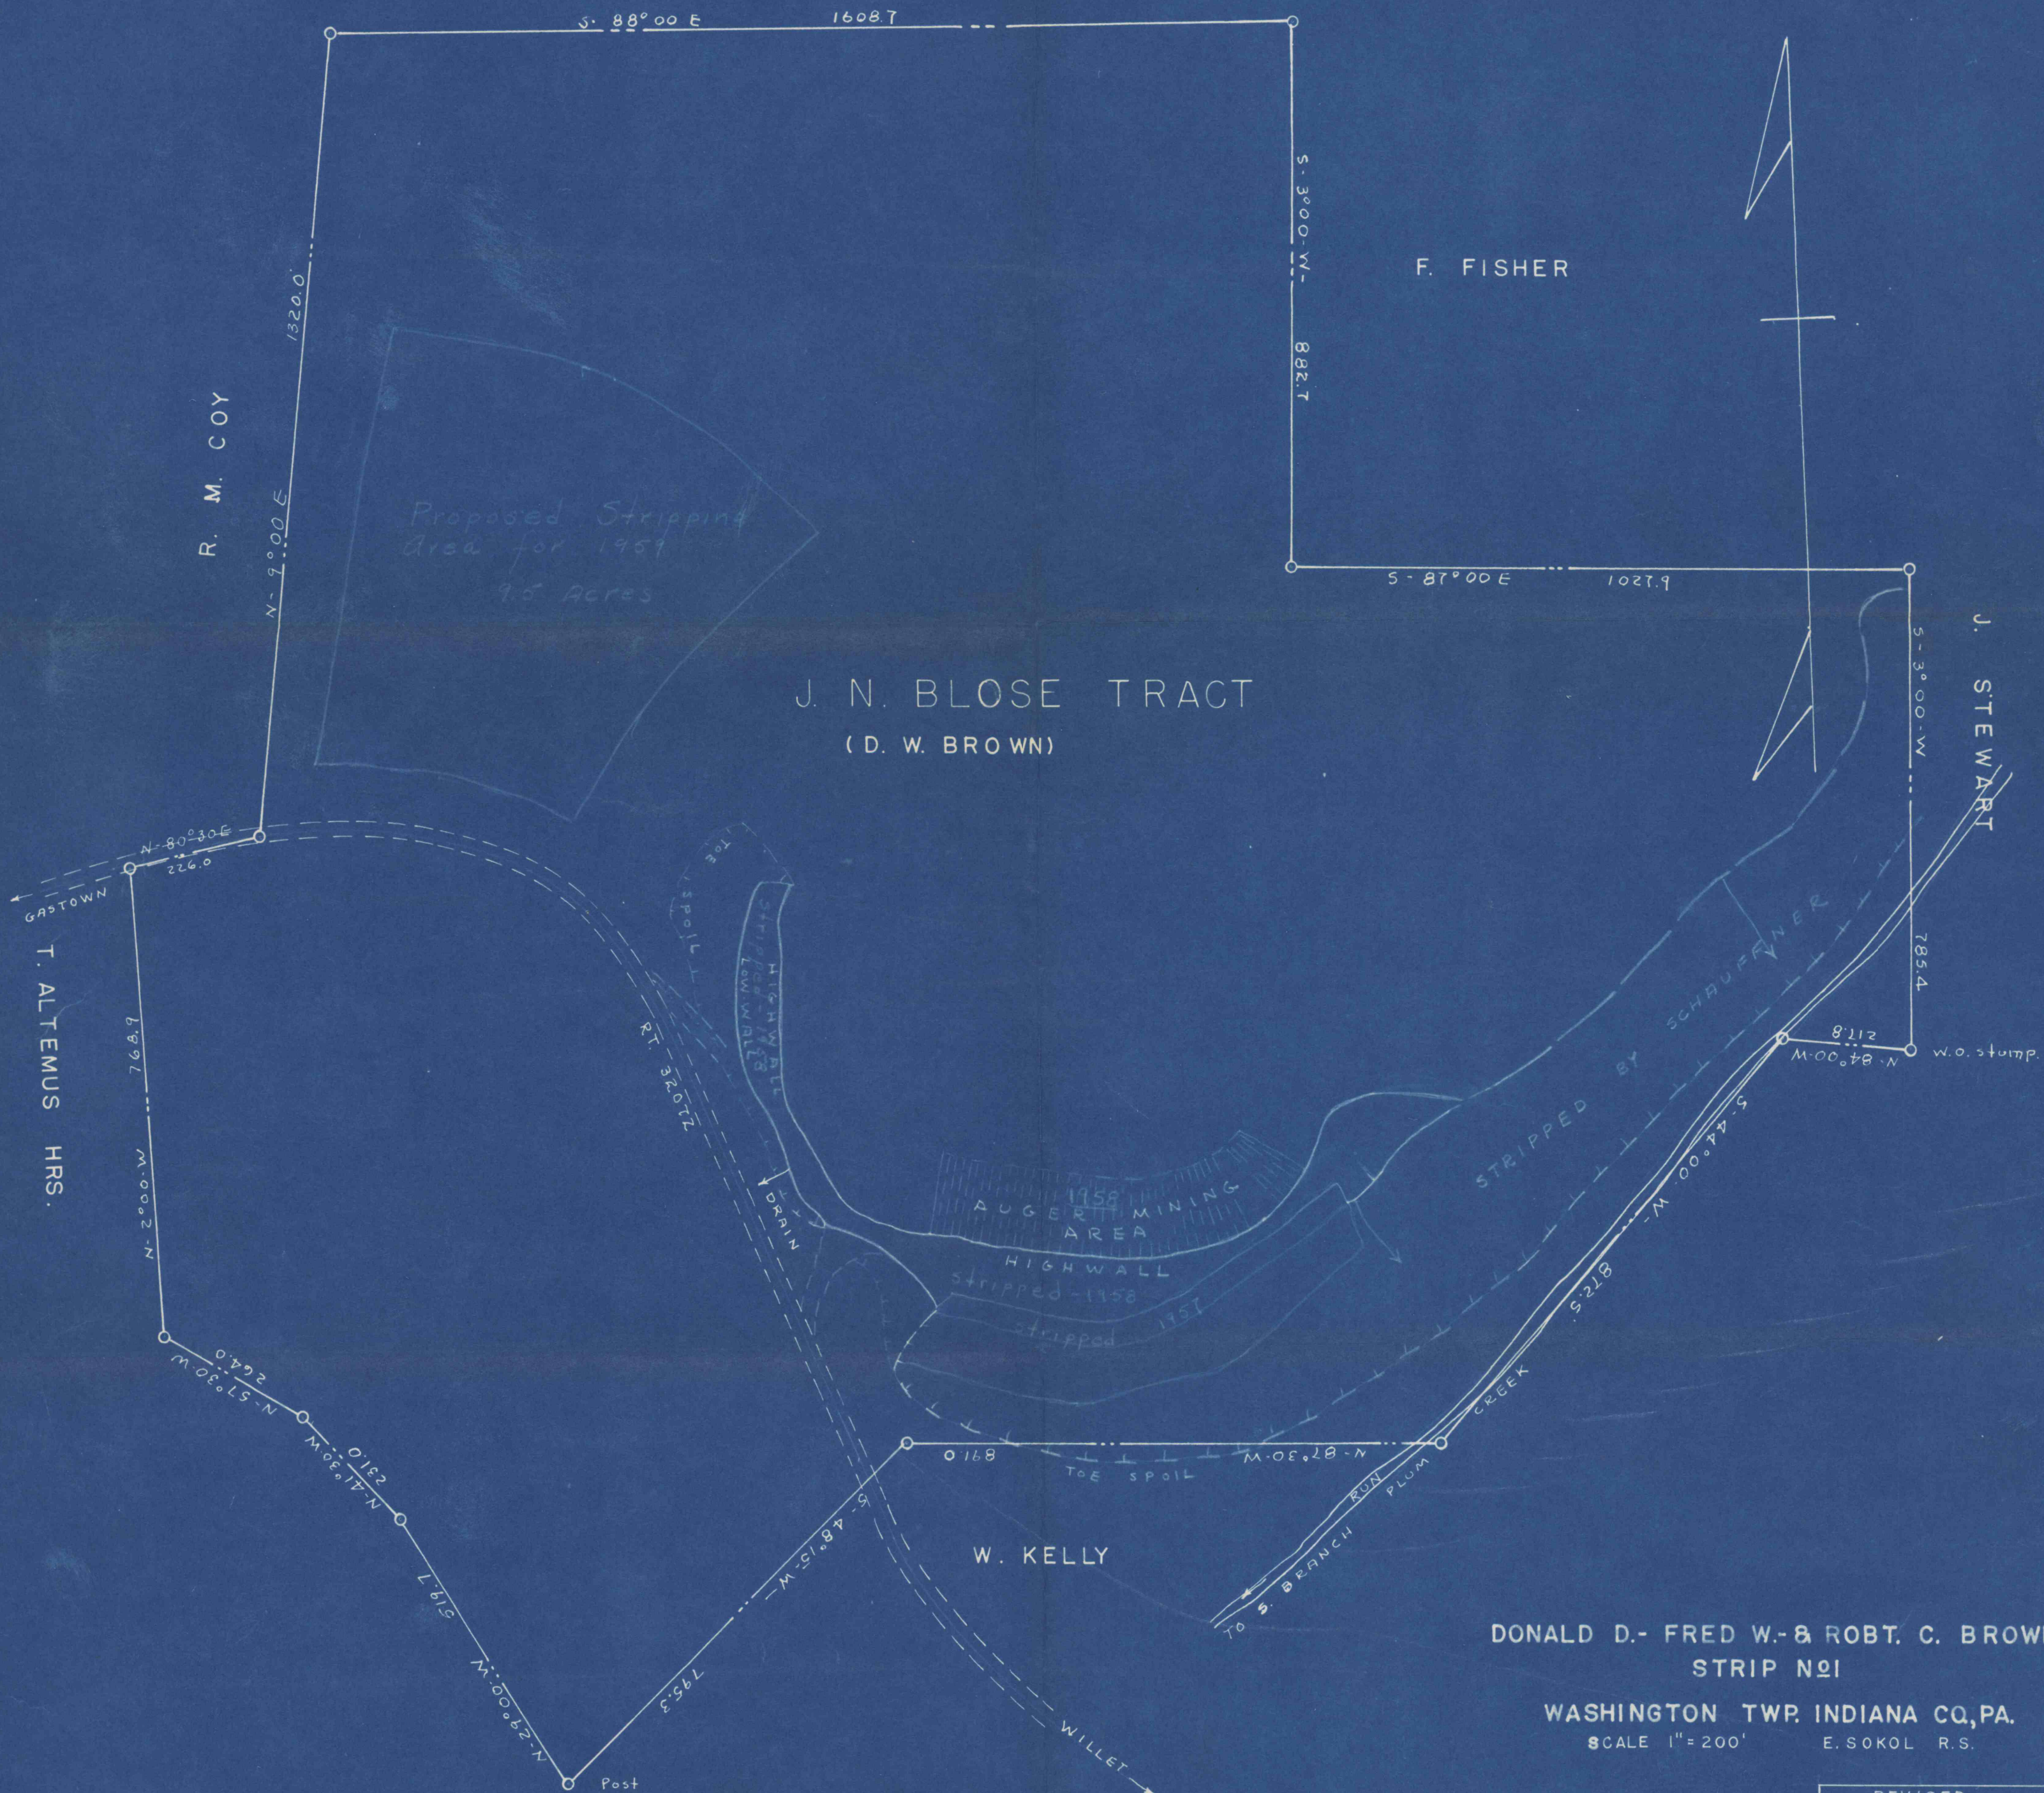

REVISED	
SEPT-1958	

IMAPS#20146