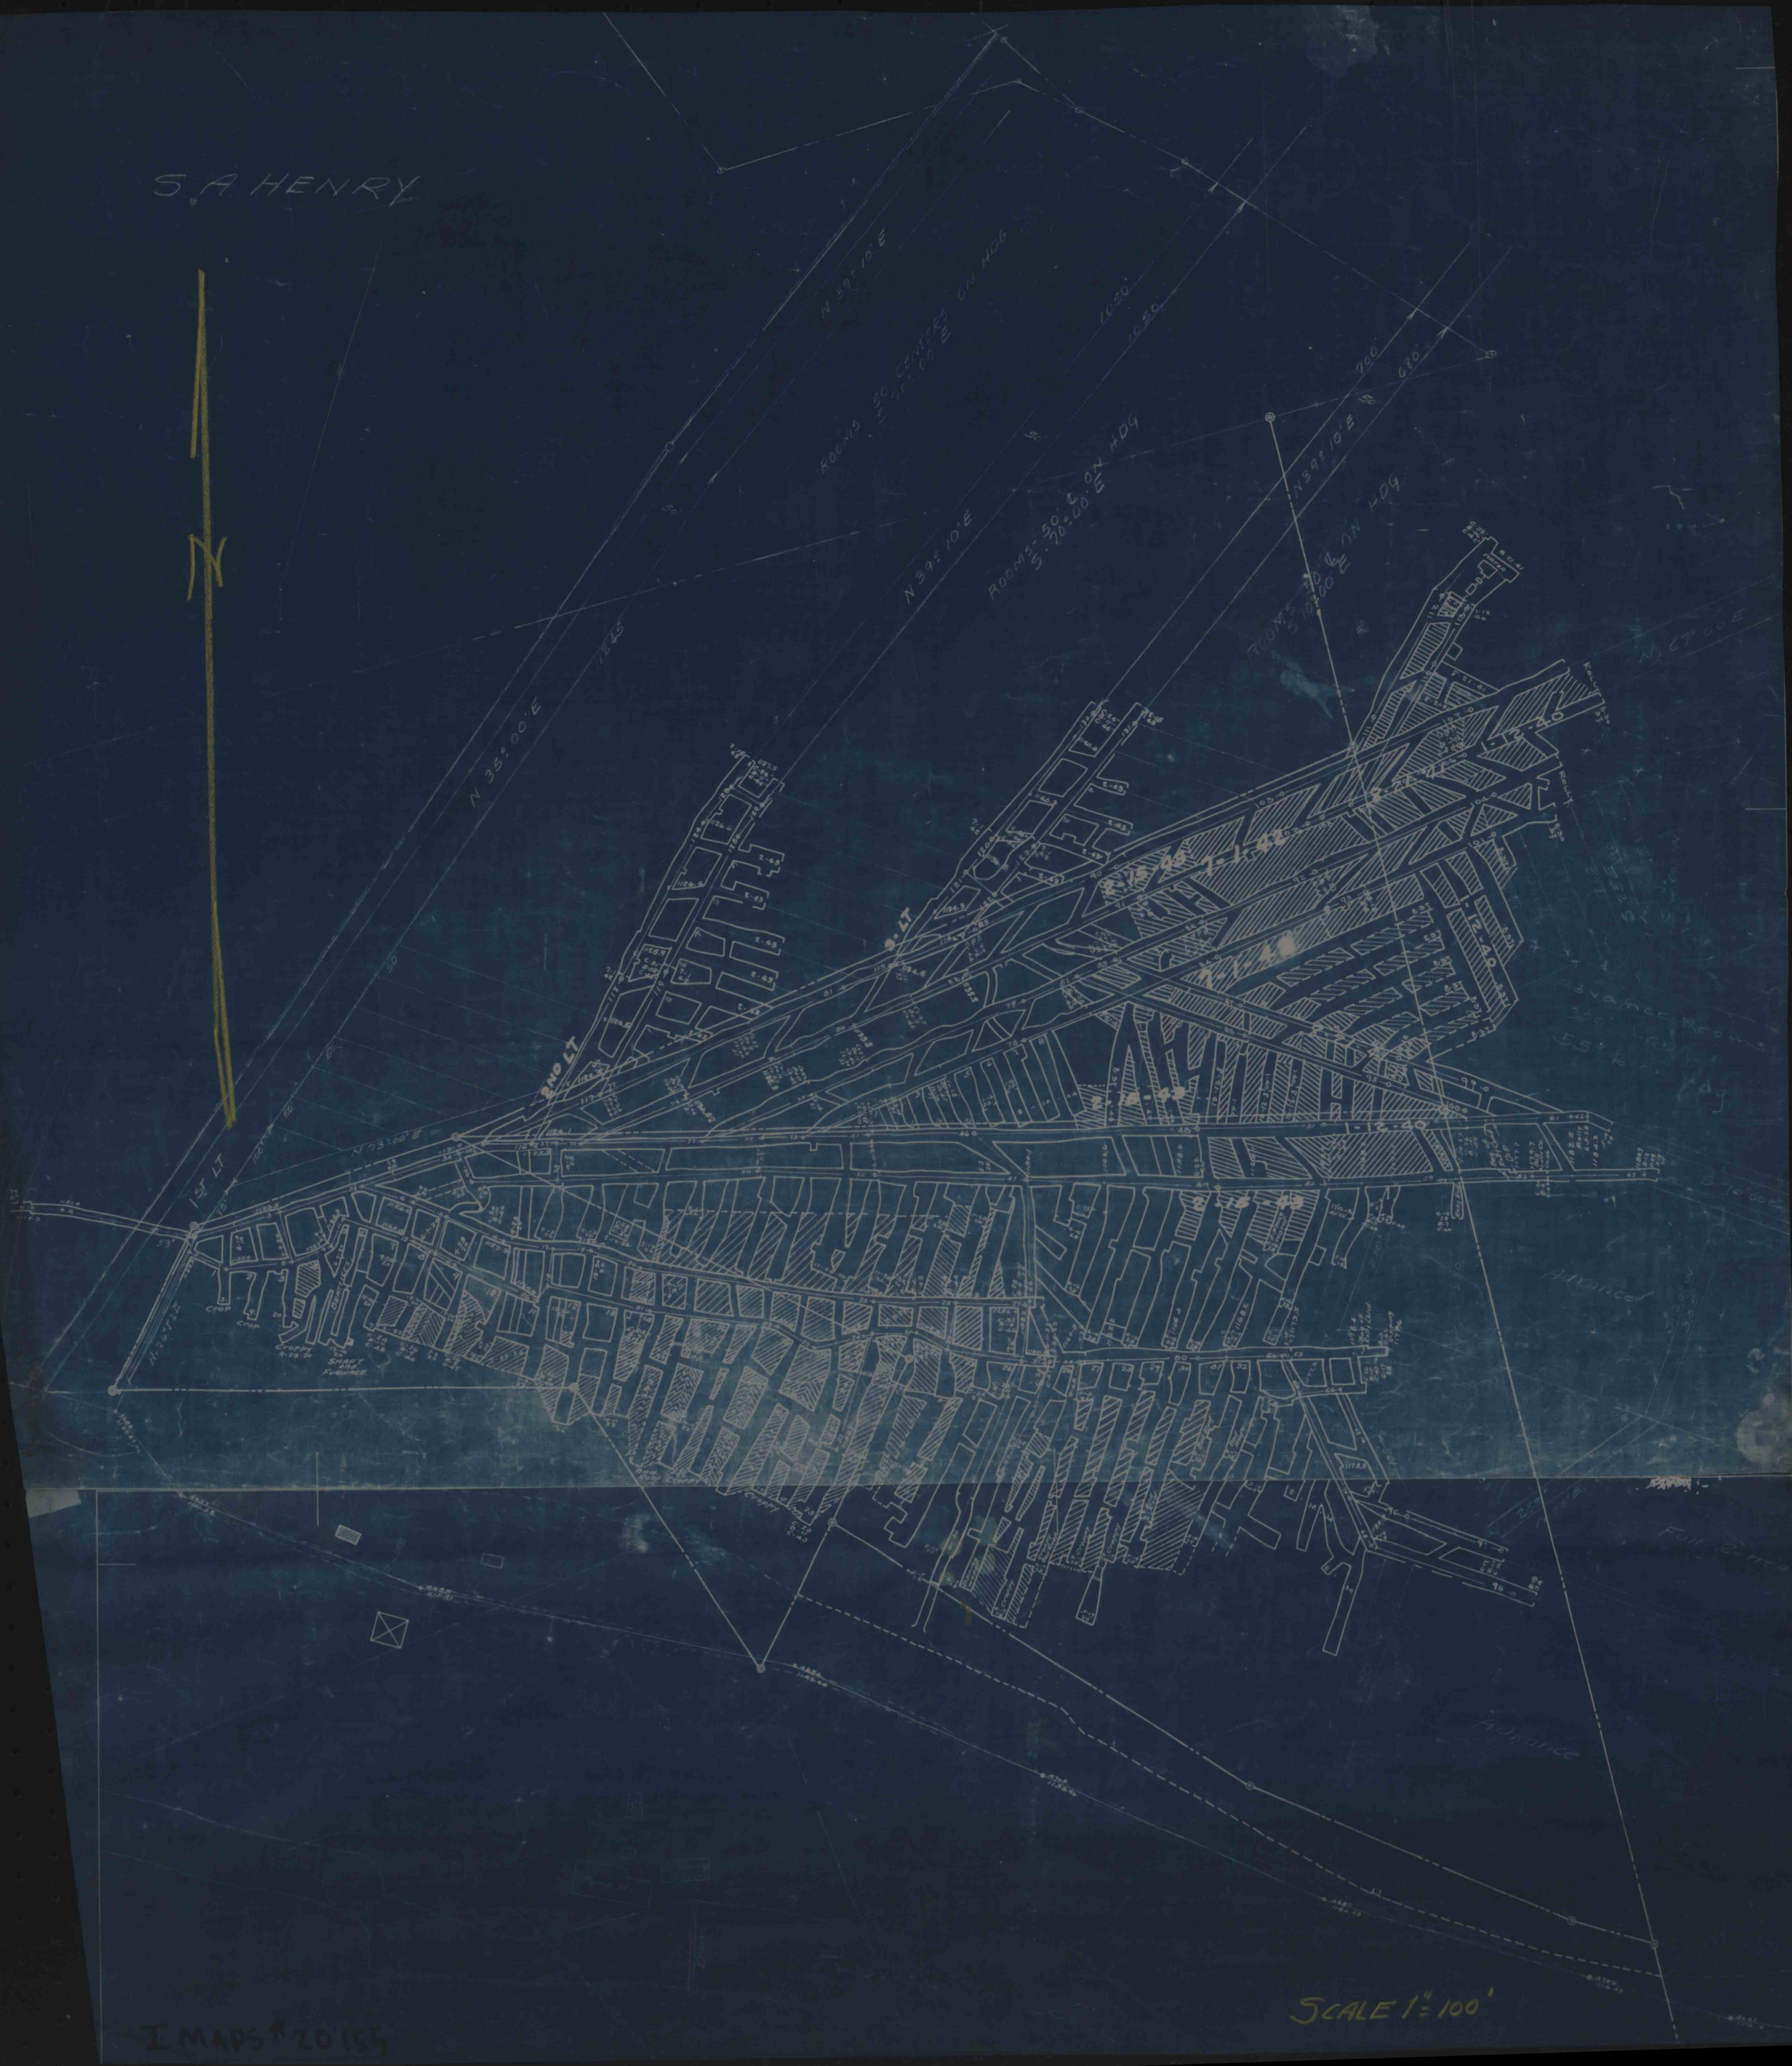
S.A. HENRY
N
N 39° 10' E
ROONS - 50' ℄ ON HDG
S. 70° 00' E
N 35° 00' E
1245
1050
900
680
1-1-42
1-12-40
2-15-43
1ST LT
2ND LT
3RD LT
CROP
SHAFT
FURNACE
SCALE 1" = 100'

I MAPS # 20155