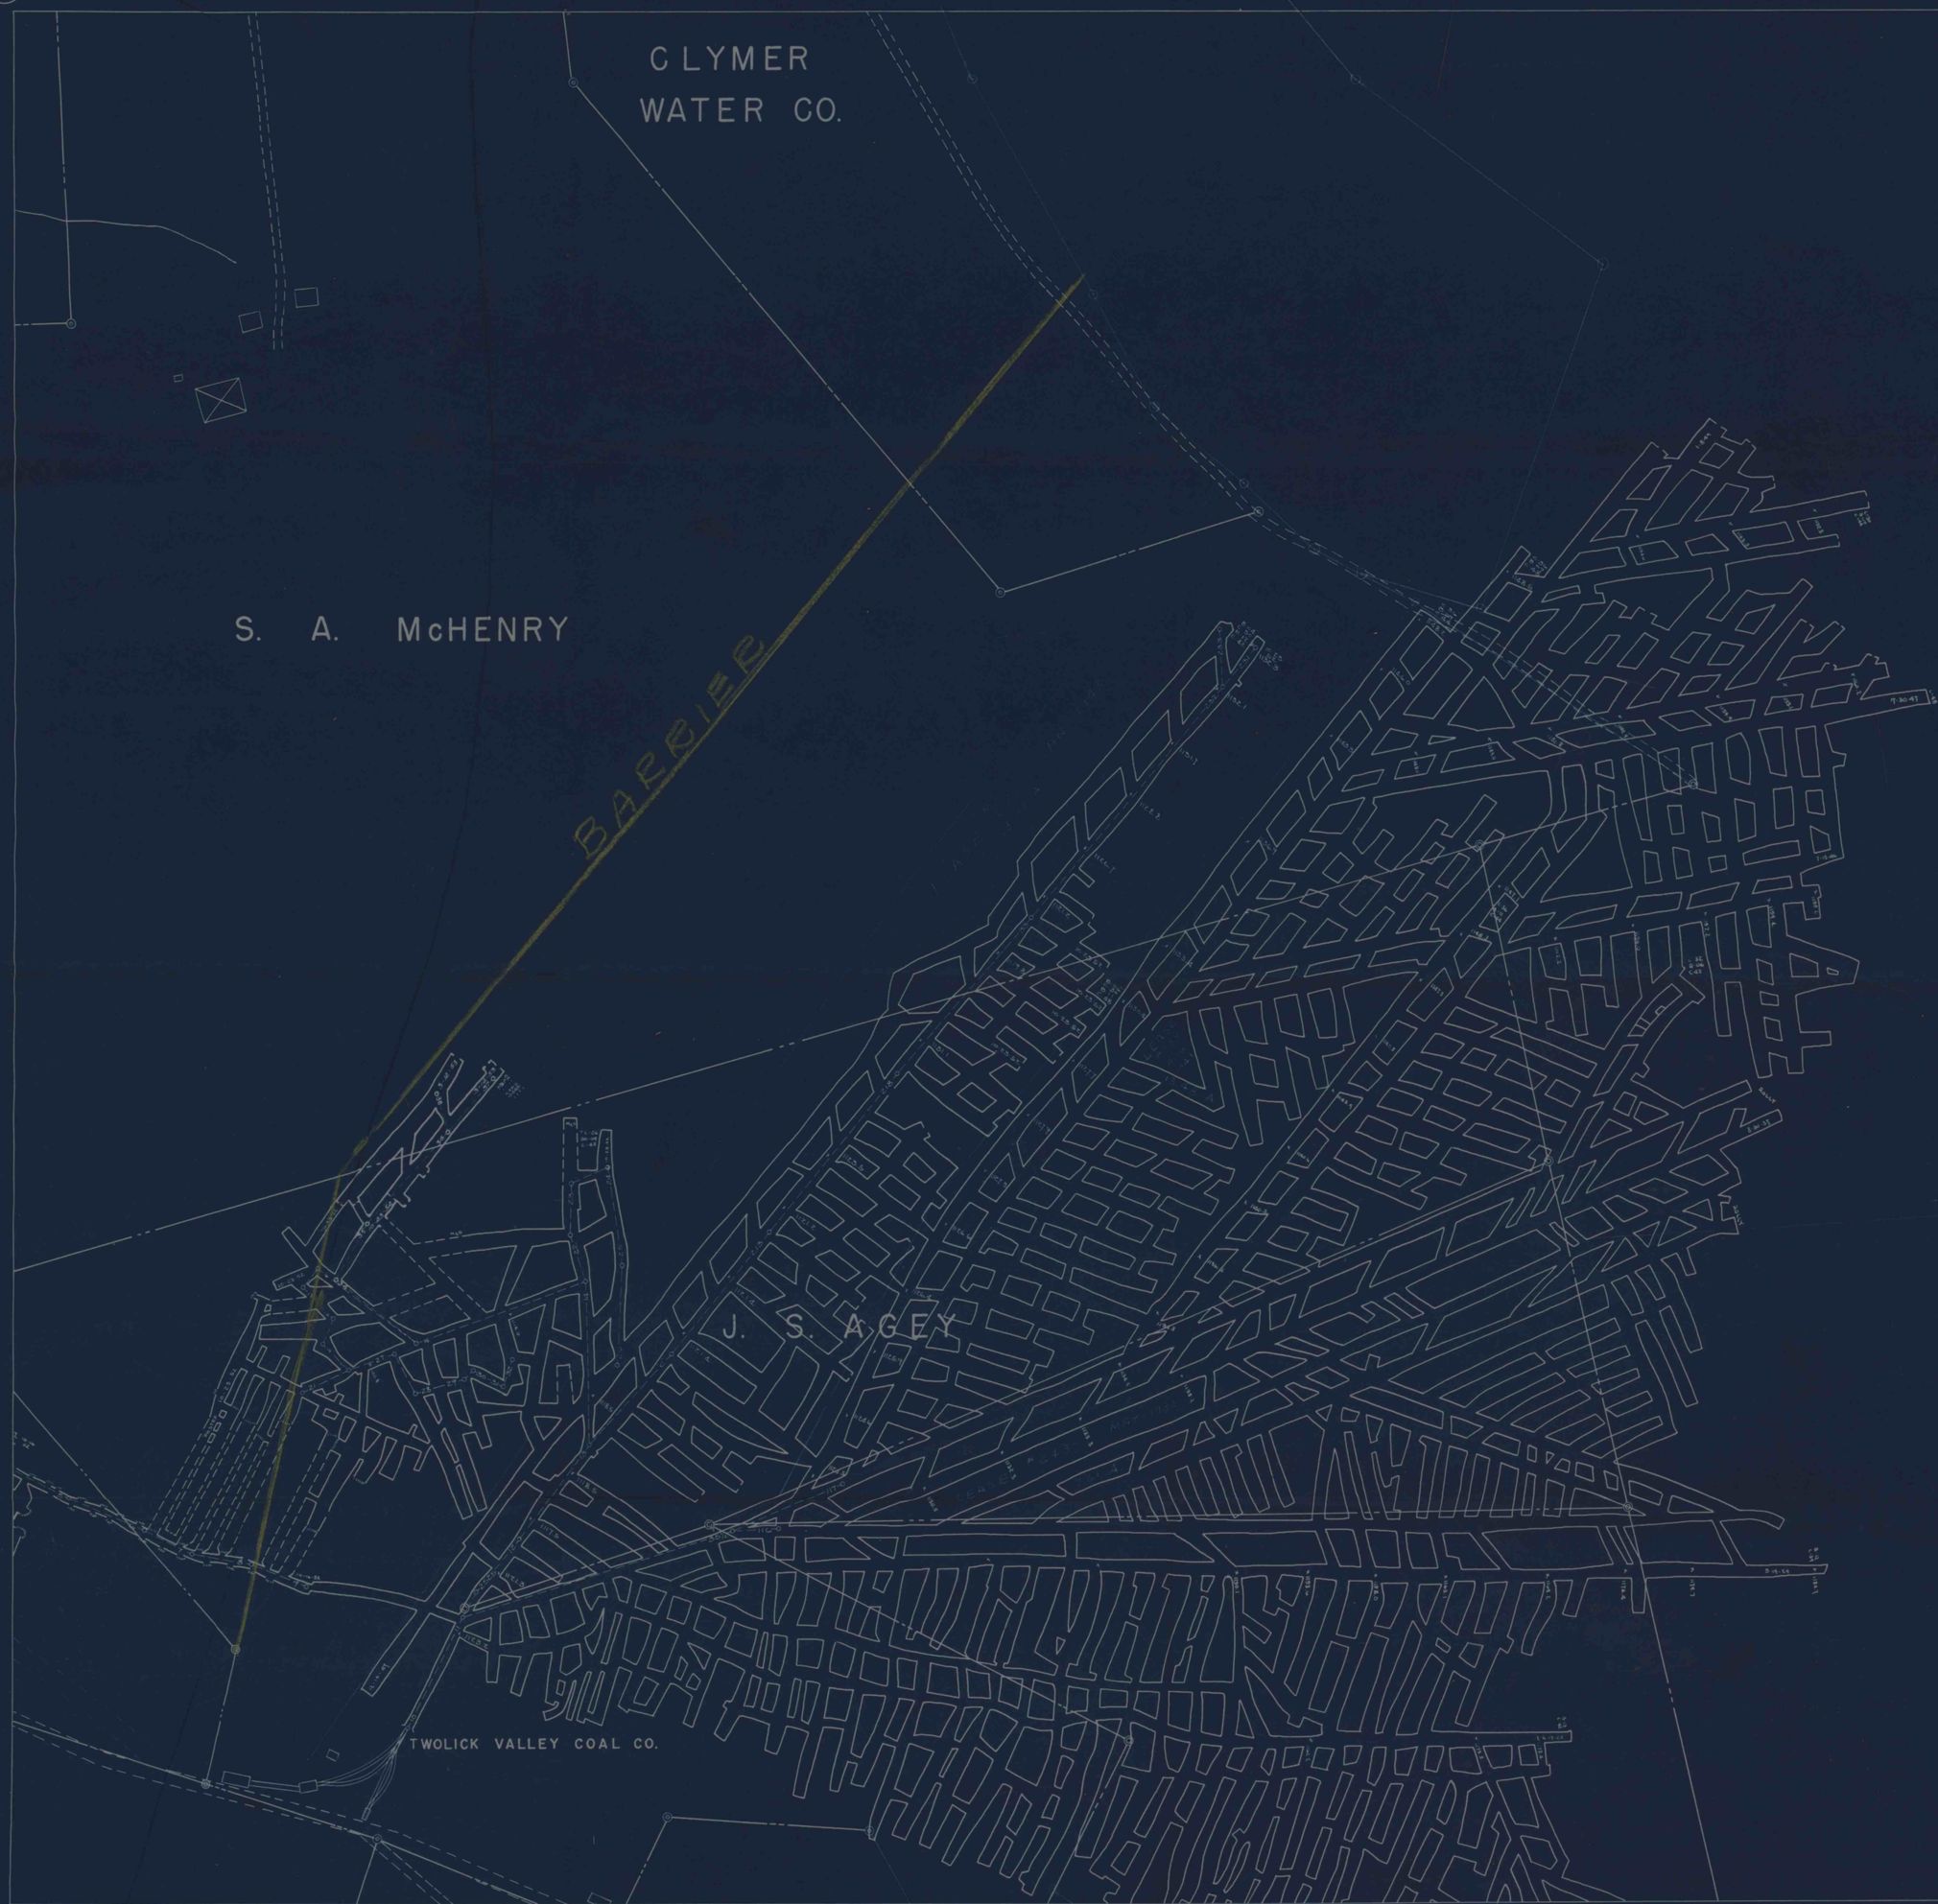
CLYMER
WATER CO.
S. A. McHENRY
BARRIER
J. S. AGEY
TWOLICK VALLEY COAL CO.