


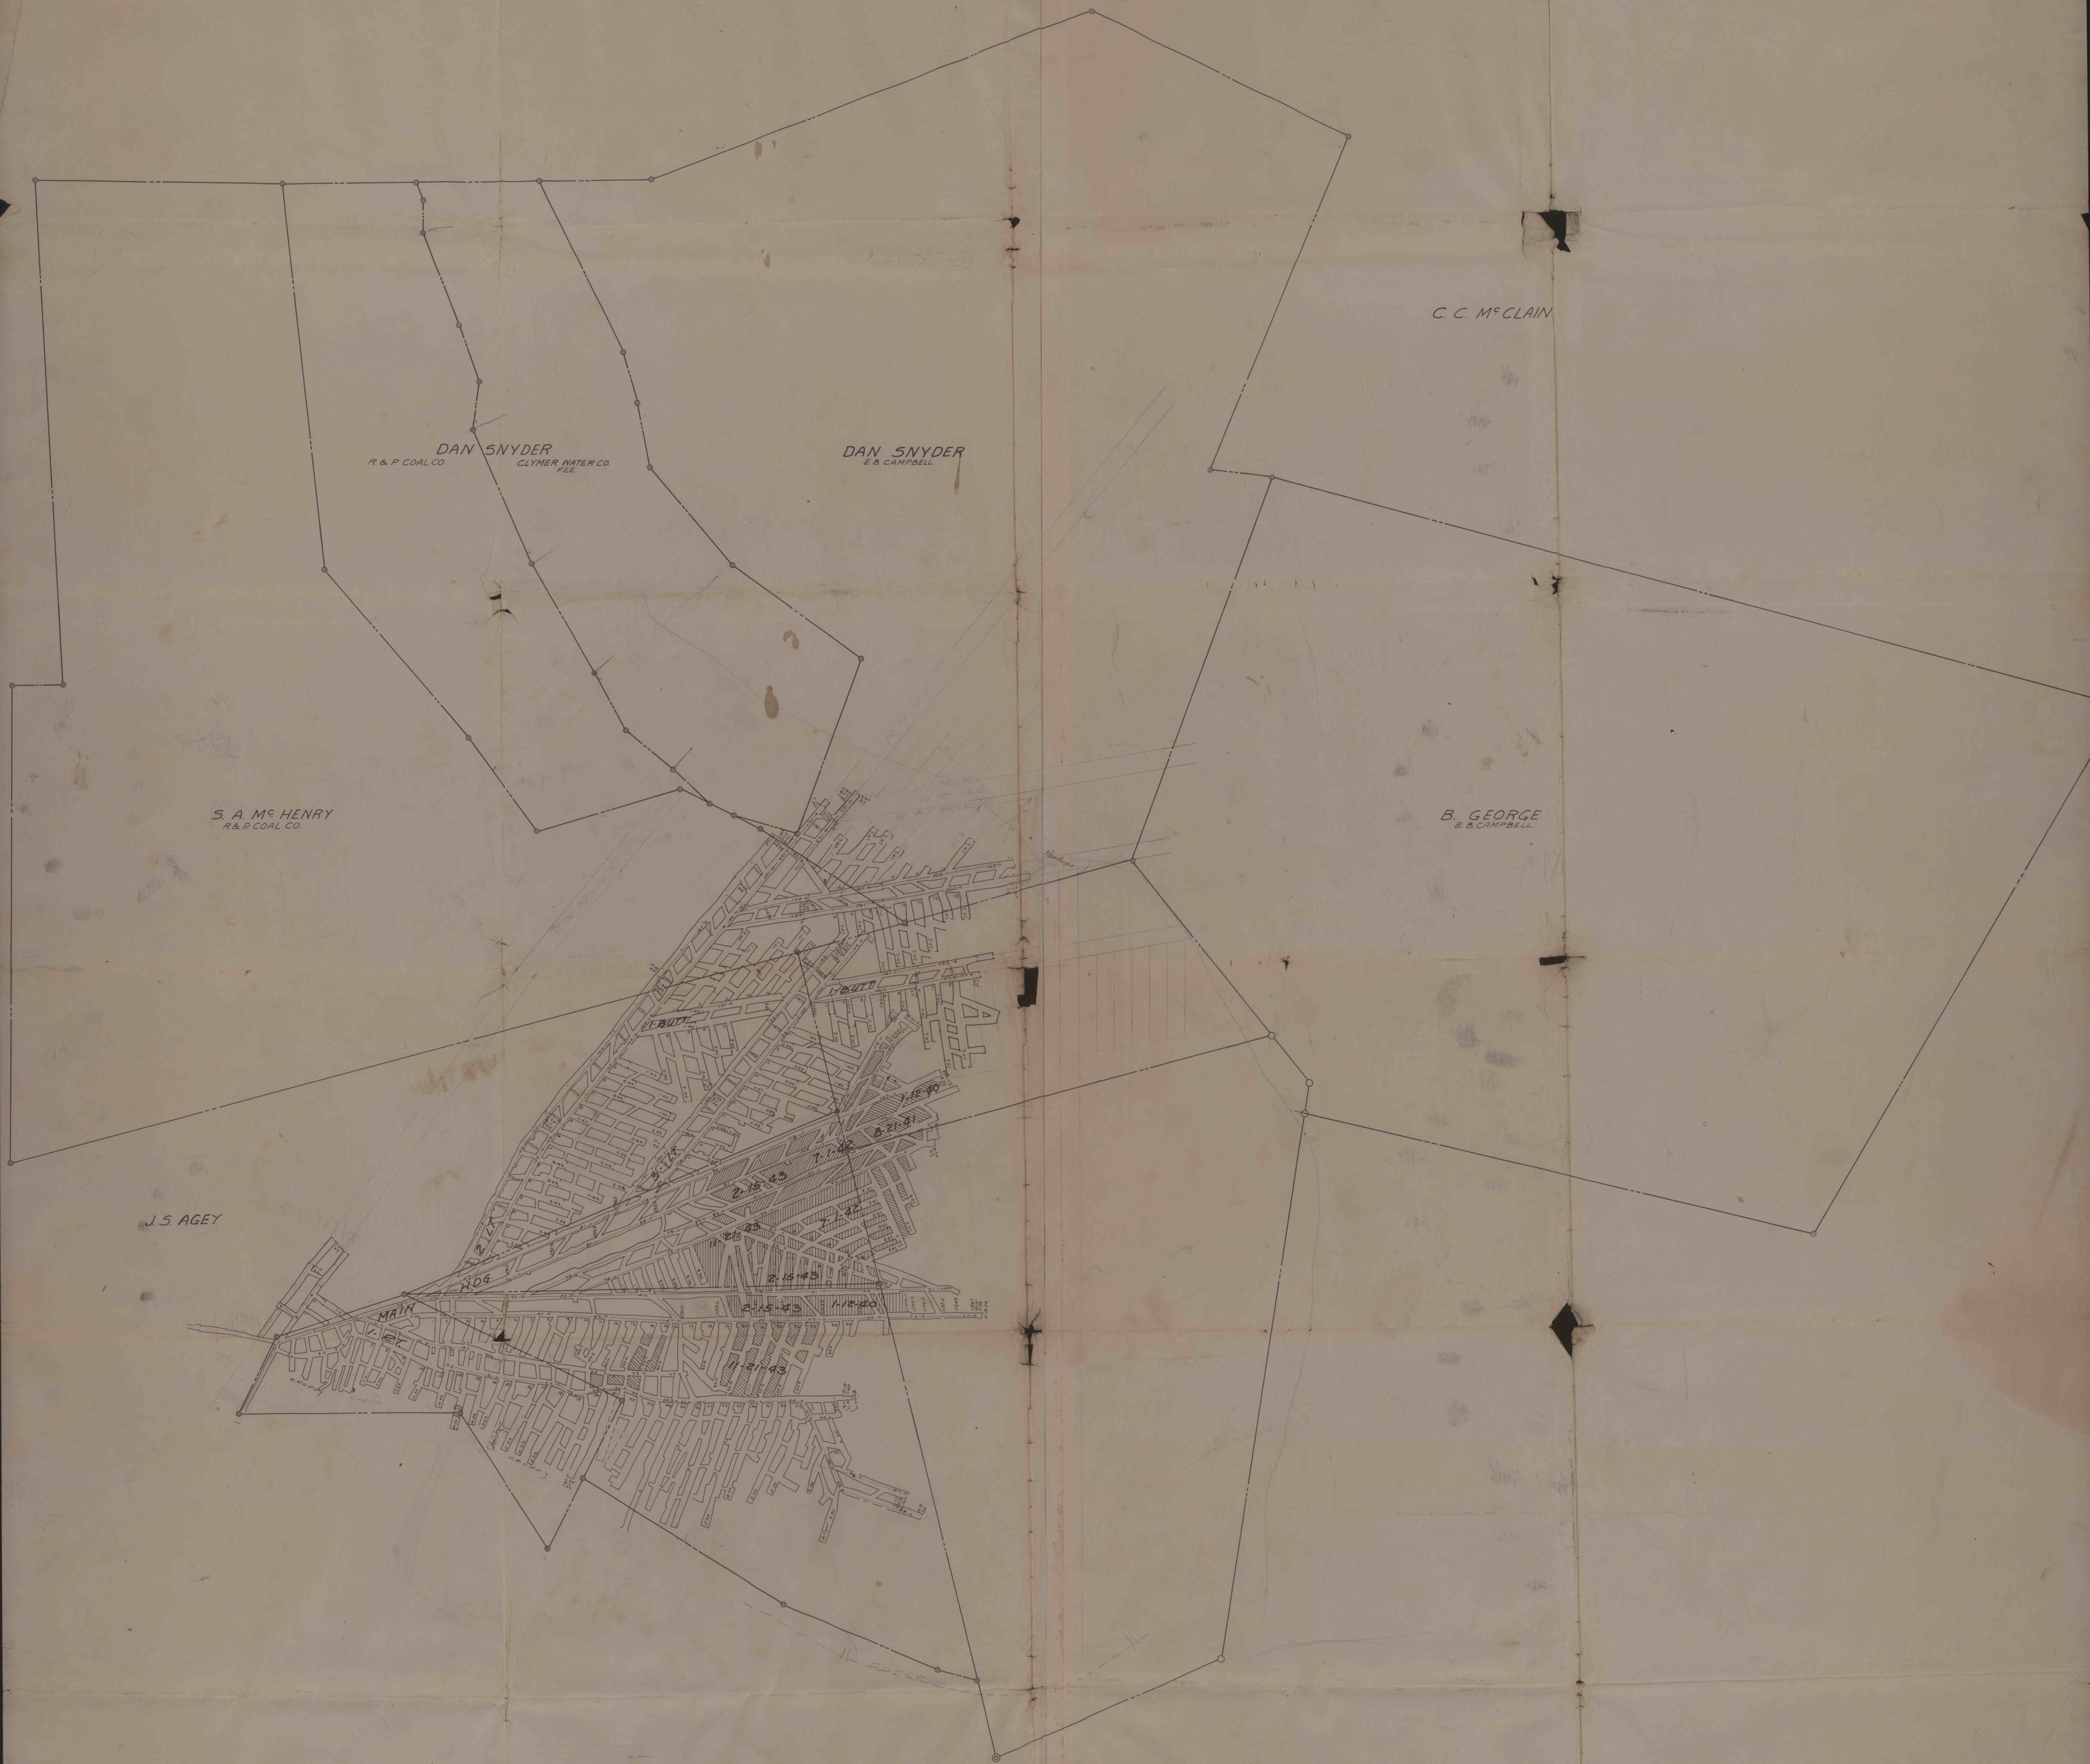

DAN SNYDER
R & P COAL CO.
CLYMER WATER CO.
FEE

DAN SNYDER
E & CAMPBELL

C. C. Mc CLAIN

S. A. Mc HENRY
R & P COAL CO.

B. GEORGE
E & CAMPBELL

J. S. AGEY