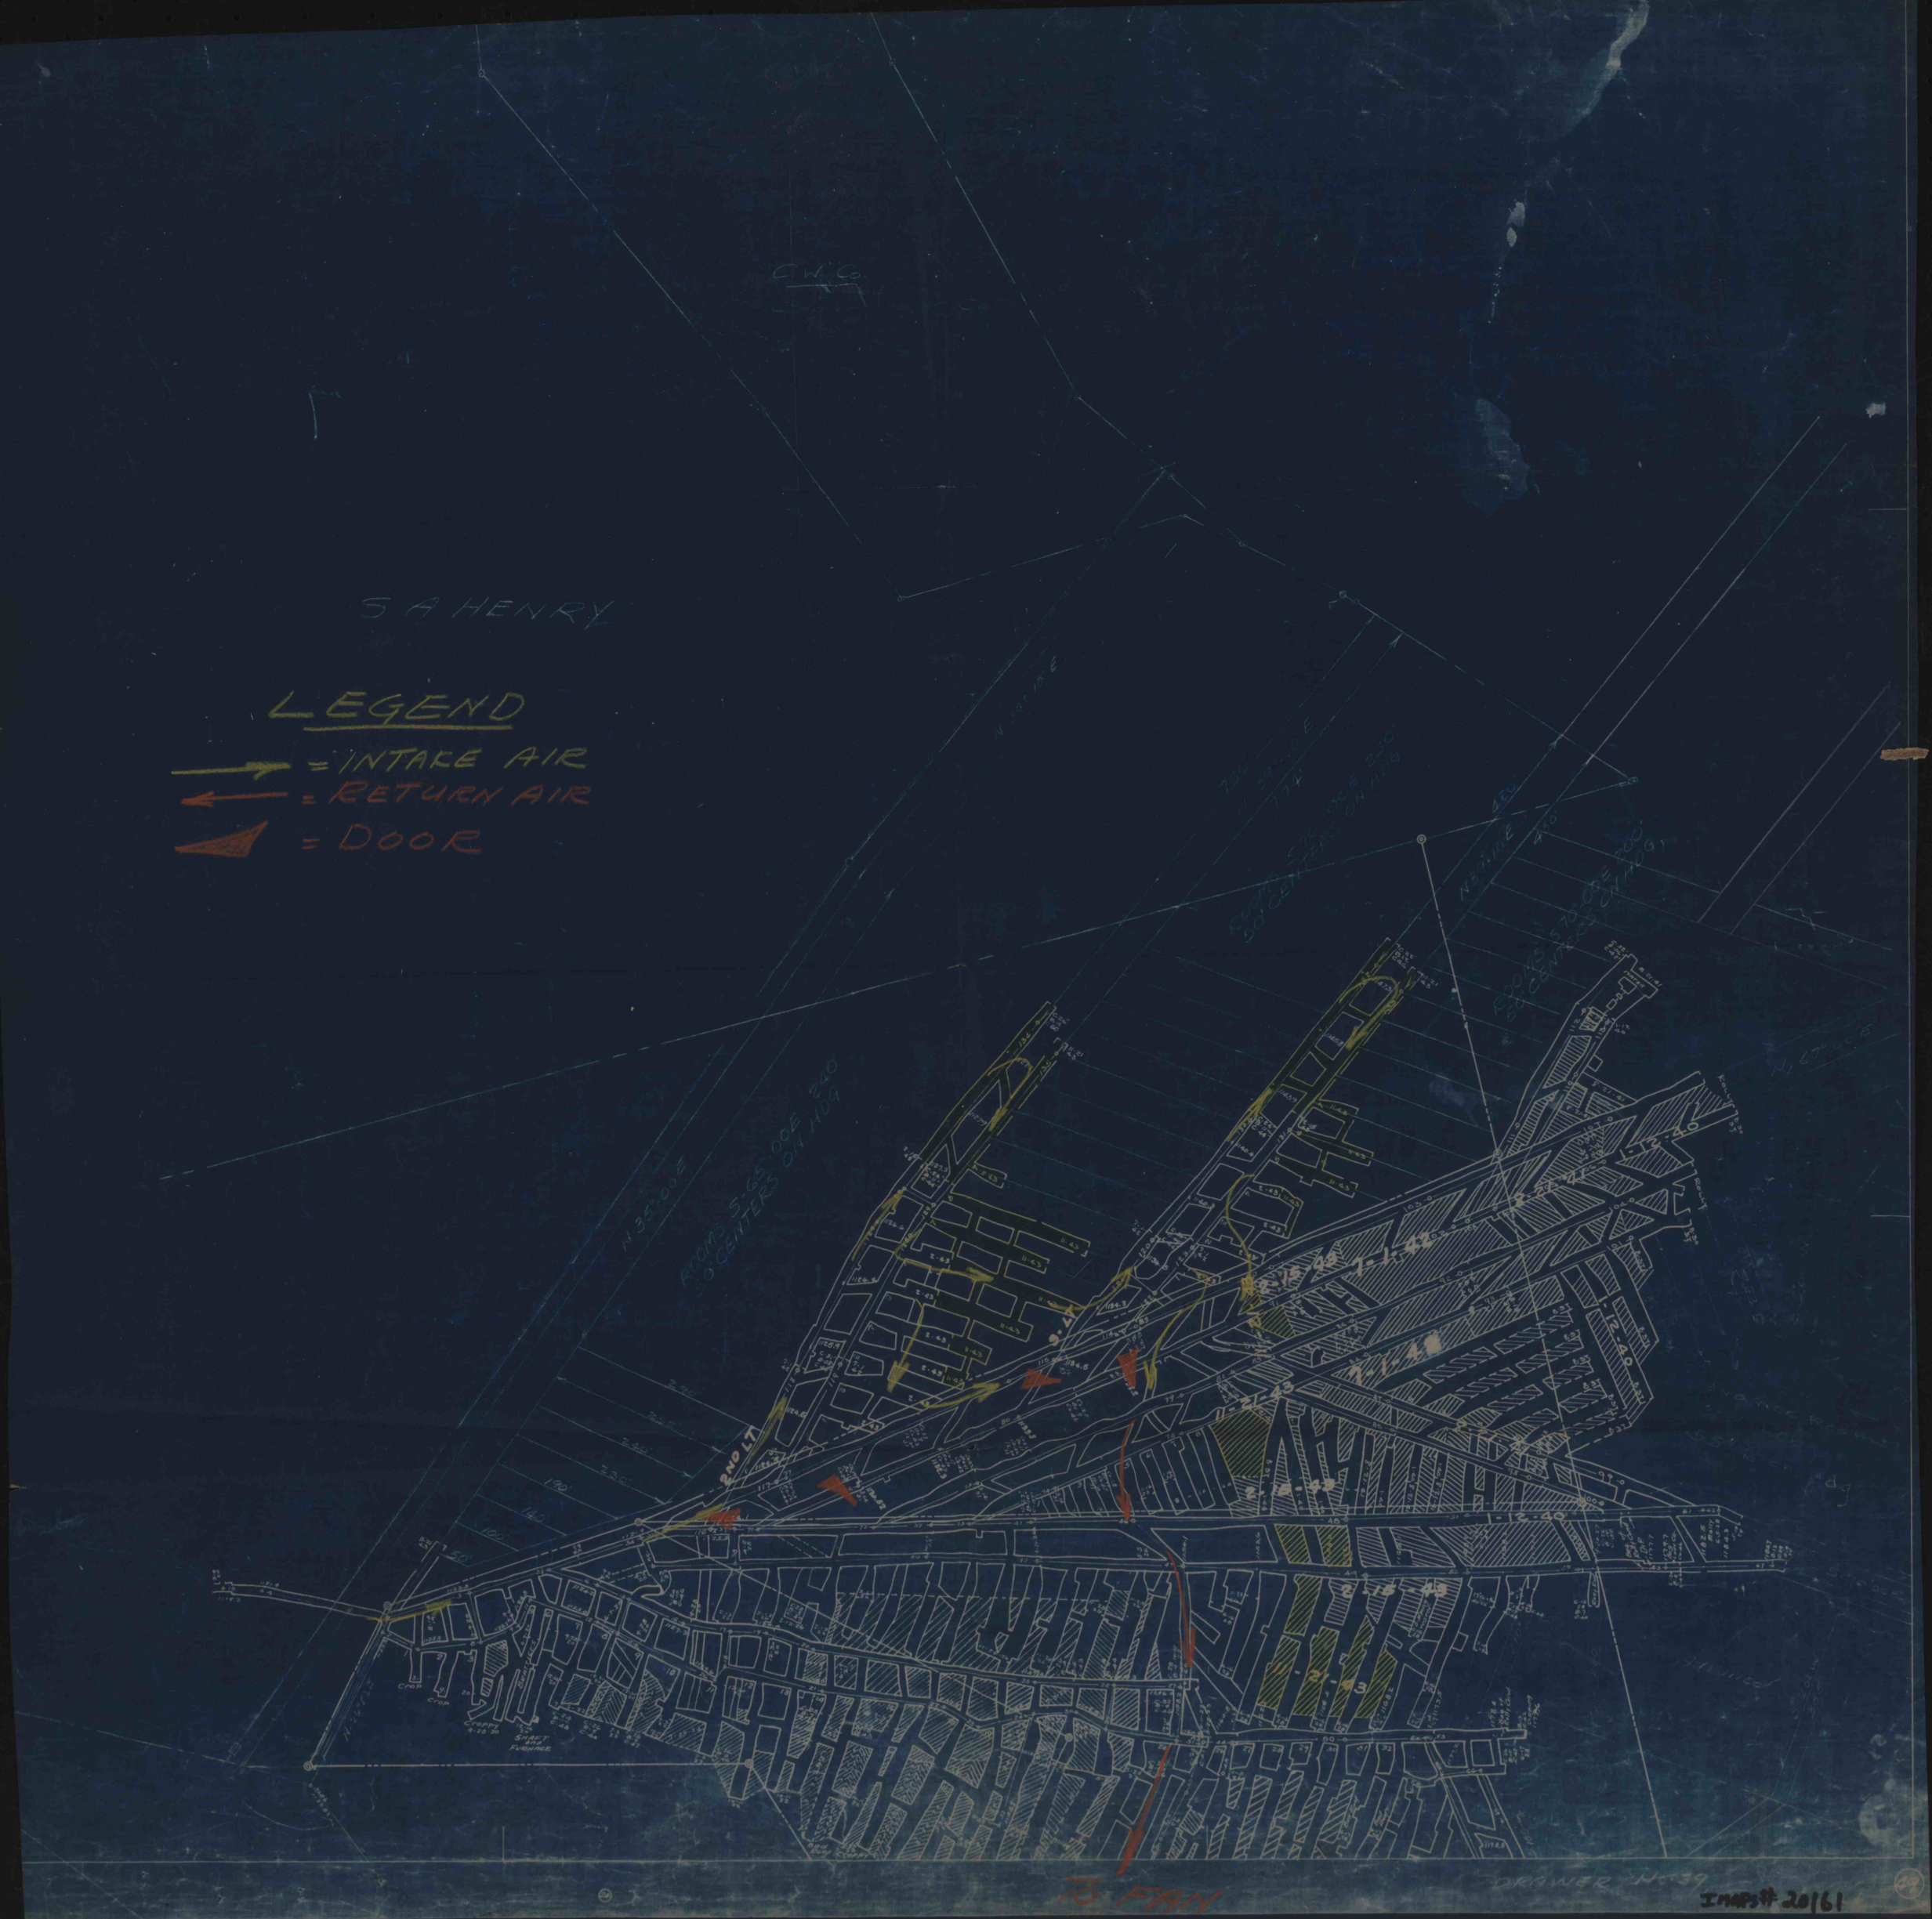
S A HENRY
LEGEND
= INTAKE AIR
= RETURN AIR
= DOOR
2ND LT
TO FAN
DRAWER No 39
IMAPS # 20161