


S.A. HENRY

J.S. AGEY

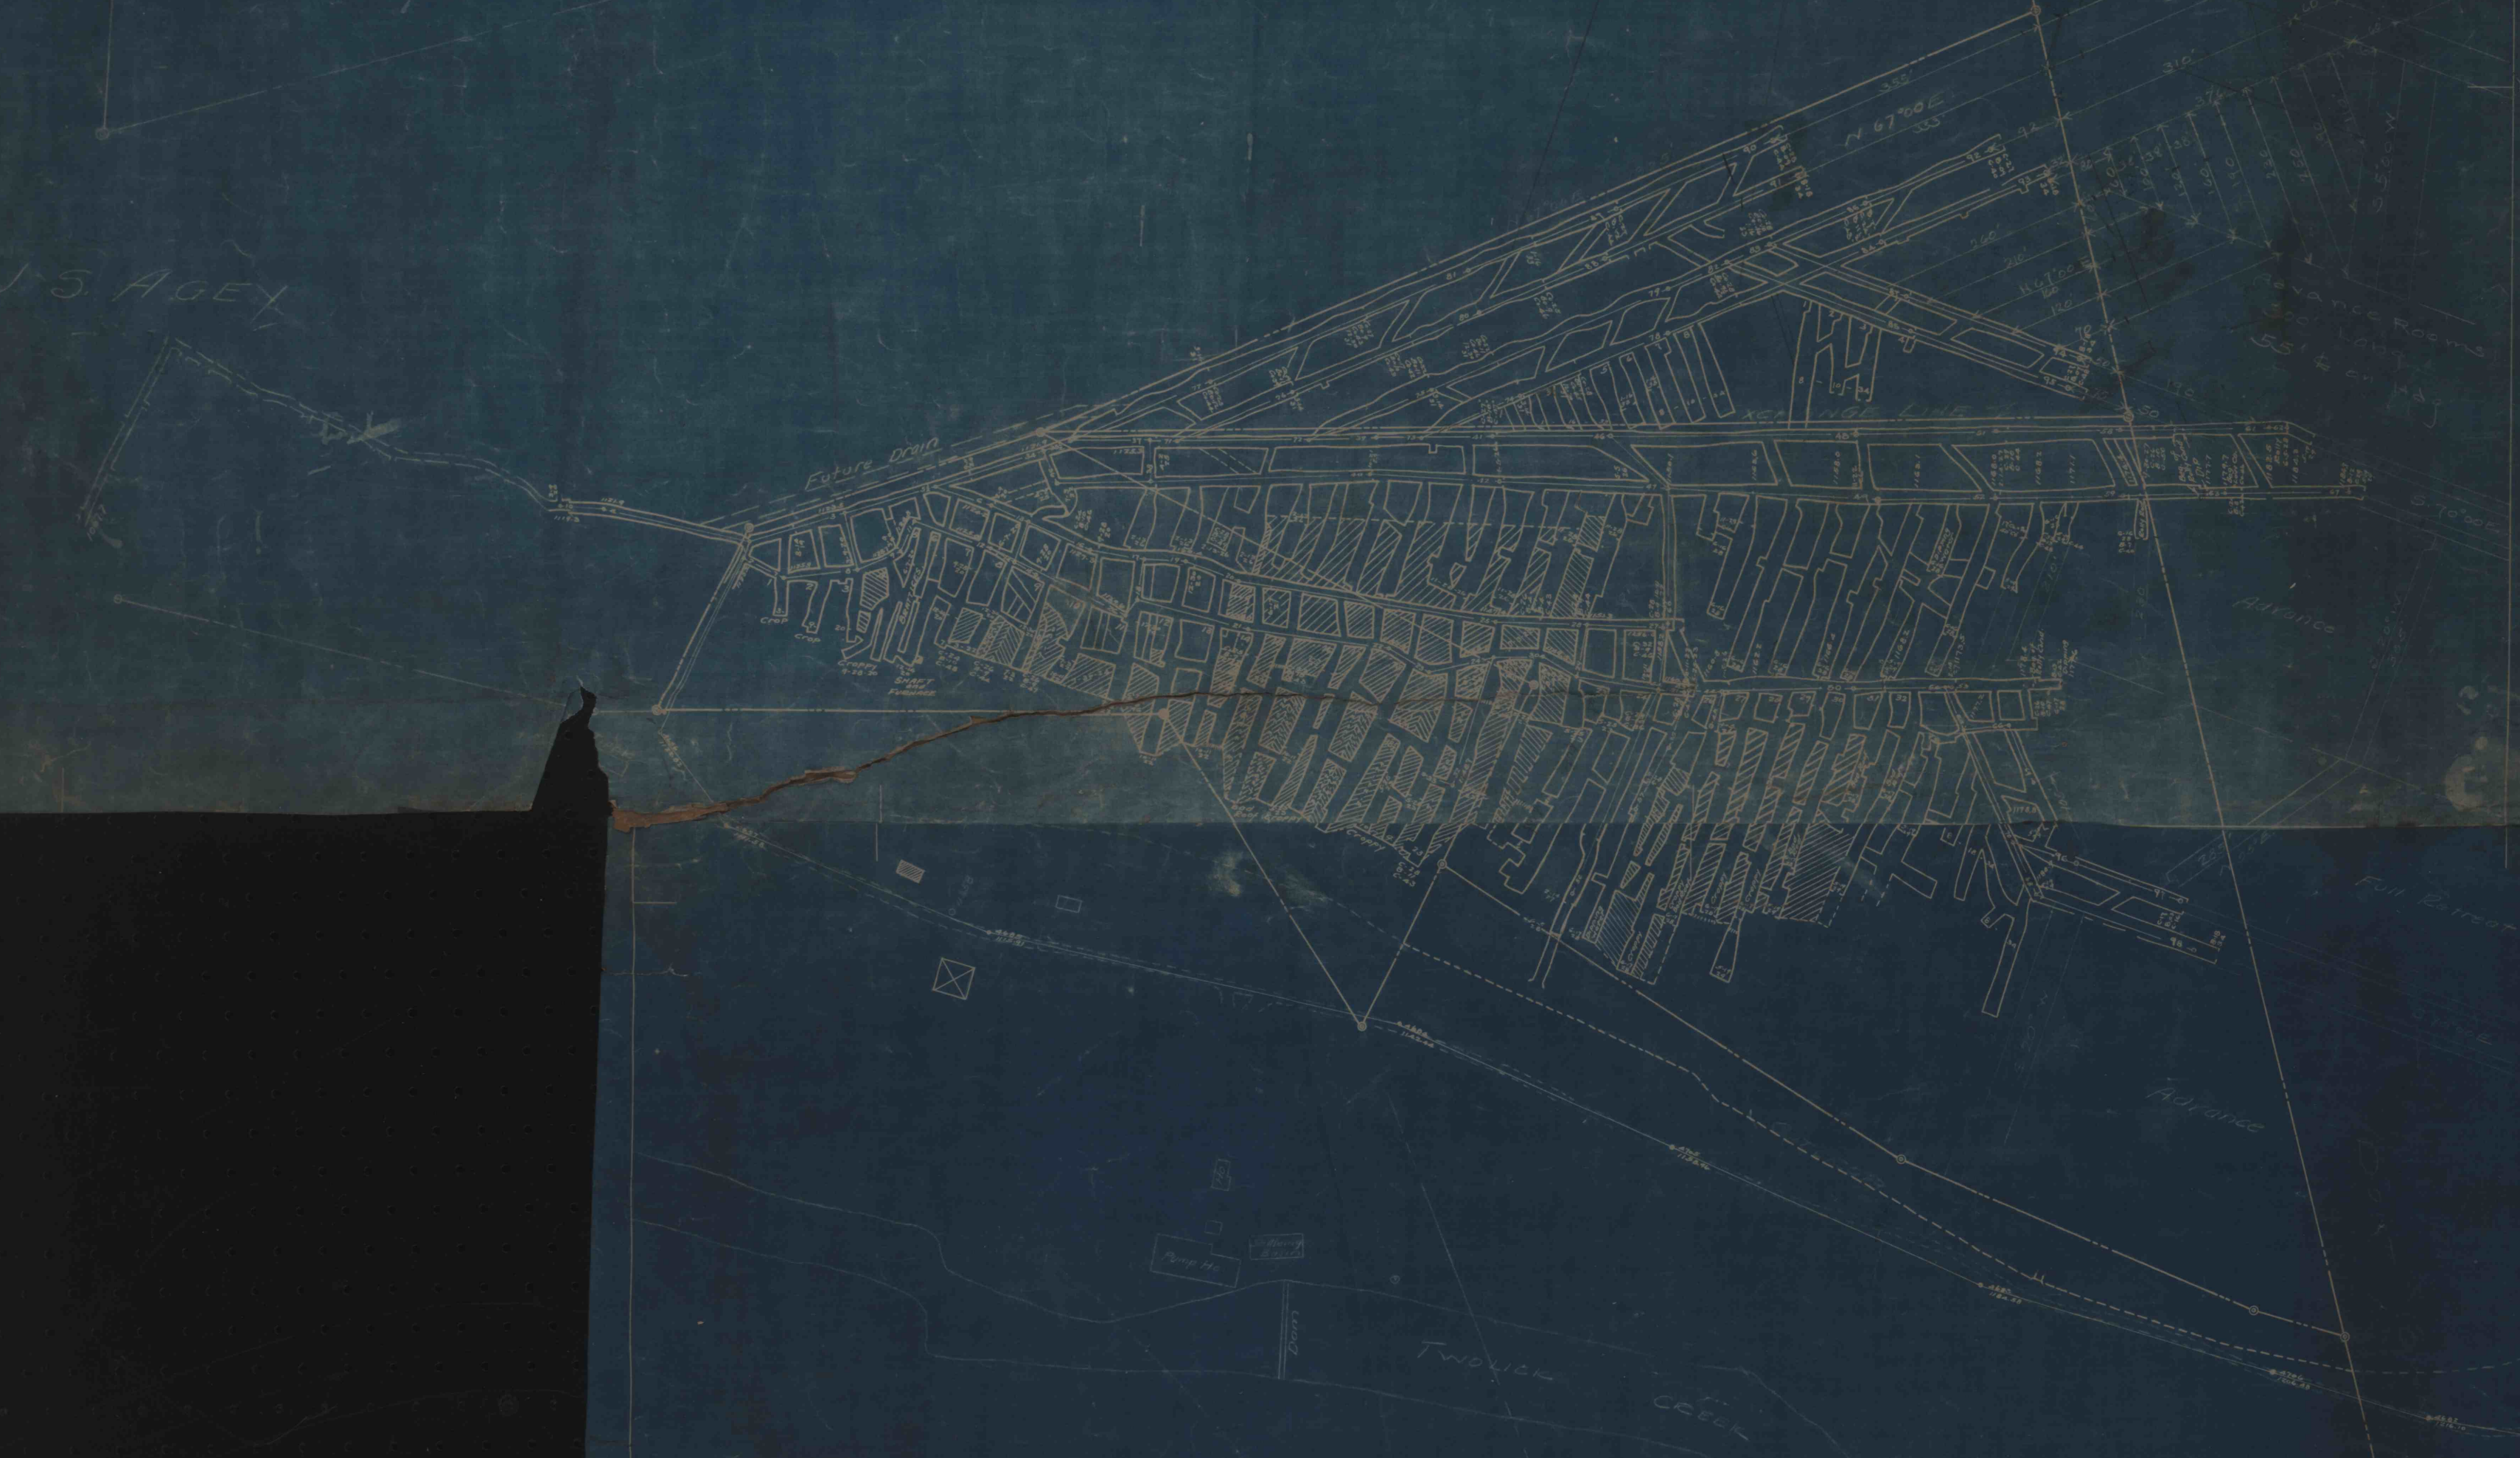

J.M. SCHUMAKER
(DEPT. OWN)