
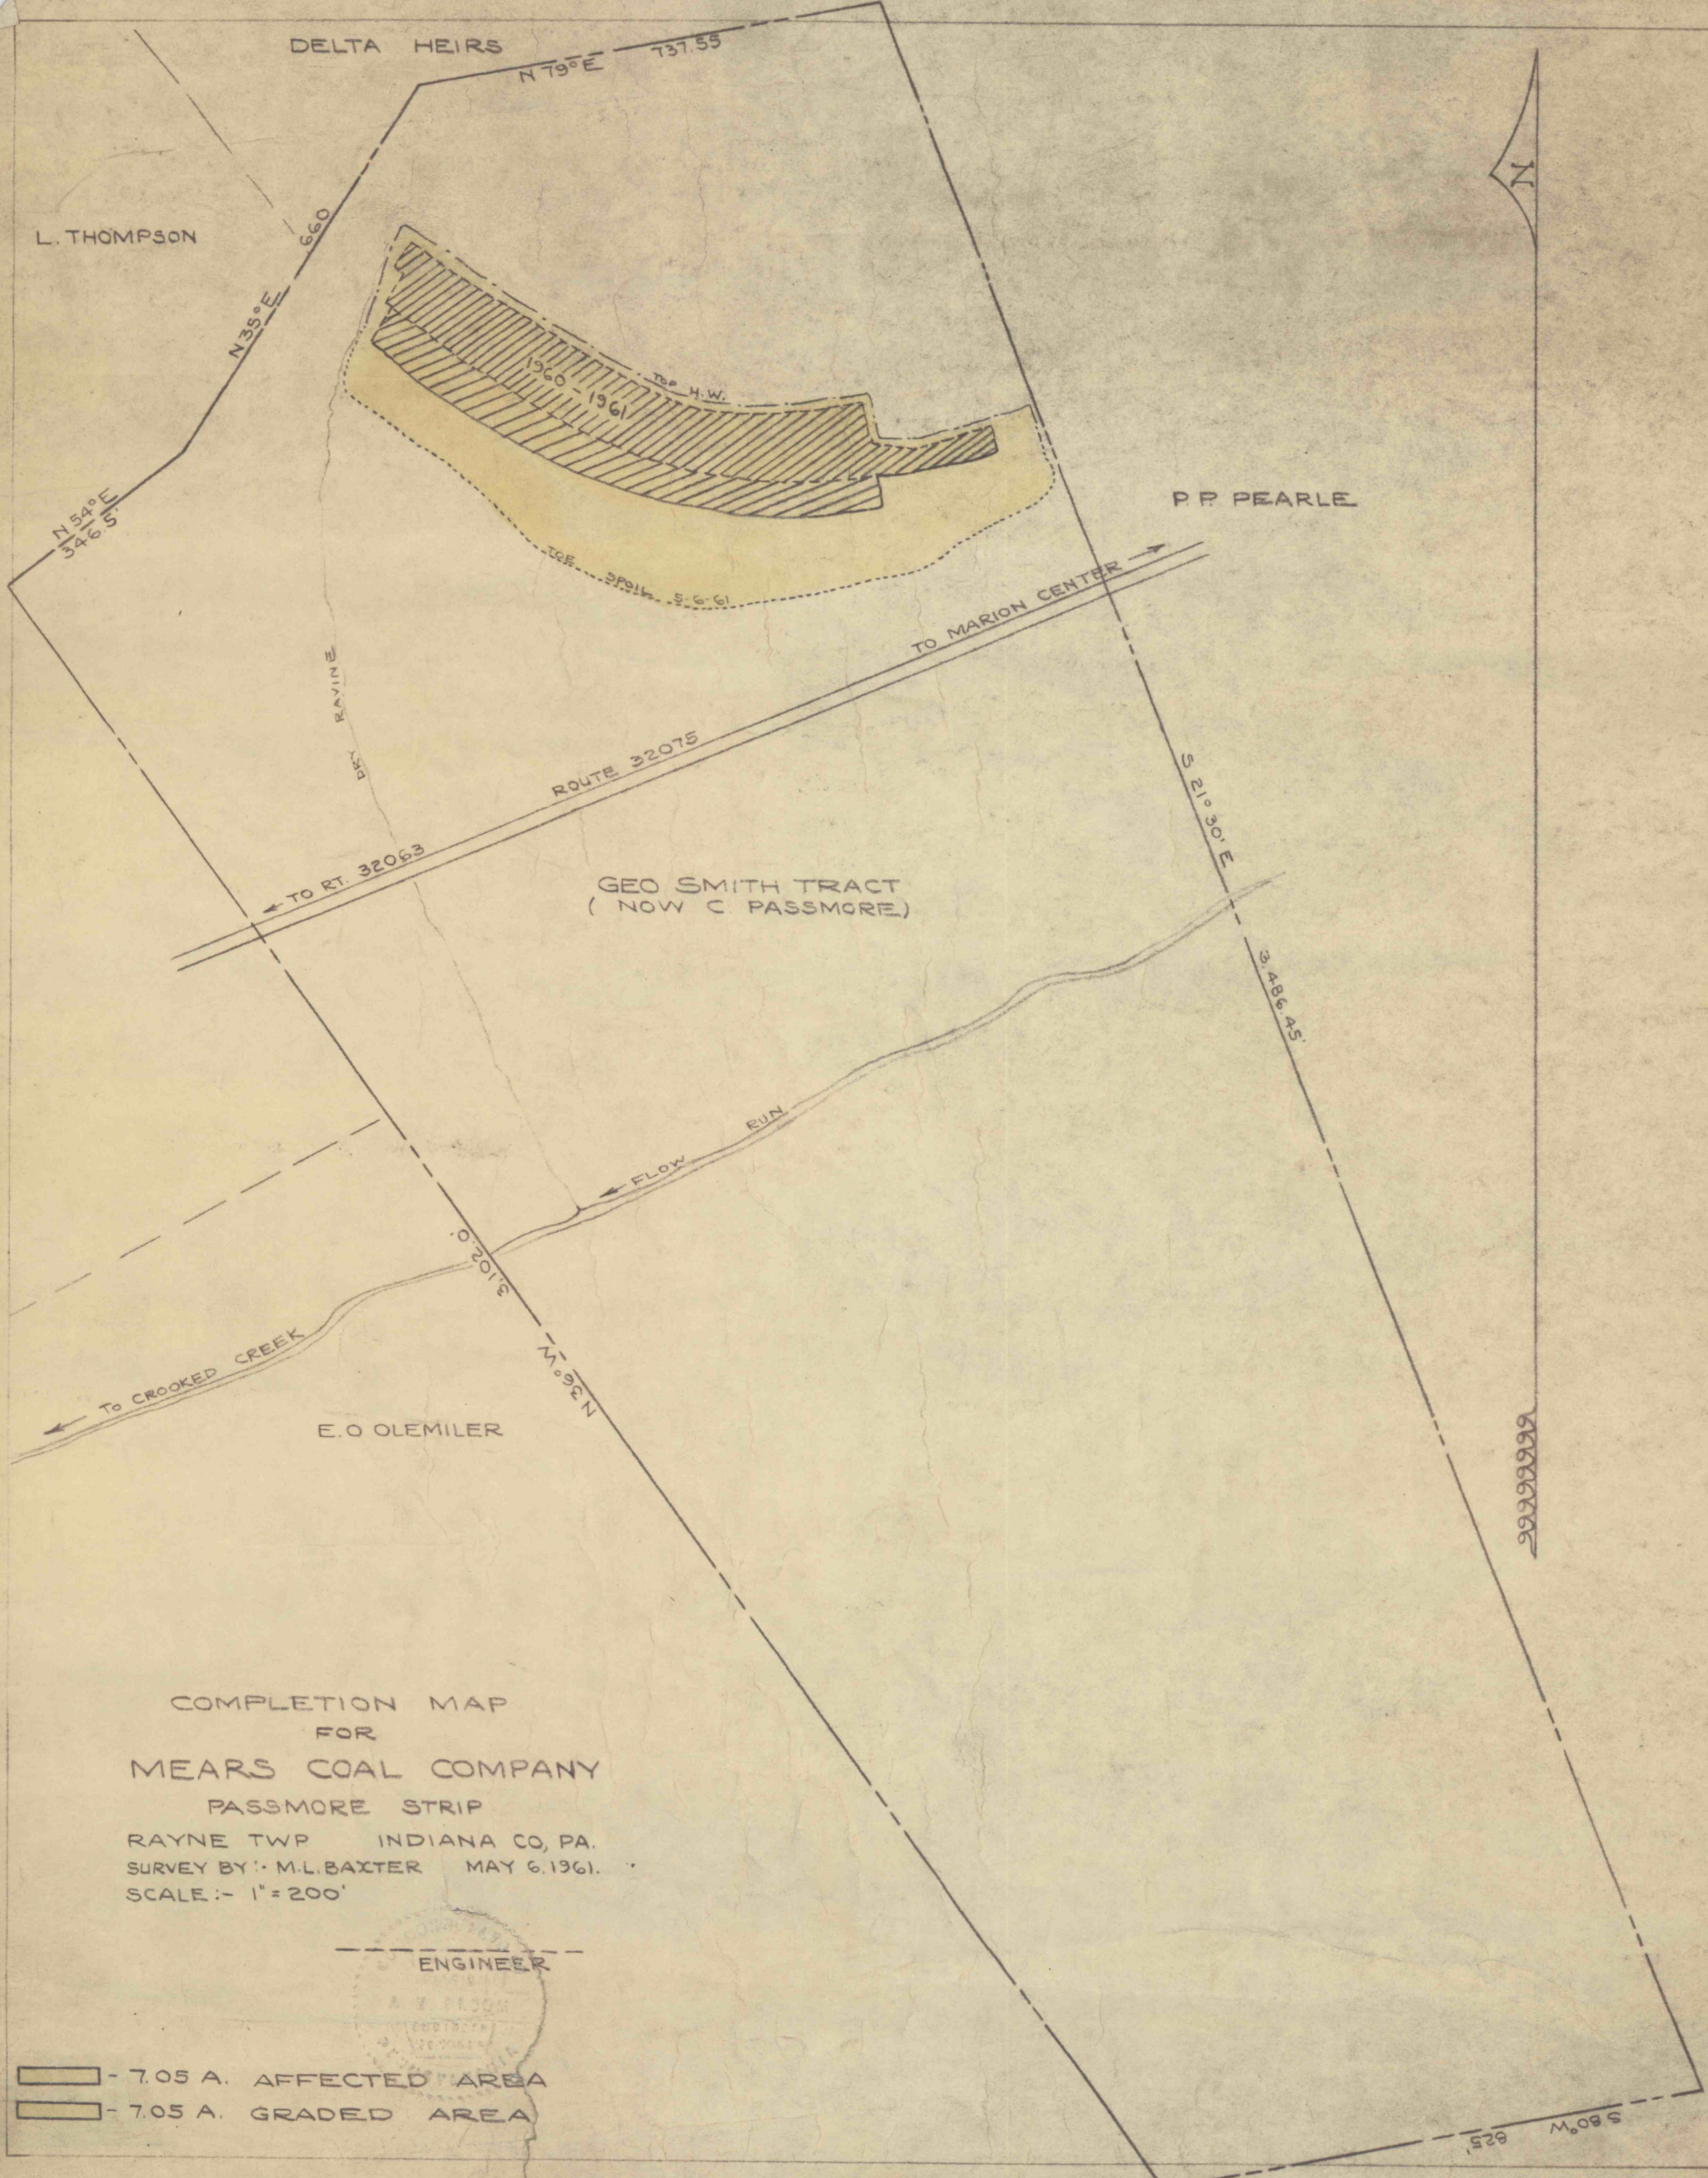
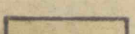


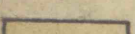

COMPLETION MAP
FOR
MEARS COAL COMPANY
PASSMORE STRIP
RAYNE TWP INDIANA CO, PA.
SURVEY BY: M.L. BAXTER MAY 6, 1961.
SCALE: - 1" = 200'

ENGINEER
A. V. FLOOM
REGISTERED PROFESSIONAL ENGINEER
PA.

-  - 7.05 A. AFFECTED AREA
-  - 7.05 A. GRADED AREA