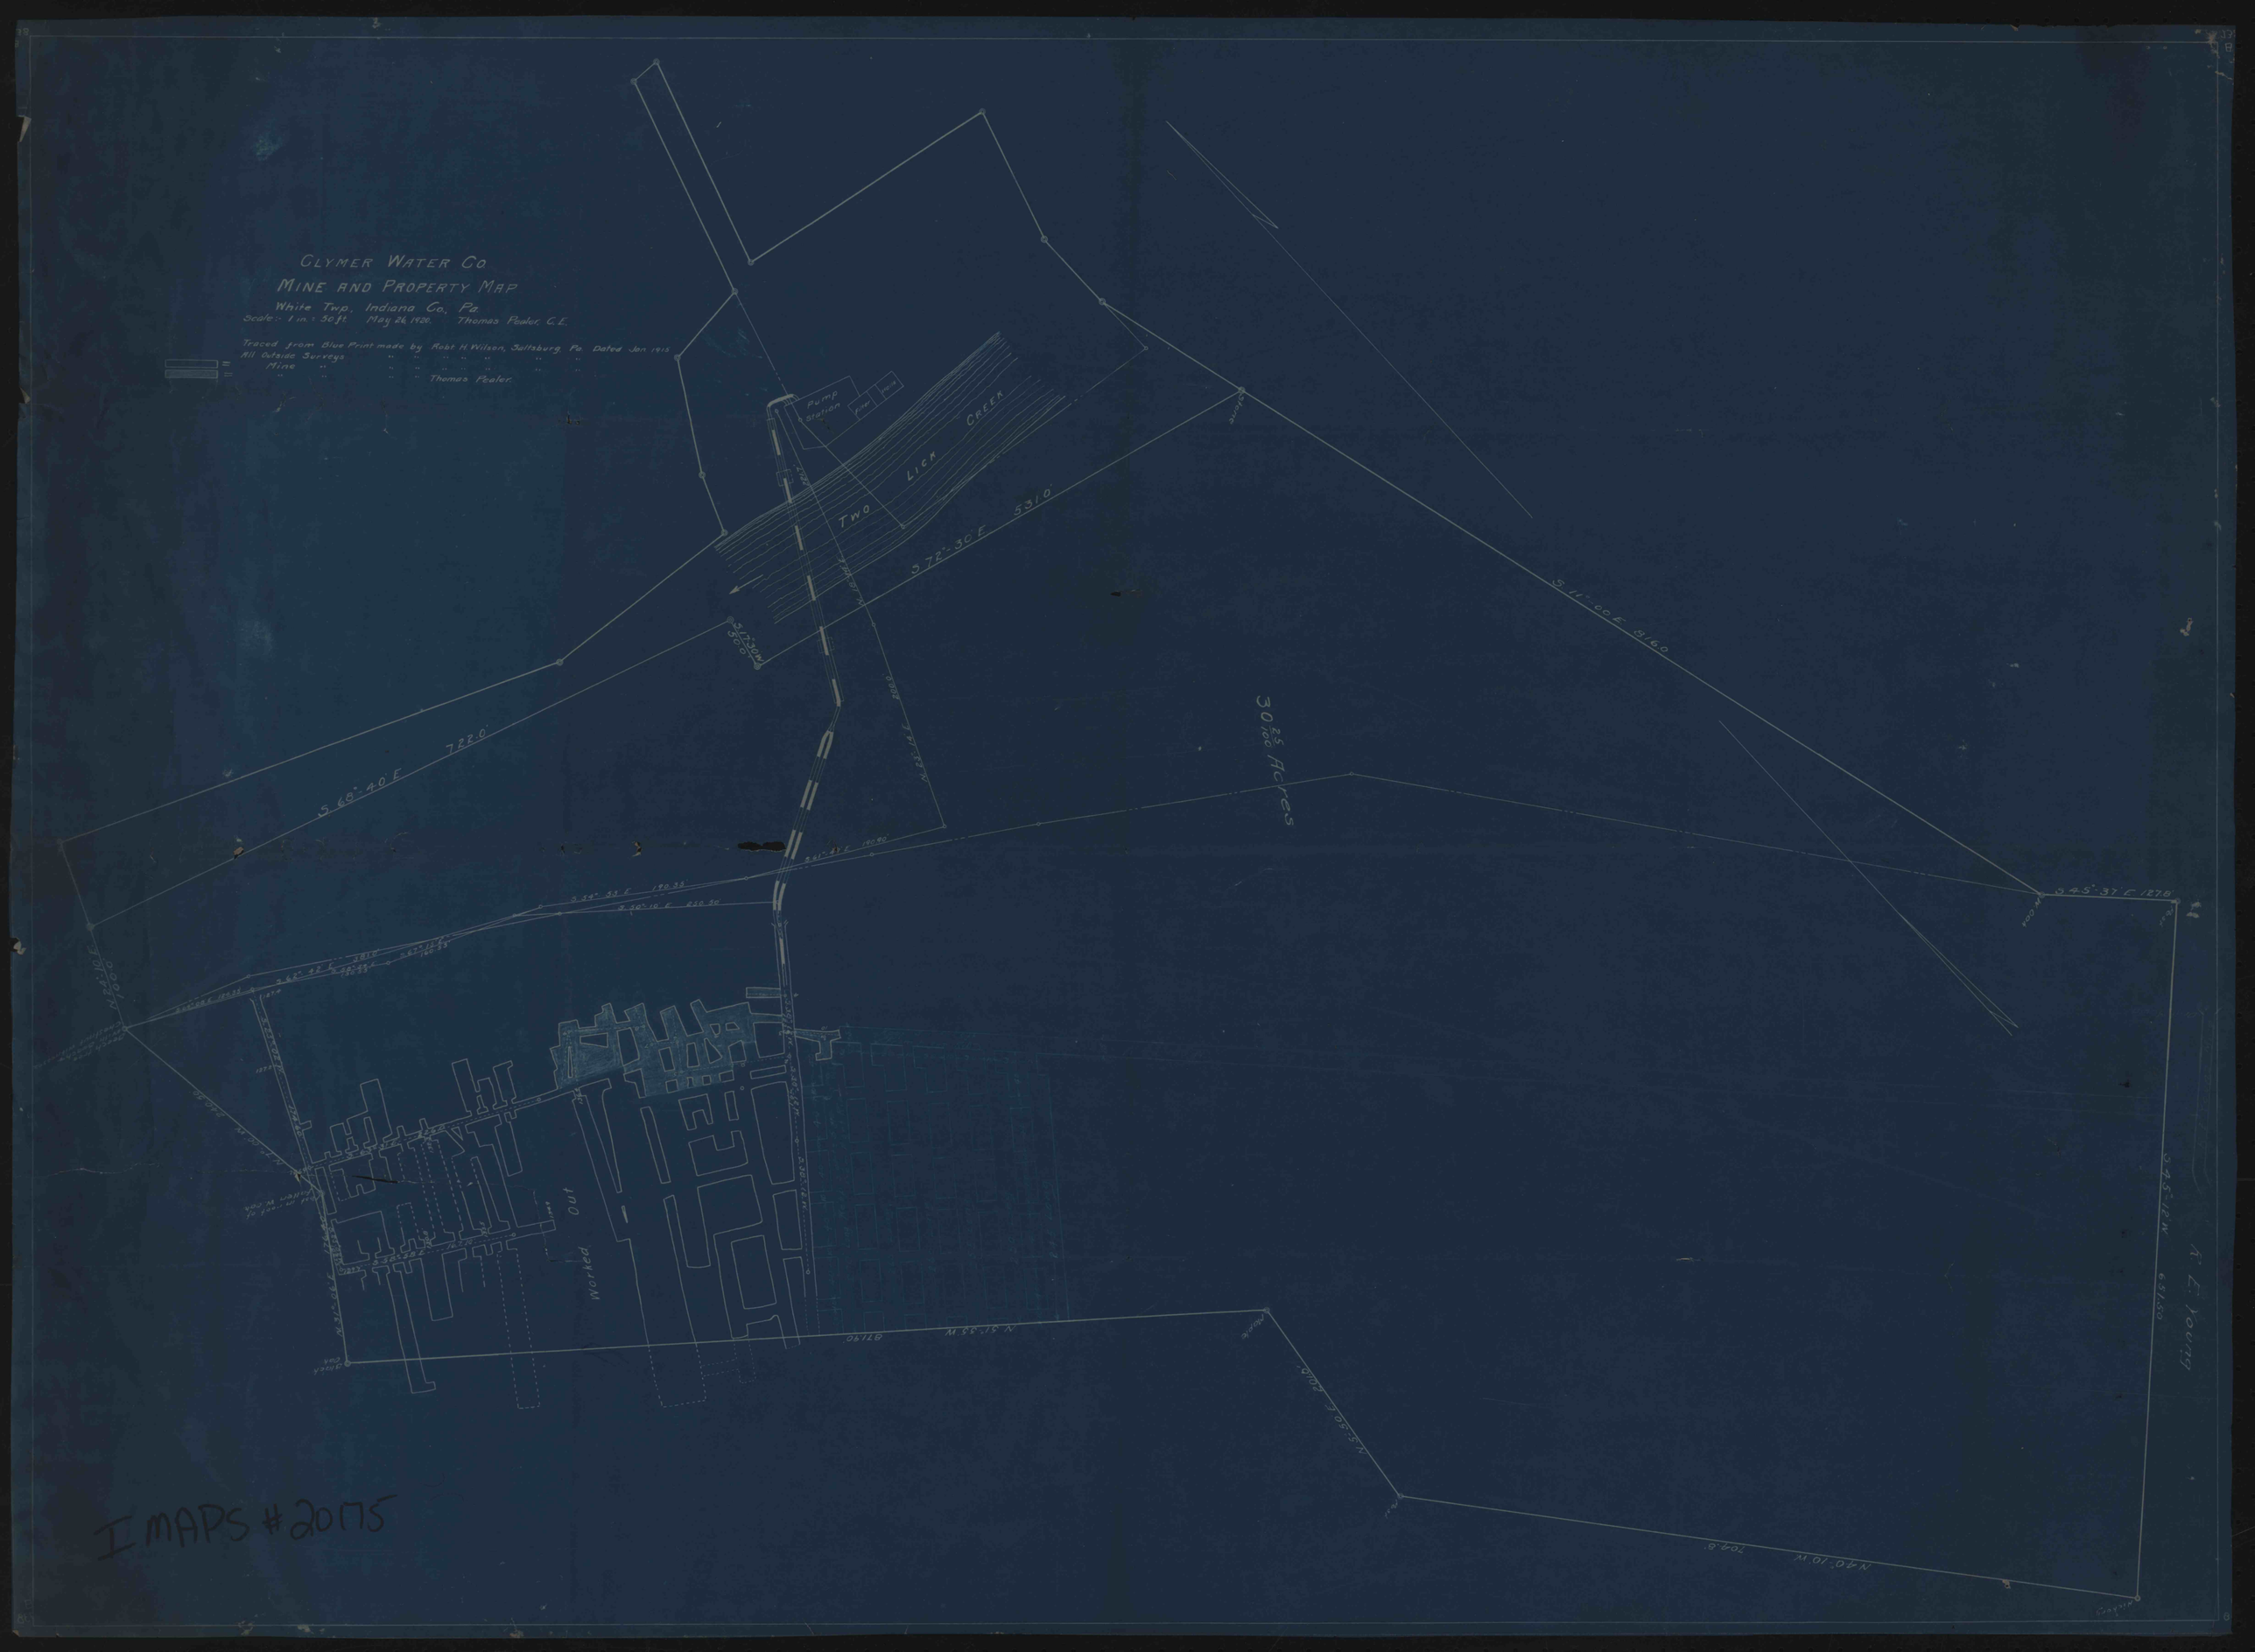
Clymer Water Co
Mine and Property Map
White Twp, Indiana Co, Pa
Scale: 1 in. = 50 ft. May 26, 1920. Thomas Fealer, C.E.
Traced from Blue Print made by Robt. H. Wilson, Saltsburg, Pa. Dated Jan. 1915
All Outside Surveys " " " " " " "
Mine " " " " " " "
" " " " Thomas Fealer.
Pump Station
Two Lick Creek
S 72° 30' E 531.0'
S 11° 00' E 316.0
S 66° 40' E 722.0'
30 25/100 Acres
S 45° 37' E 127.0
N 61° 35' W 1170
N 40° 10' W 709.8
Worked Out
A. E. Young

