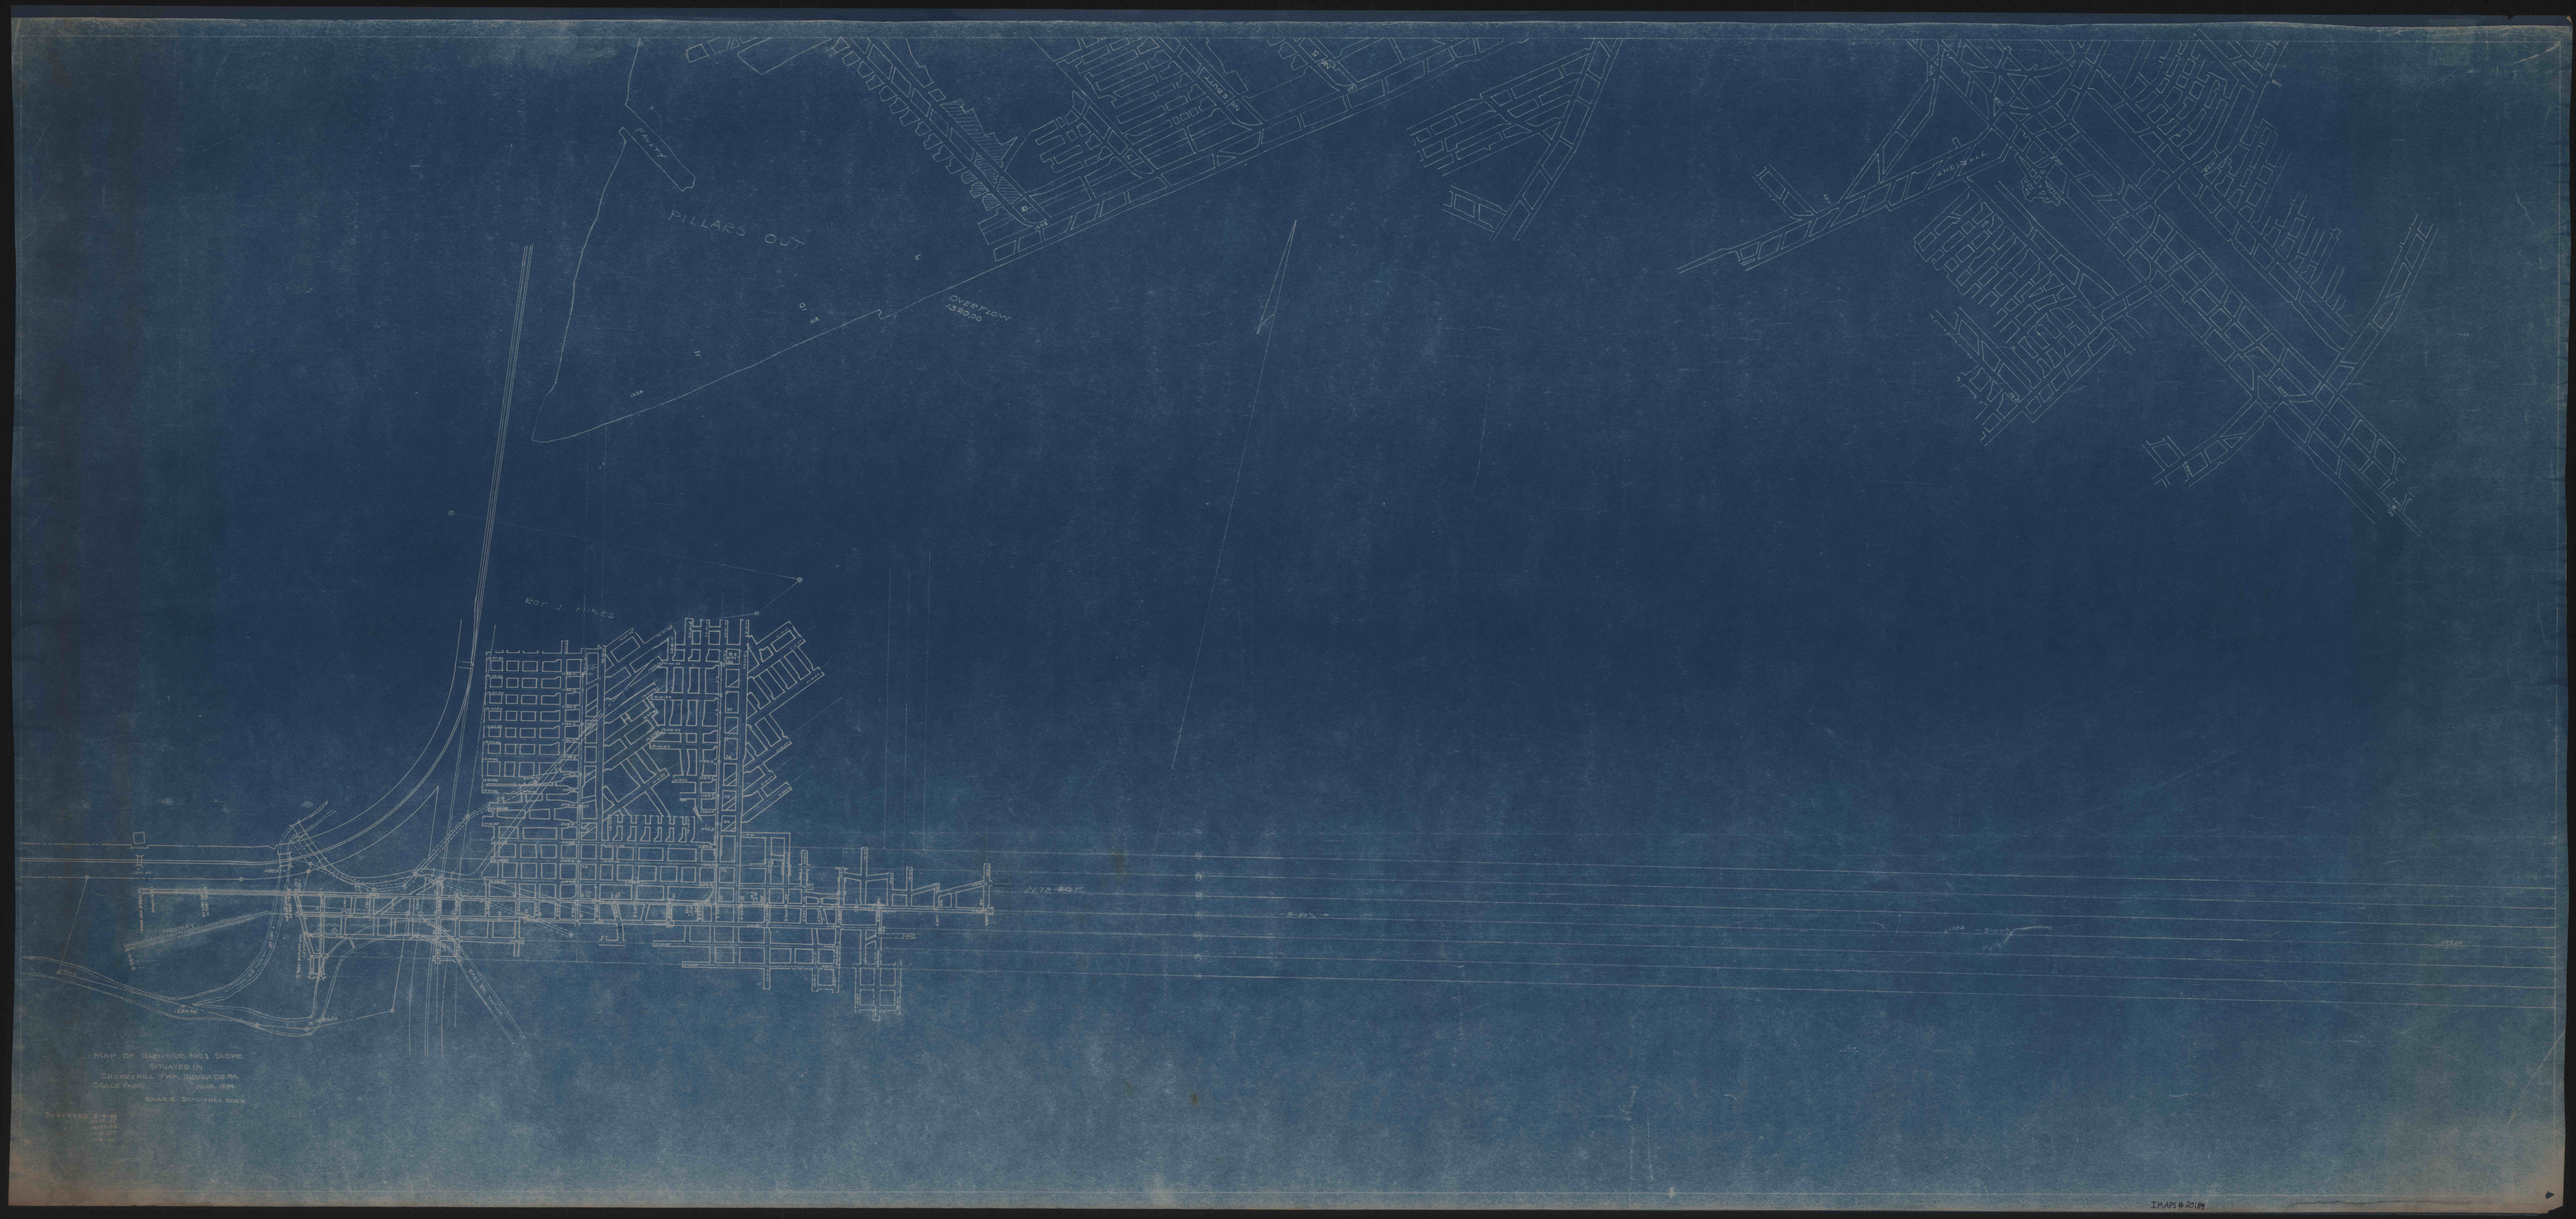
PILLARS OUT
OVERFLOW
ROT. J. MINES
MAP OF GLENSIDE NO 1 SLOPE
SITUATED IN
CHERRY HILL TWP. INDIANA CO. PA.
SCALE 1"=100'
JUNE 1934
CHAS. E. SCHUSHER CHIEF

IMAPS #20189