
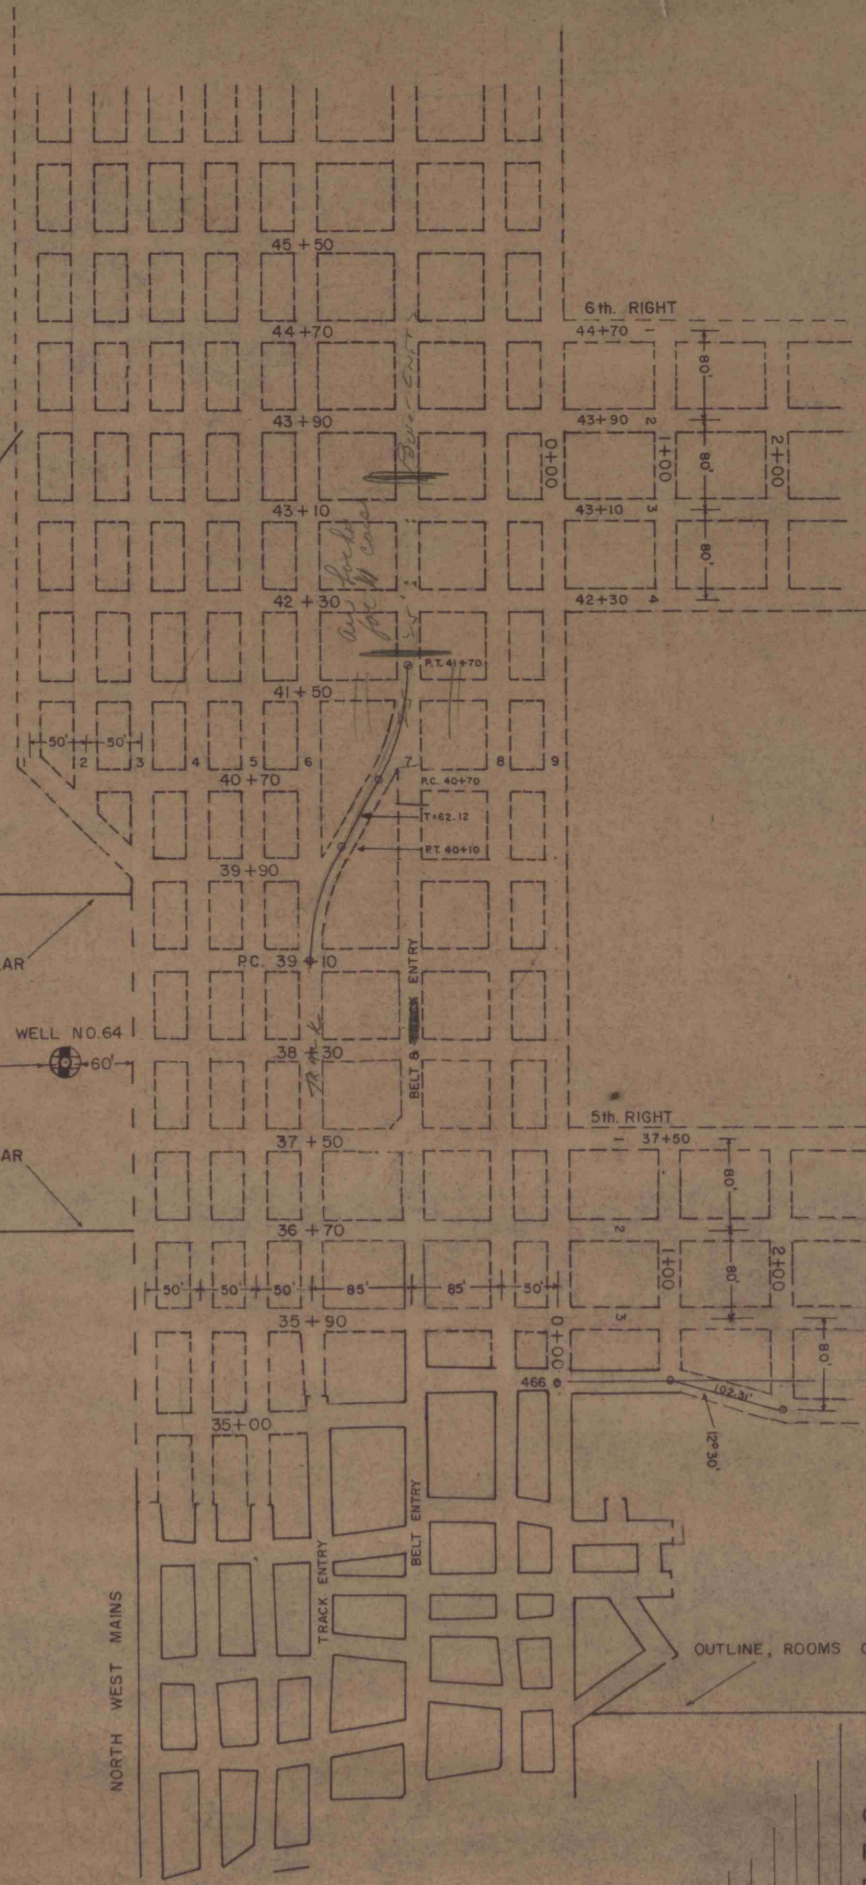
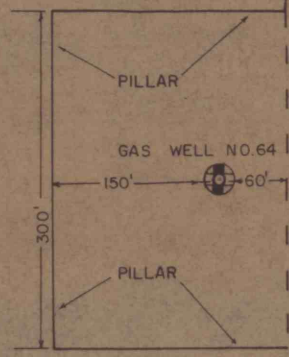
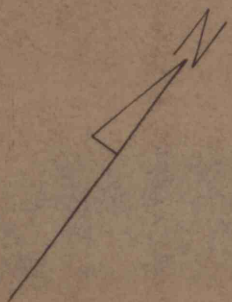


G. B. ROBINSON

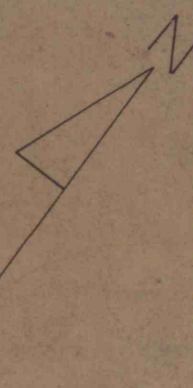

ONEIDA NO. 4 MINE
 PROJECTION- N.W. MAINS
 DATE: 11-30-70
 SCALE: 1" = 100'
 BY: *D.H.C.*
 REVISED: 1-22-71