


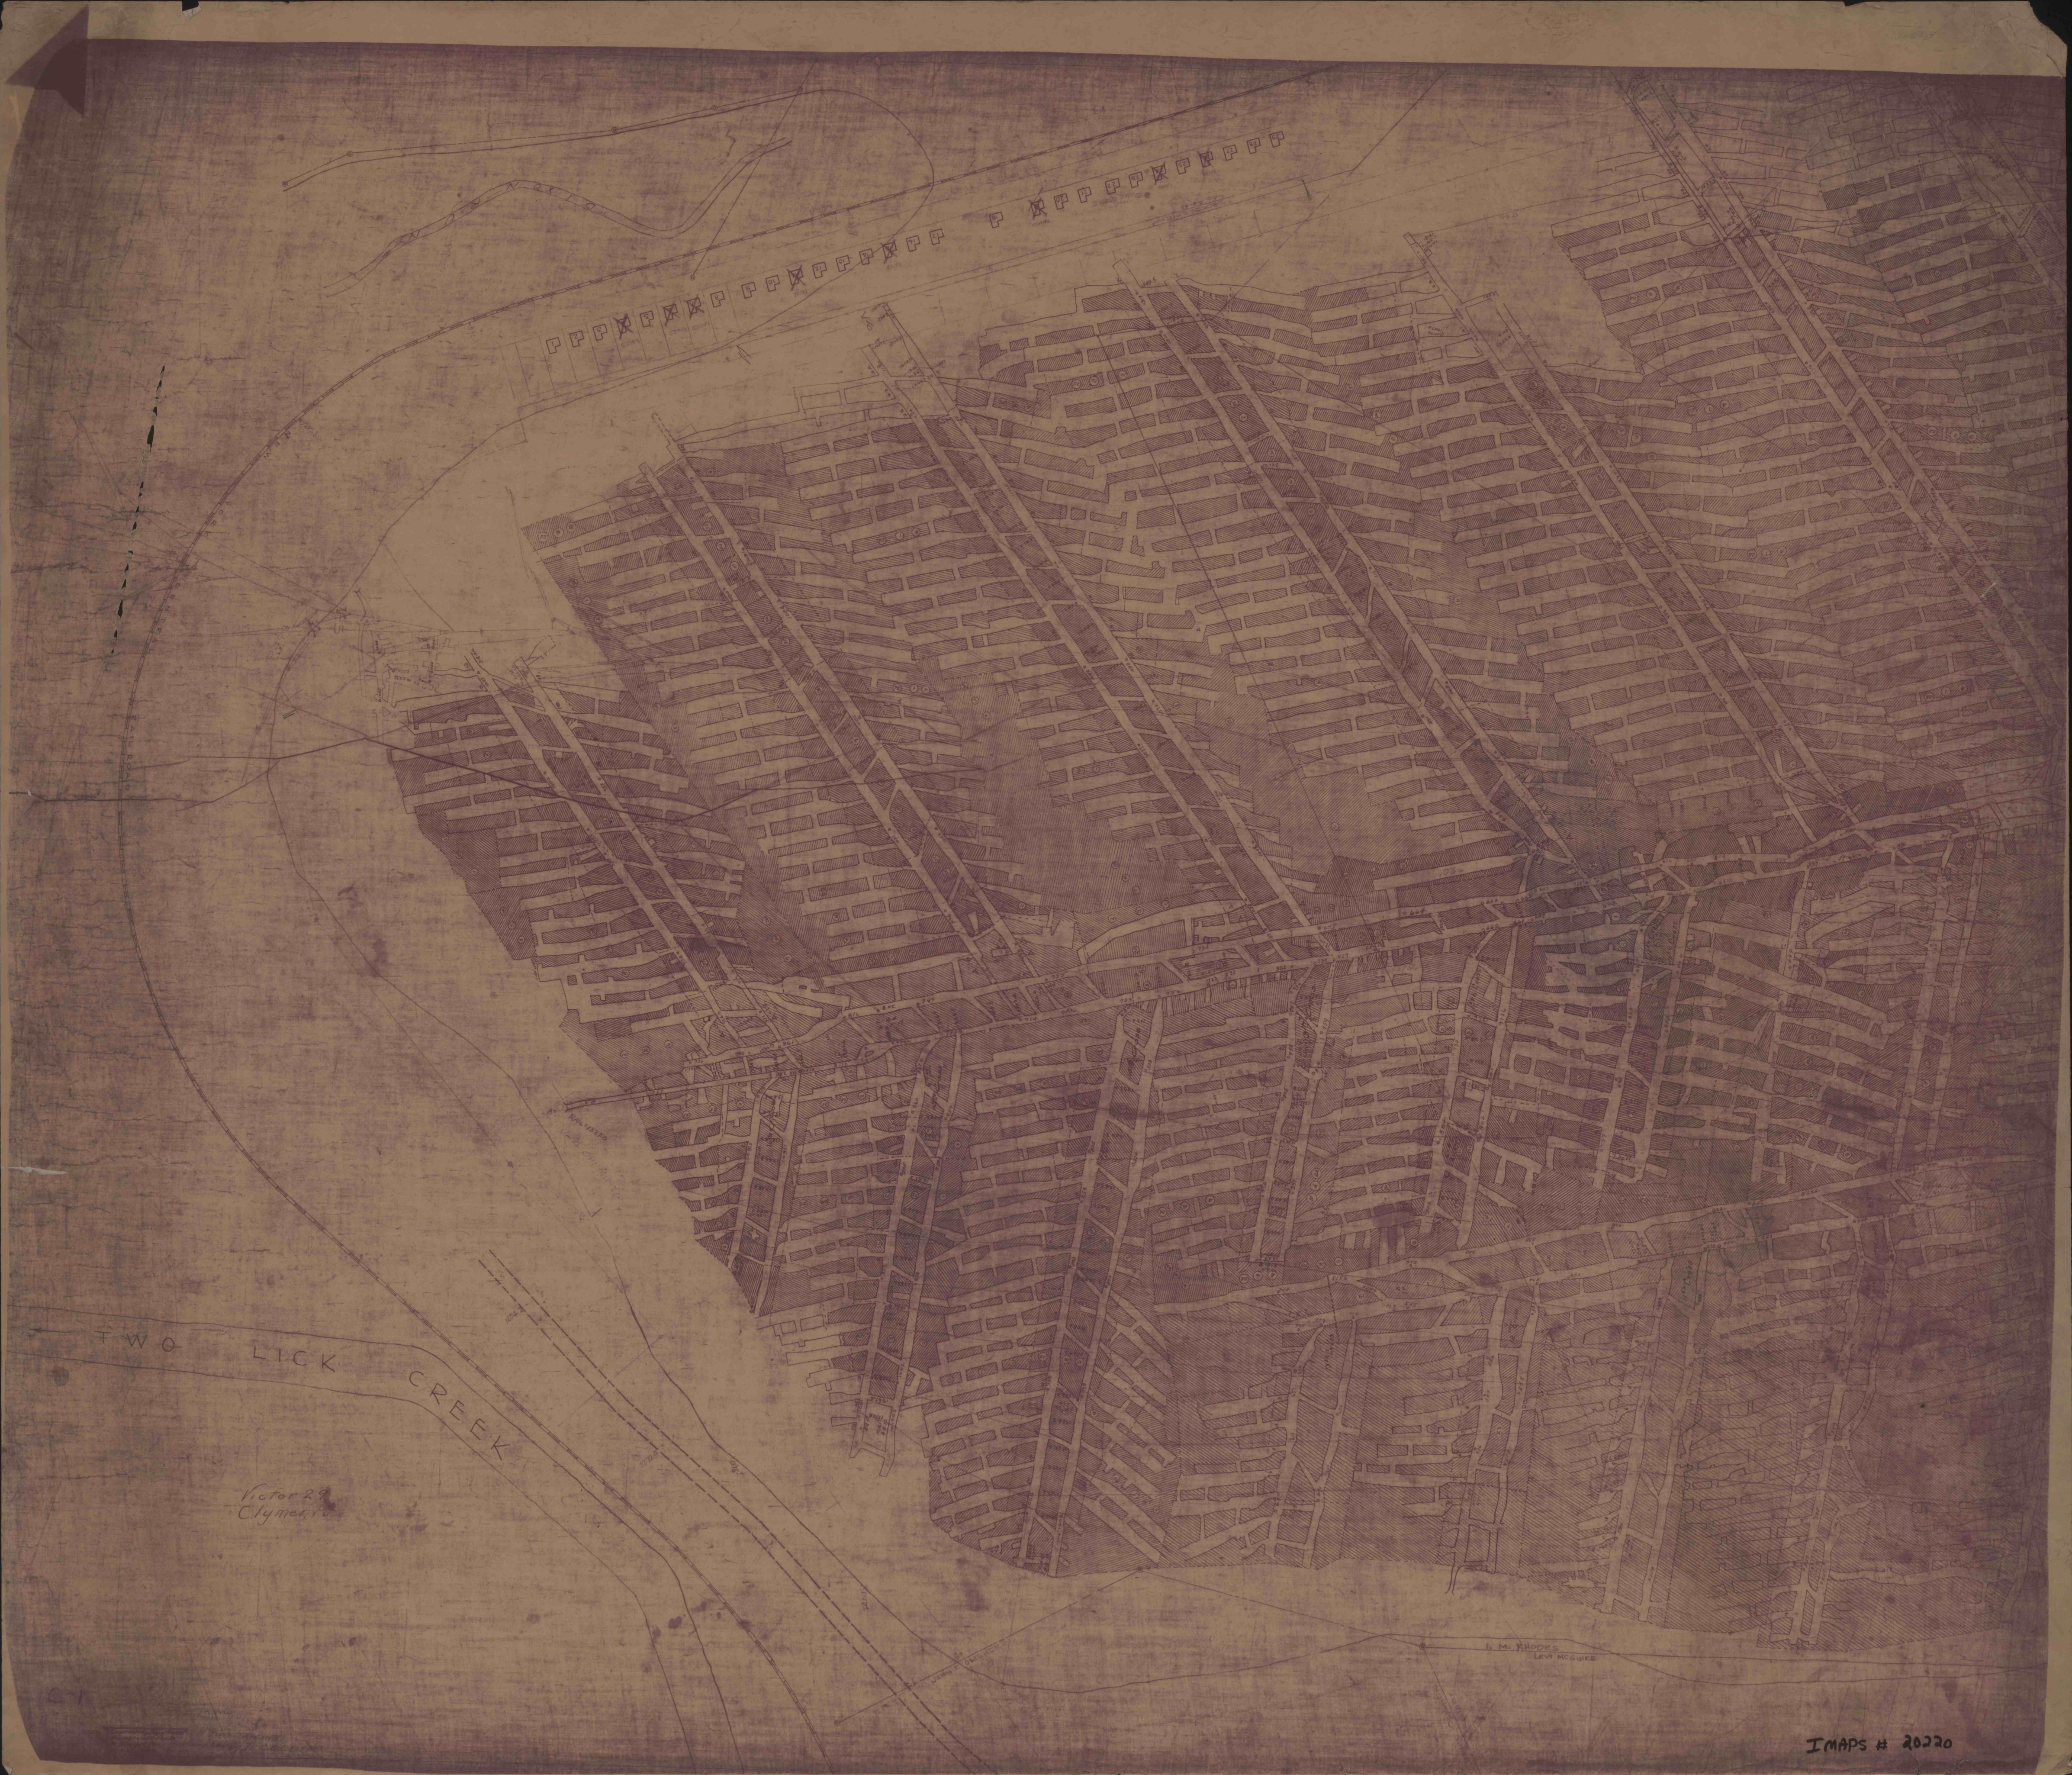

TWO LICK
CREEK

Victor 29
Clymer, Pa.

L. M. RHODES
LEW. MCGUIRE