

UNITED STATES
DEPARTMENT OF THE INTERIOR
GEOLOGICAL SURVEY

STATE OF PENNSYLVANIA
REPRESENTED BY THE
DEPARTMENT OF INTERNAL AFFAIRS
TOPOGRAPHIC AND GEOLOGIC SURVEY
(Smithburg)


PENNSYLVANIA
INDIANA QUADRANGLE



no 1/1
Dry hole
9/10 mile well
MEGLU/ nothin 4203
7/10/112 3-W 84A
7/10/112 3-W 84A
per 20114
Megan

3347
shallow
overhang
1036
dry
115617
at mouth
115617
at mouth
115617
at mouth

H.M. Wilson, Geographer in charge.
Control by A.H. Thompson, Frank Sutton and J.D. Forster.
Topography by Frank Sutton and T.G. Baesinger.
Surveyed in 1900 in cooperation with the State of Pennsylvania.

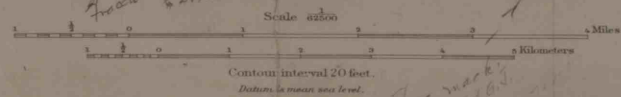

Edition of Feb. 1902, reprinted 1944.
Polyconic projection North American datum.

INDIANA PA.
NACSS-2100-1