


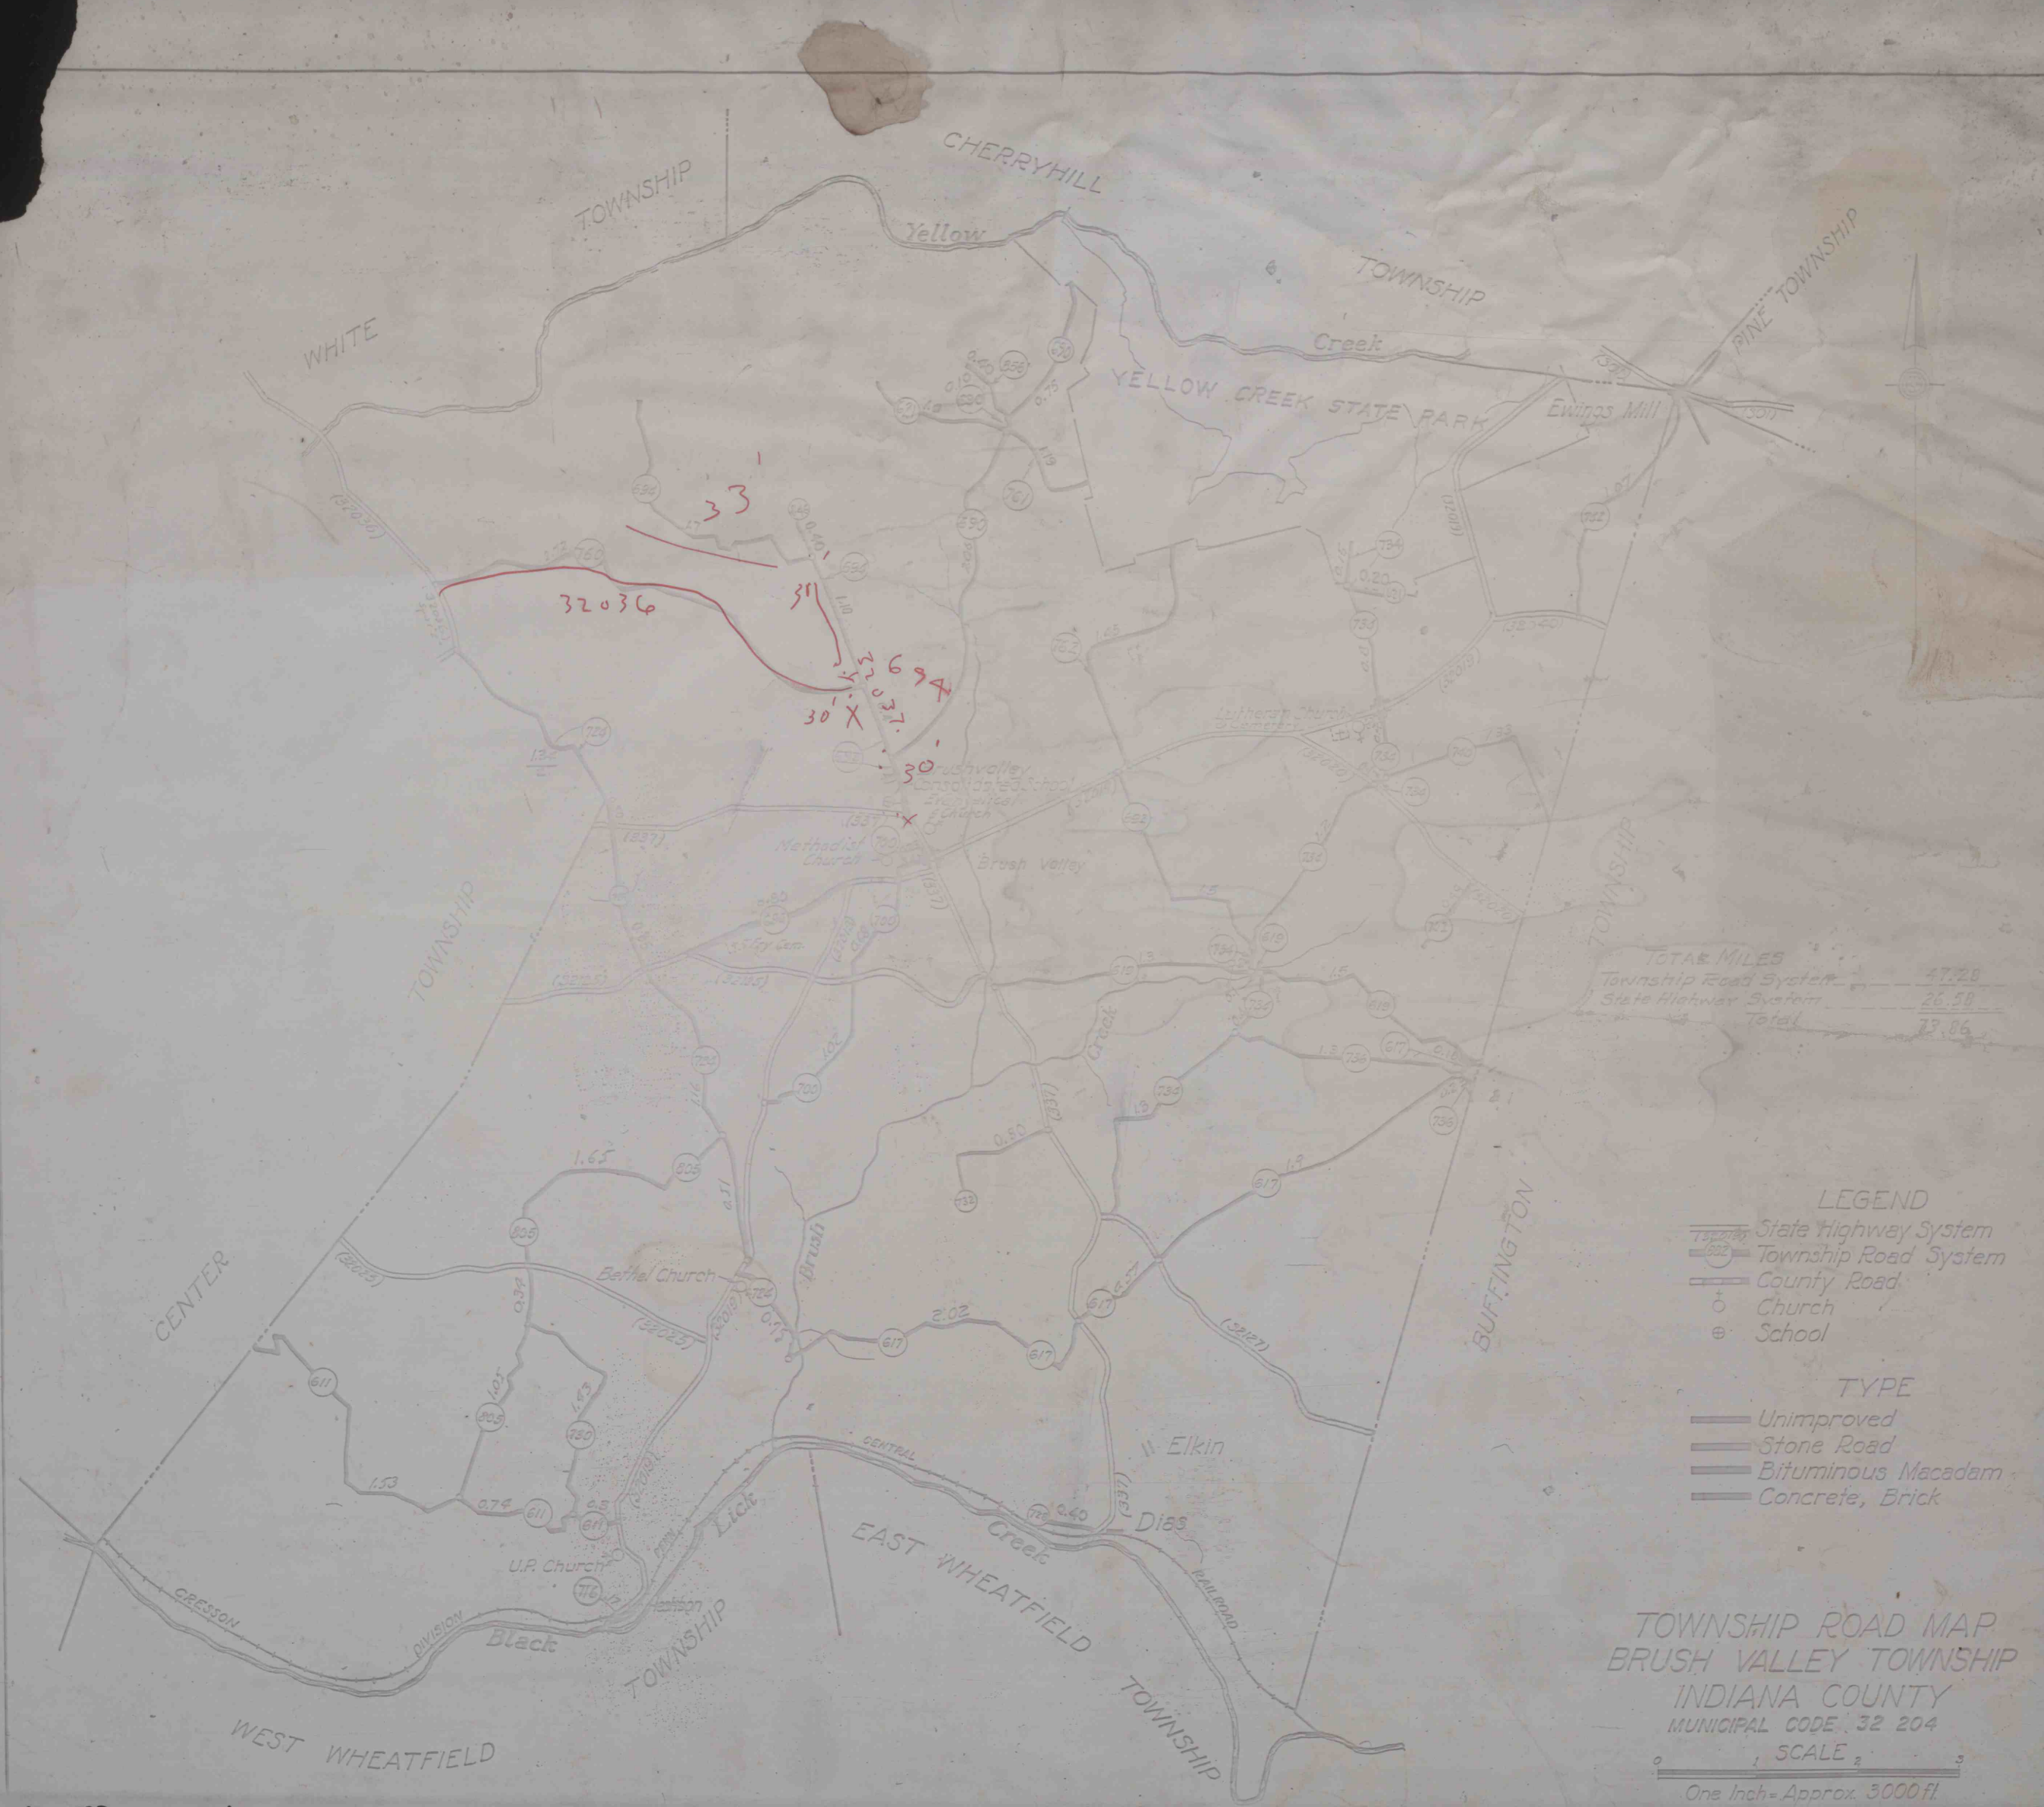

TOTAL MILES

Township Road System	47.28
State Highway System	26.58
Total	73.86

- LEGEND
- State Highway System
 - Township Road System
 - County Road
 - Church
 - School

- TYPE
- Unimproved
 - Stone Road
 - Bituminous Macadam
 - Concrete, Brick

TOWNSHIP ROAD MAP
BRUSH VALLEY TOWNSHIP
INDIANA COUNTY
MUNICIPAL CODE 32 204
SCALE
One Inch = Approx. 3000 ft.