


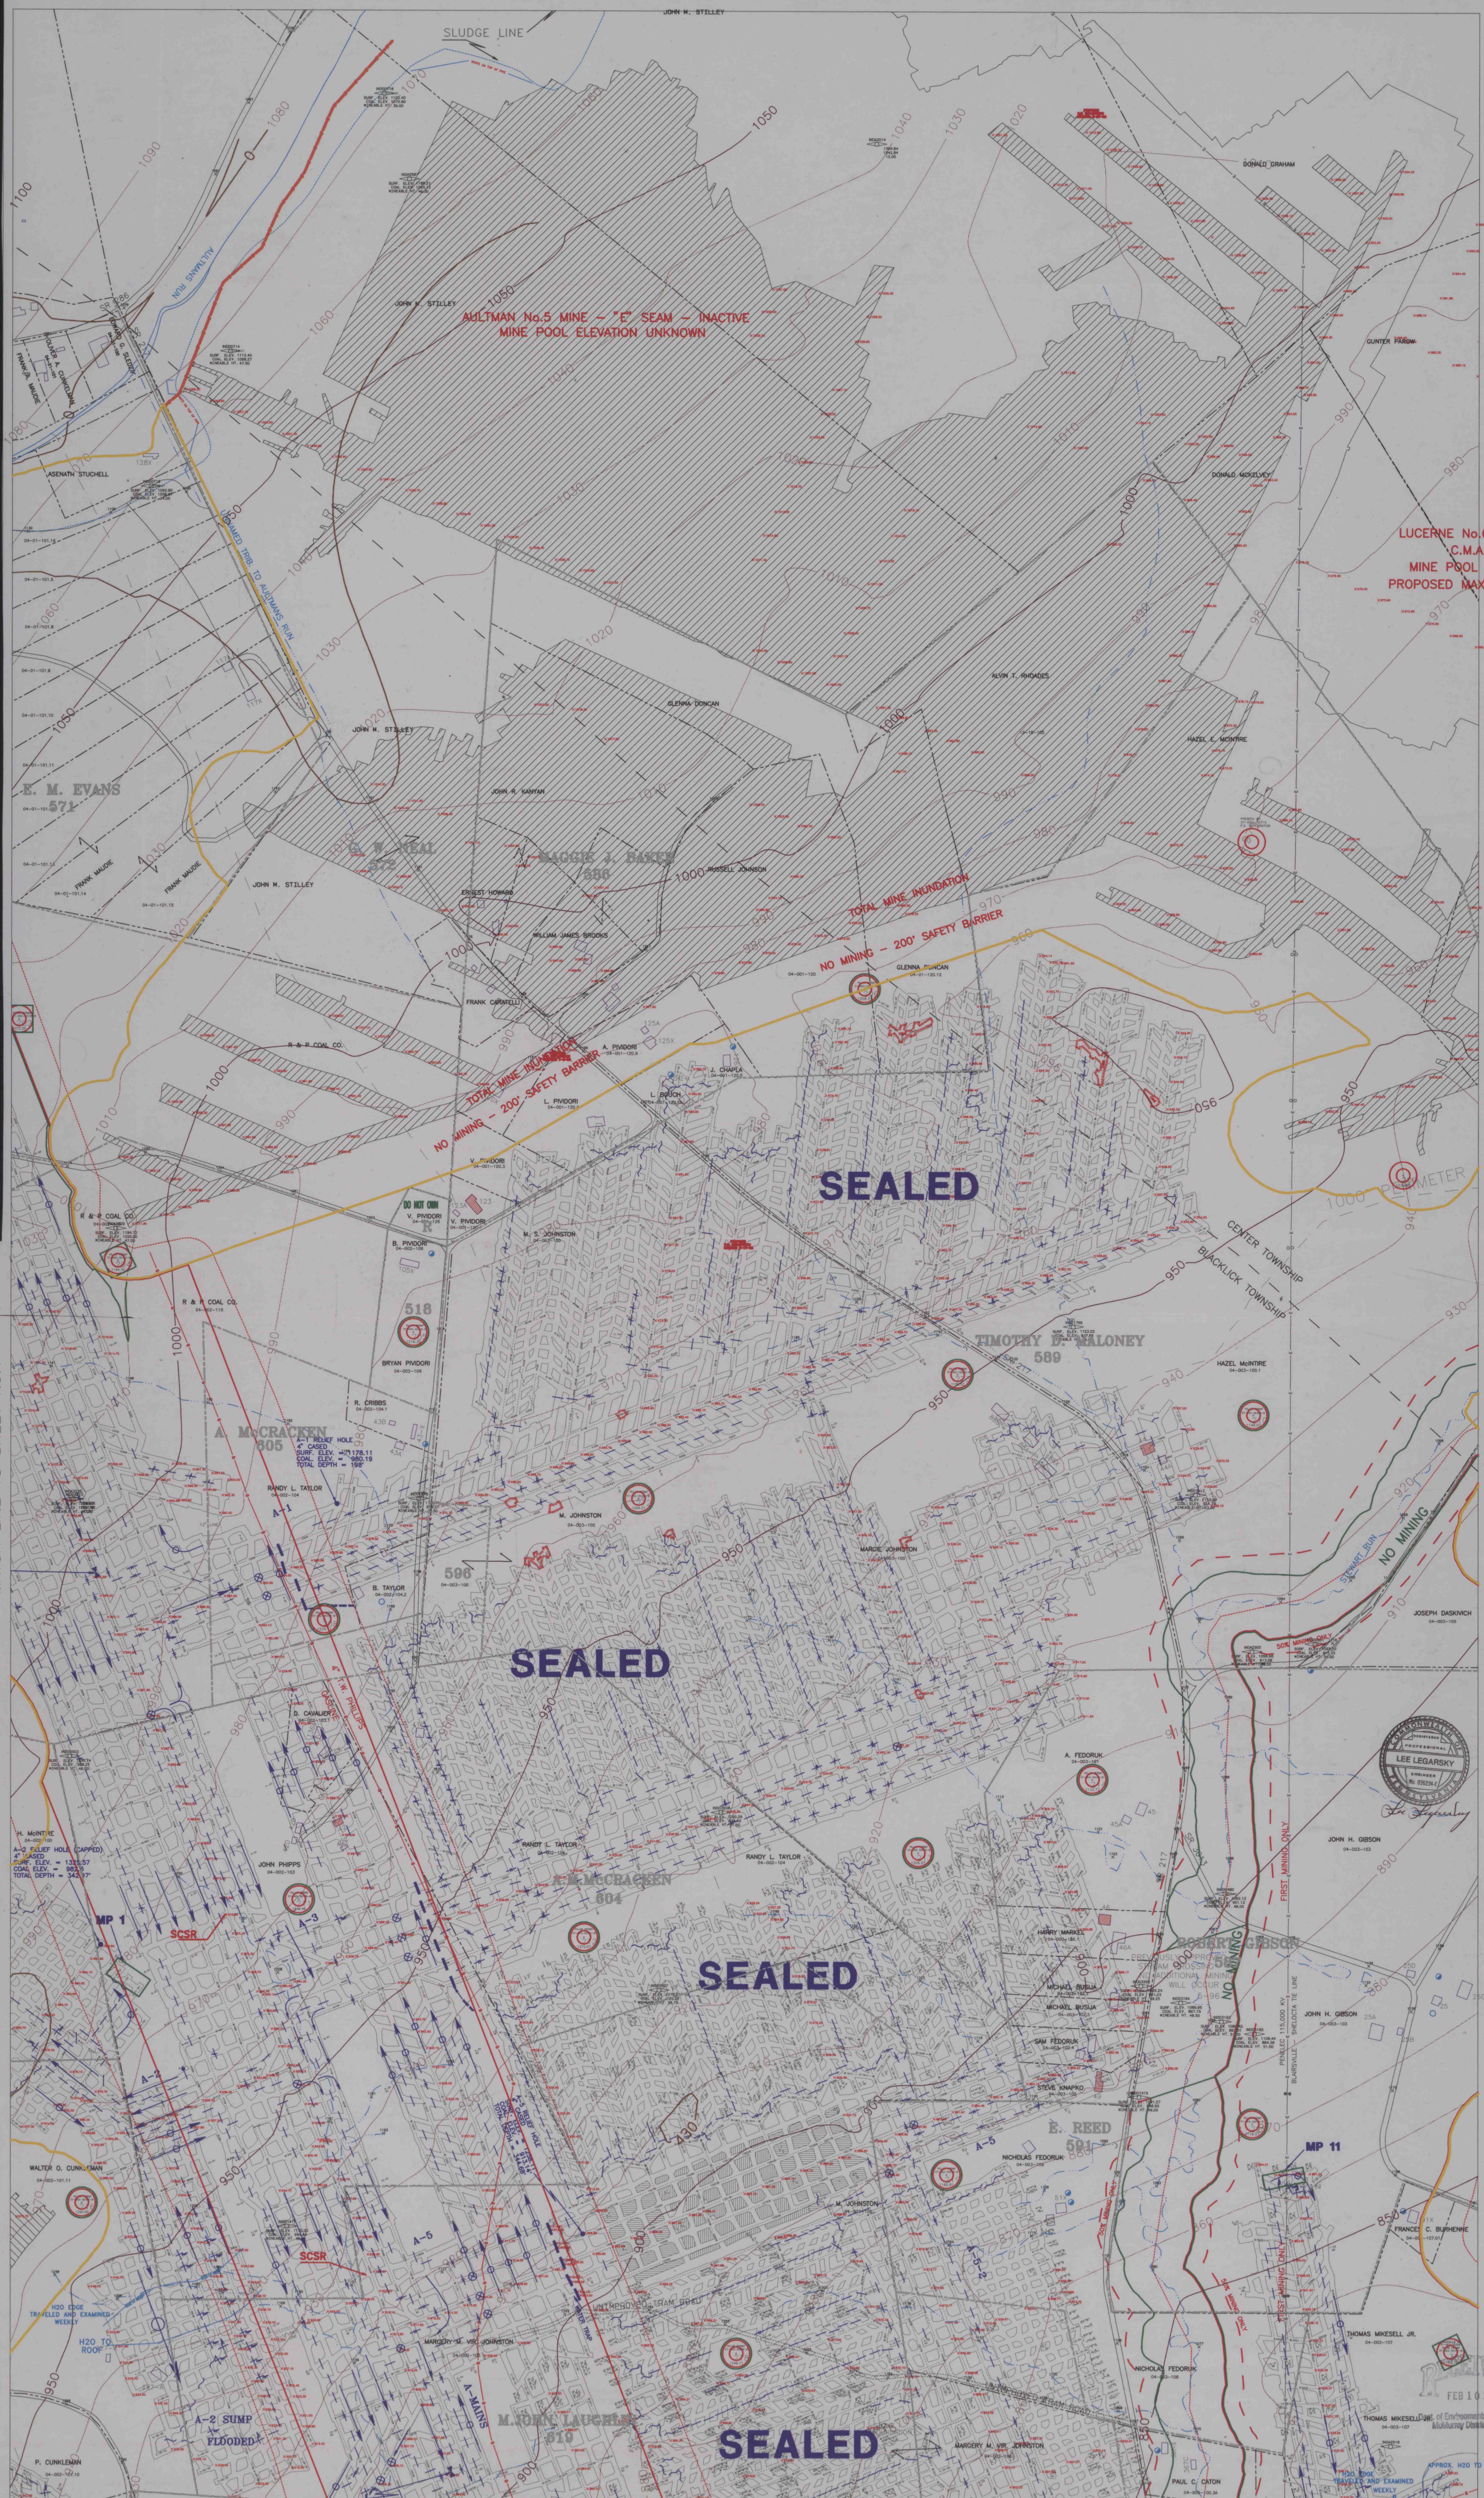

MATCH LINE TO SHEET No. 5

FINAL MINE MAP

POSTED 12-31-1999