


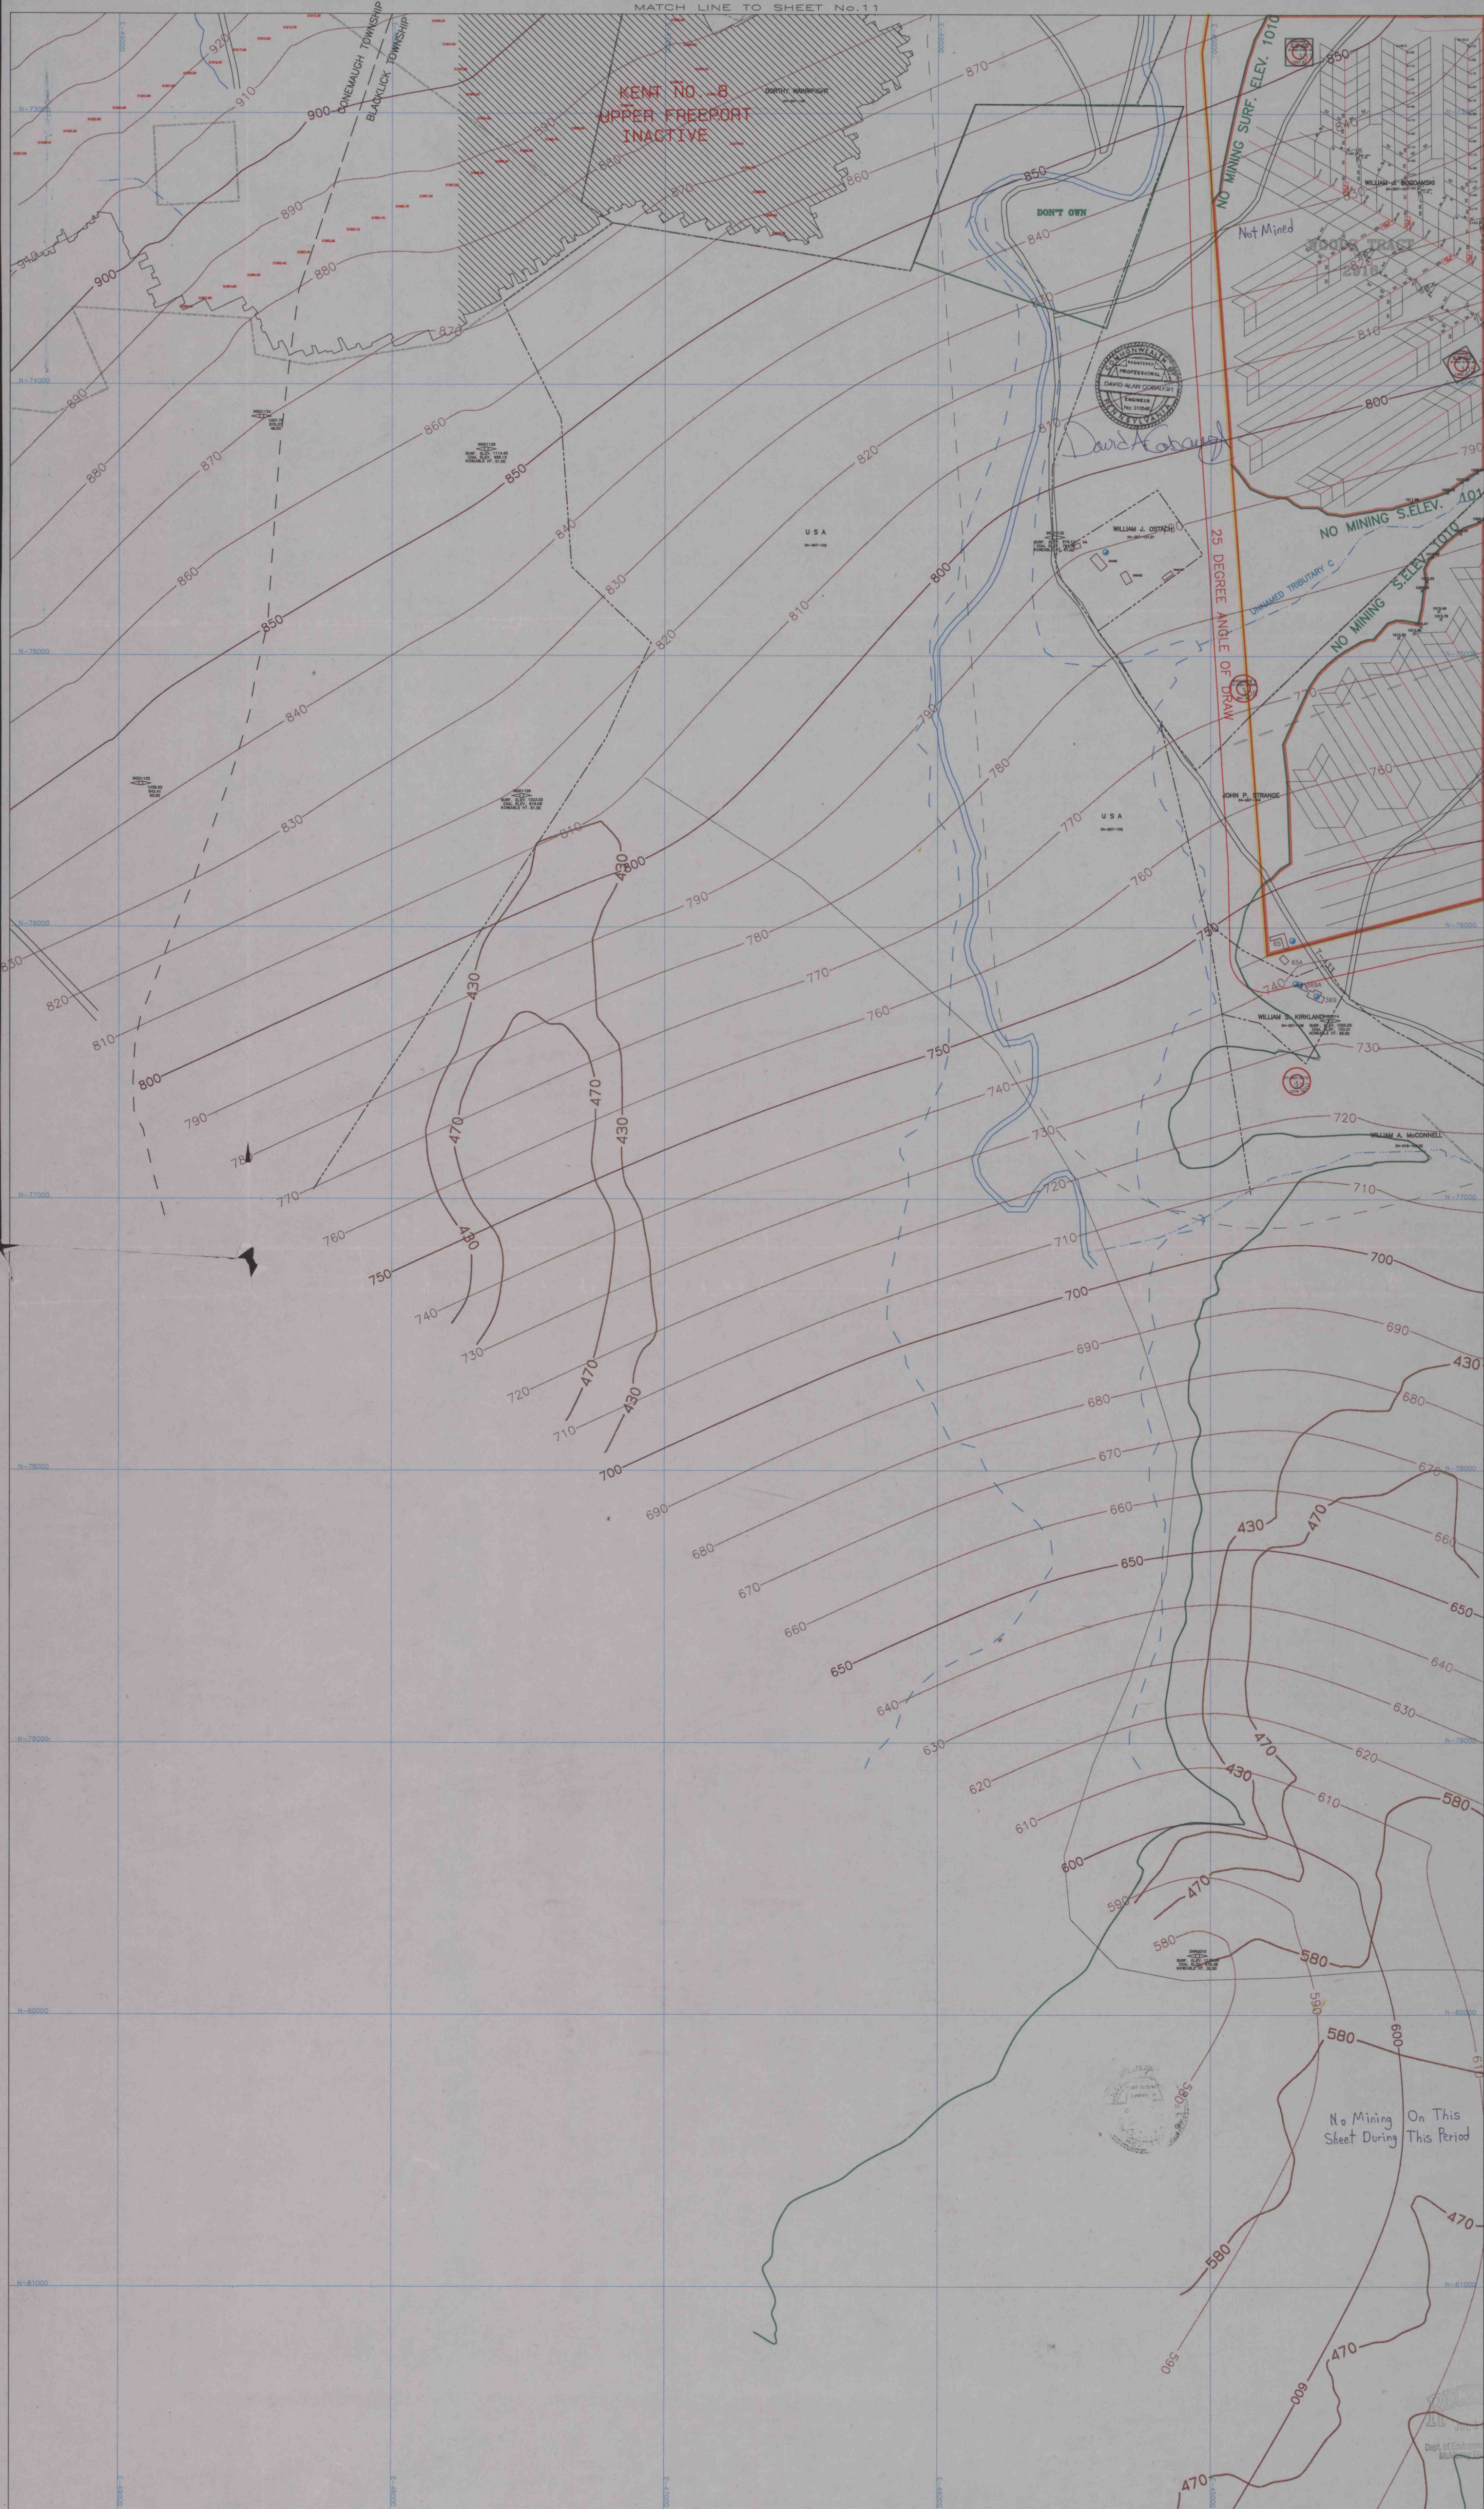

MATCH LINE TO SHEET No.13

CONTEMPLATED MINING FROM 7-1-98 TO 1-1-99

POSTED 7-1-98

NO MINING ON THIS SHEET DURING THIS PERIOD