


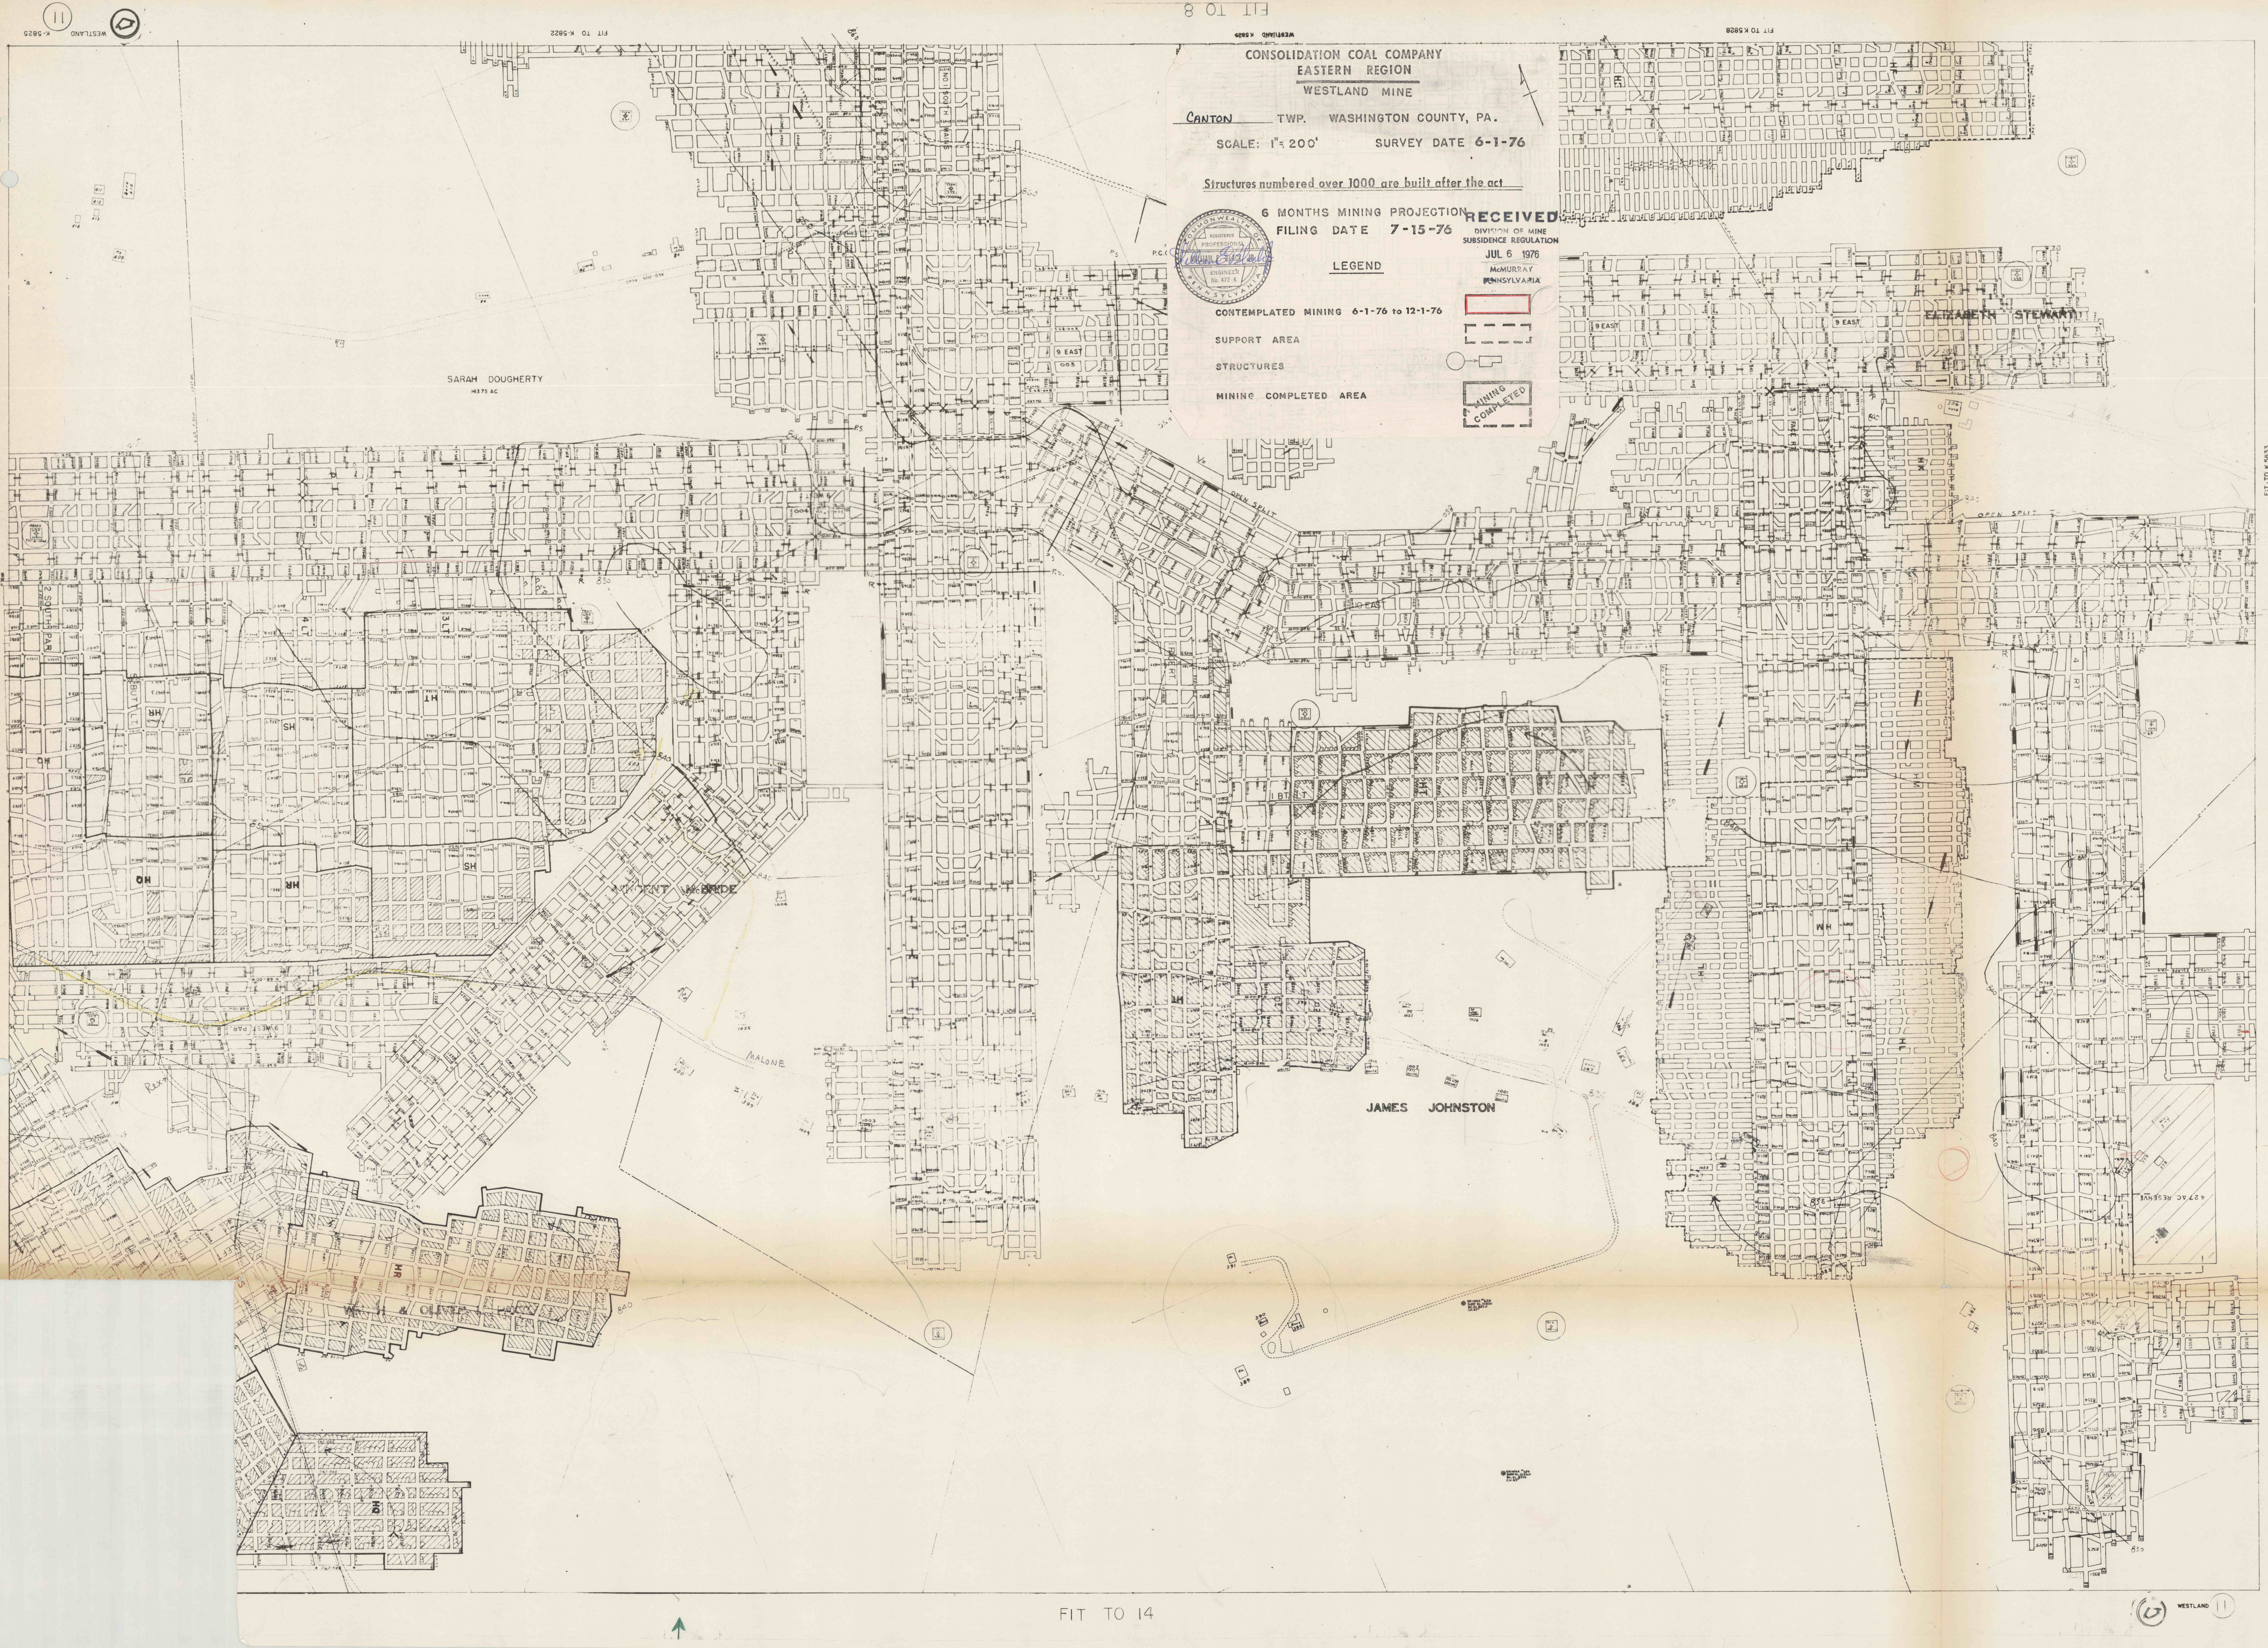

CONSOLIDATION COAL COMPANY
EASTERN REGION
WESTLAND MINE
CANTON TWP. WASHINGTON COUNTY, PA.
SCALE: 1" = 200' SURVEY DATE 6-1-76
Structures numbered over 1000 are built after the act

6 MONTHS MINING PROJECTION
FILING DATE 7-15-76

RECEIVED
DIVISION OF MINE
SUBSIDENCE REGULATION
JUL 6 1976
MCMURRAY
PENNSYLVANIA

LEGEND

- CONTEMPLATED MINING 6-1-76 to 12-1-76
- SUPPORT AREA
- STRUCTURES
- MINING COMPLETED AREA

MINING COMPLETED