


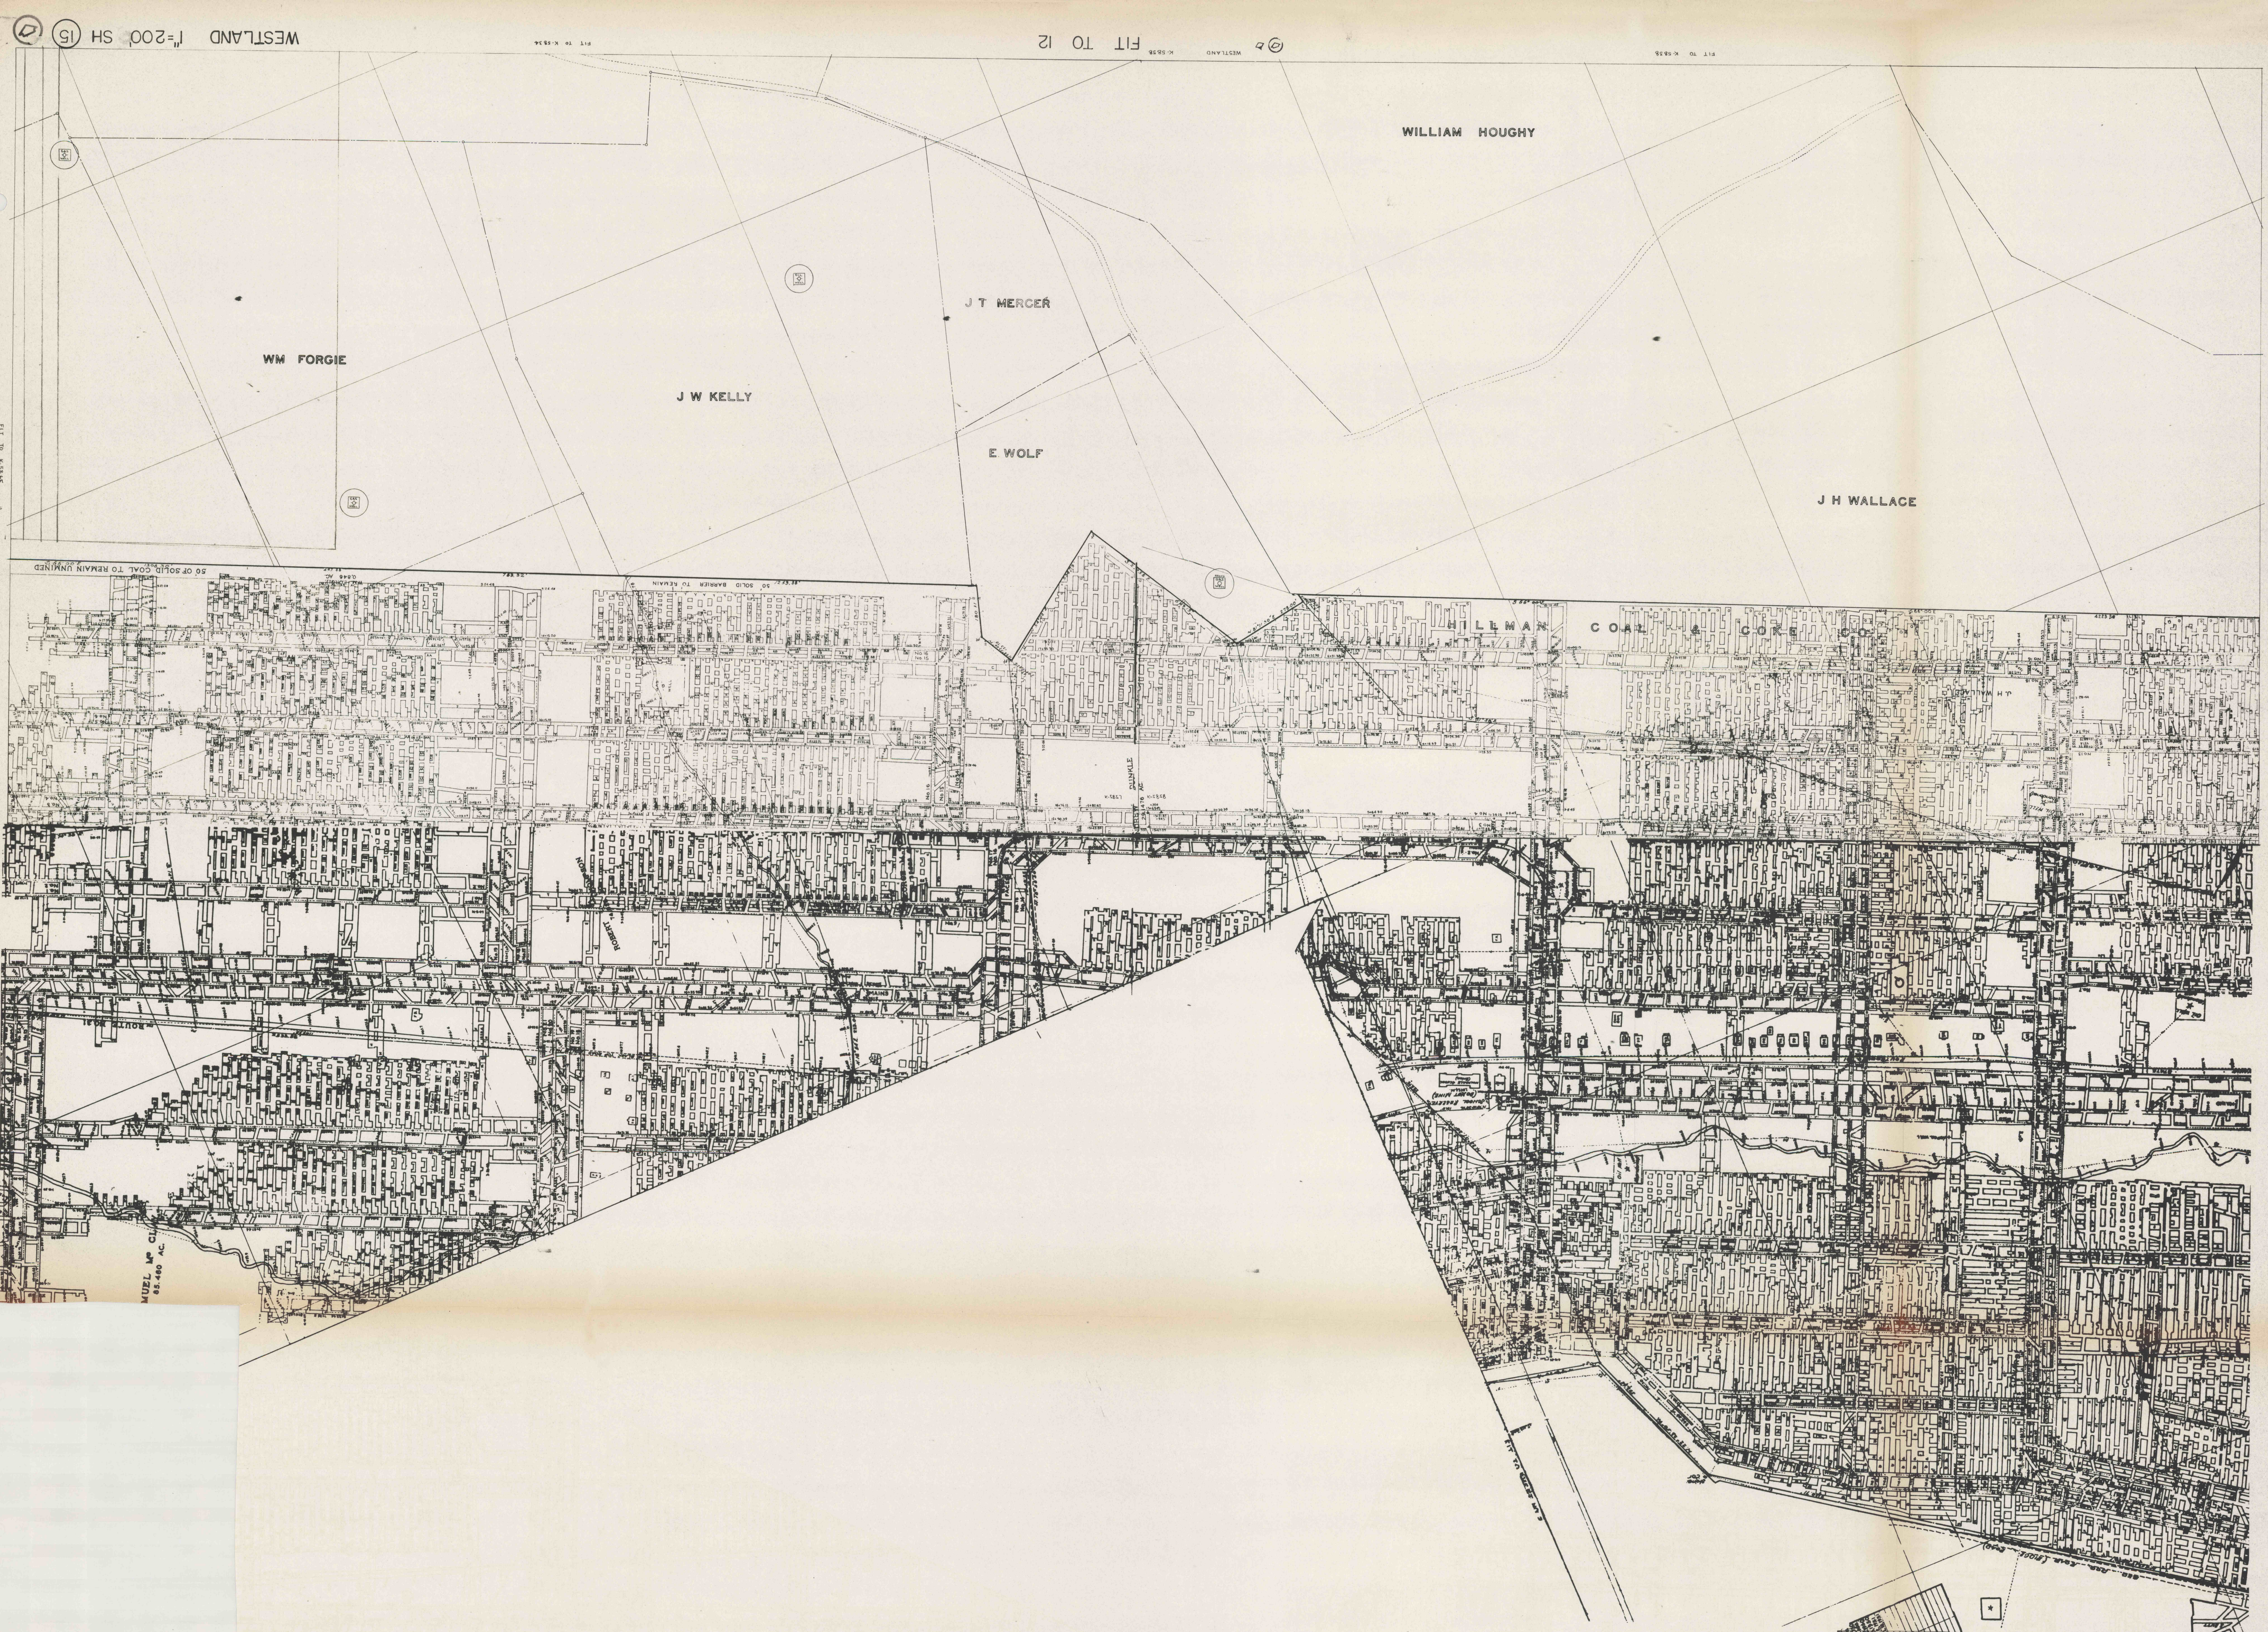

WILLIAM HOUGHY

J T MERCER

E WOLF

J W KELLY

WM FORGIE

J H WALLACE

HILLMAN COAL & COKE CO