


PITTSBURGH COAL COMPANY
WESTLAND MINE
Chartiers TWP. WASHINGTON COUNTY, PA.
SCALE: 1"=200' SURVEY DATE 7-1-68



6 MONTHS MINING PROJECTION
FILING DATE 8-15-68

LEGEND

- CONTEMPLATED MINING 7-1-68 TO 1-1-69
- SUPPORT AREA
- STRUCTURES
- MINING COMPLETED AREA

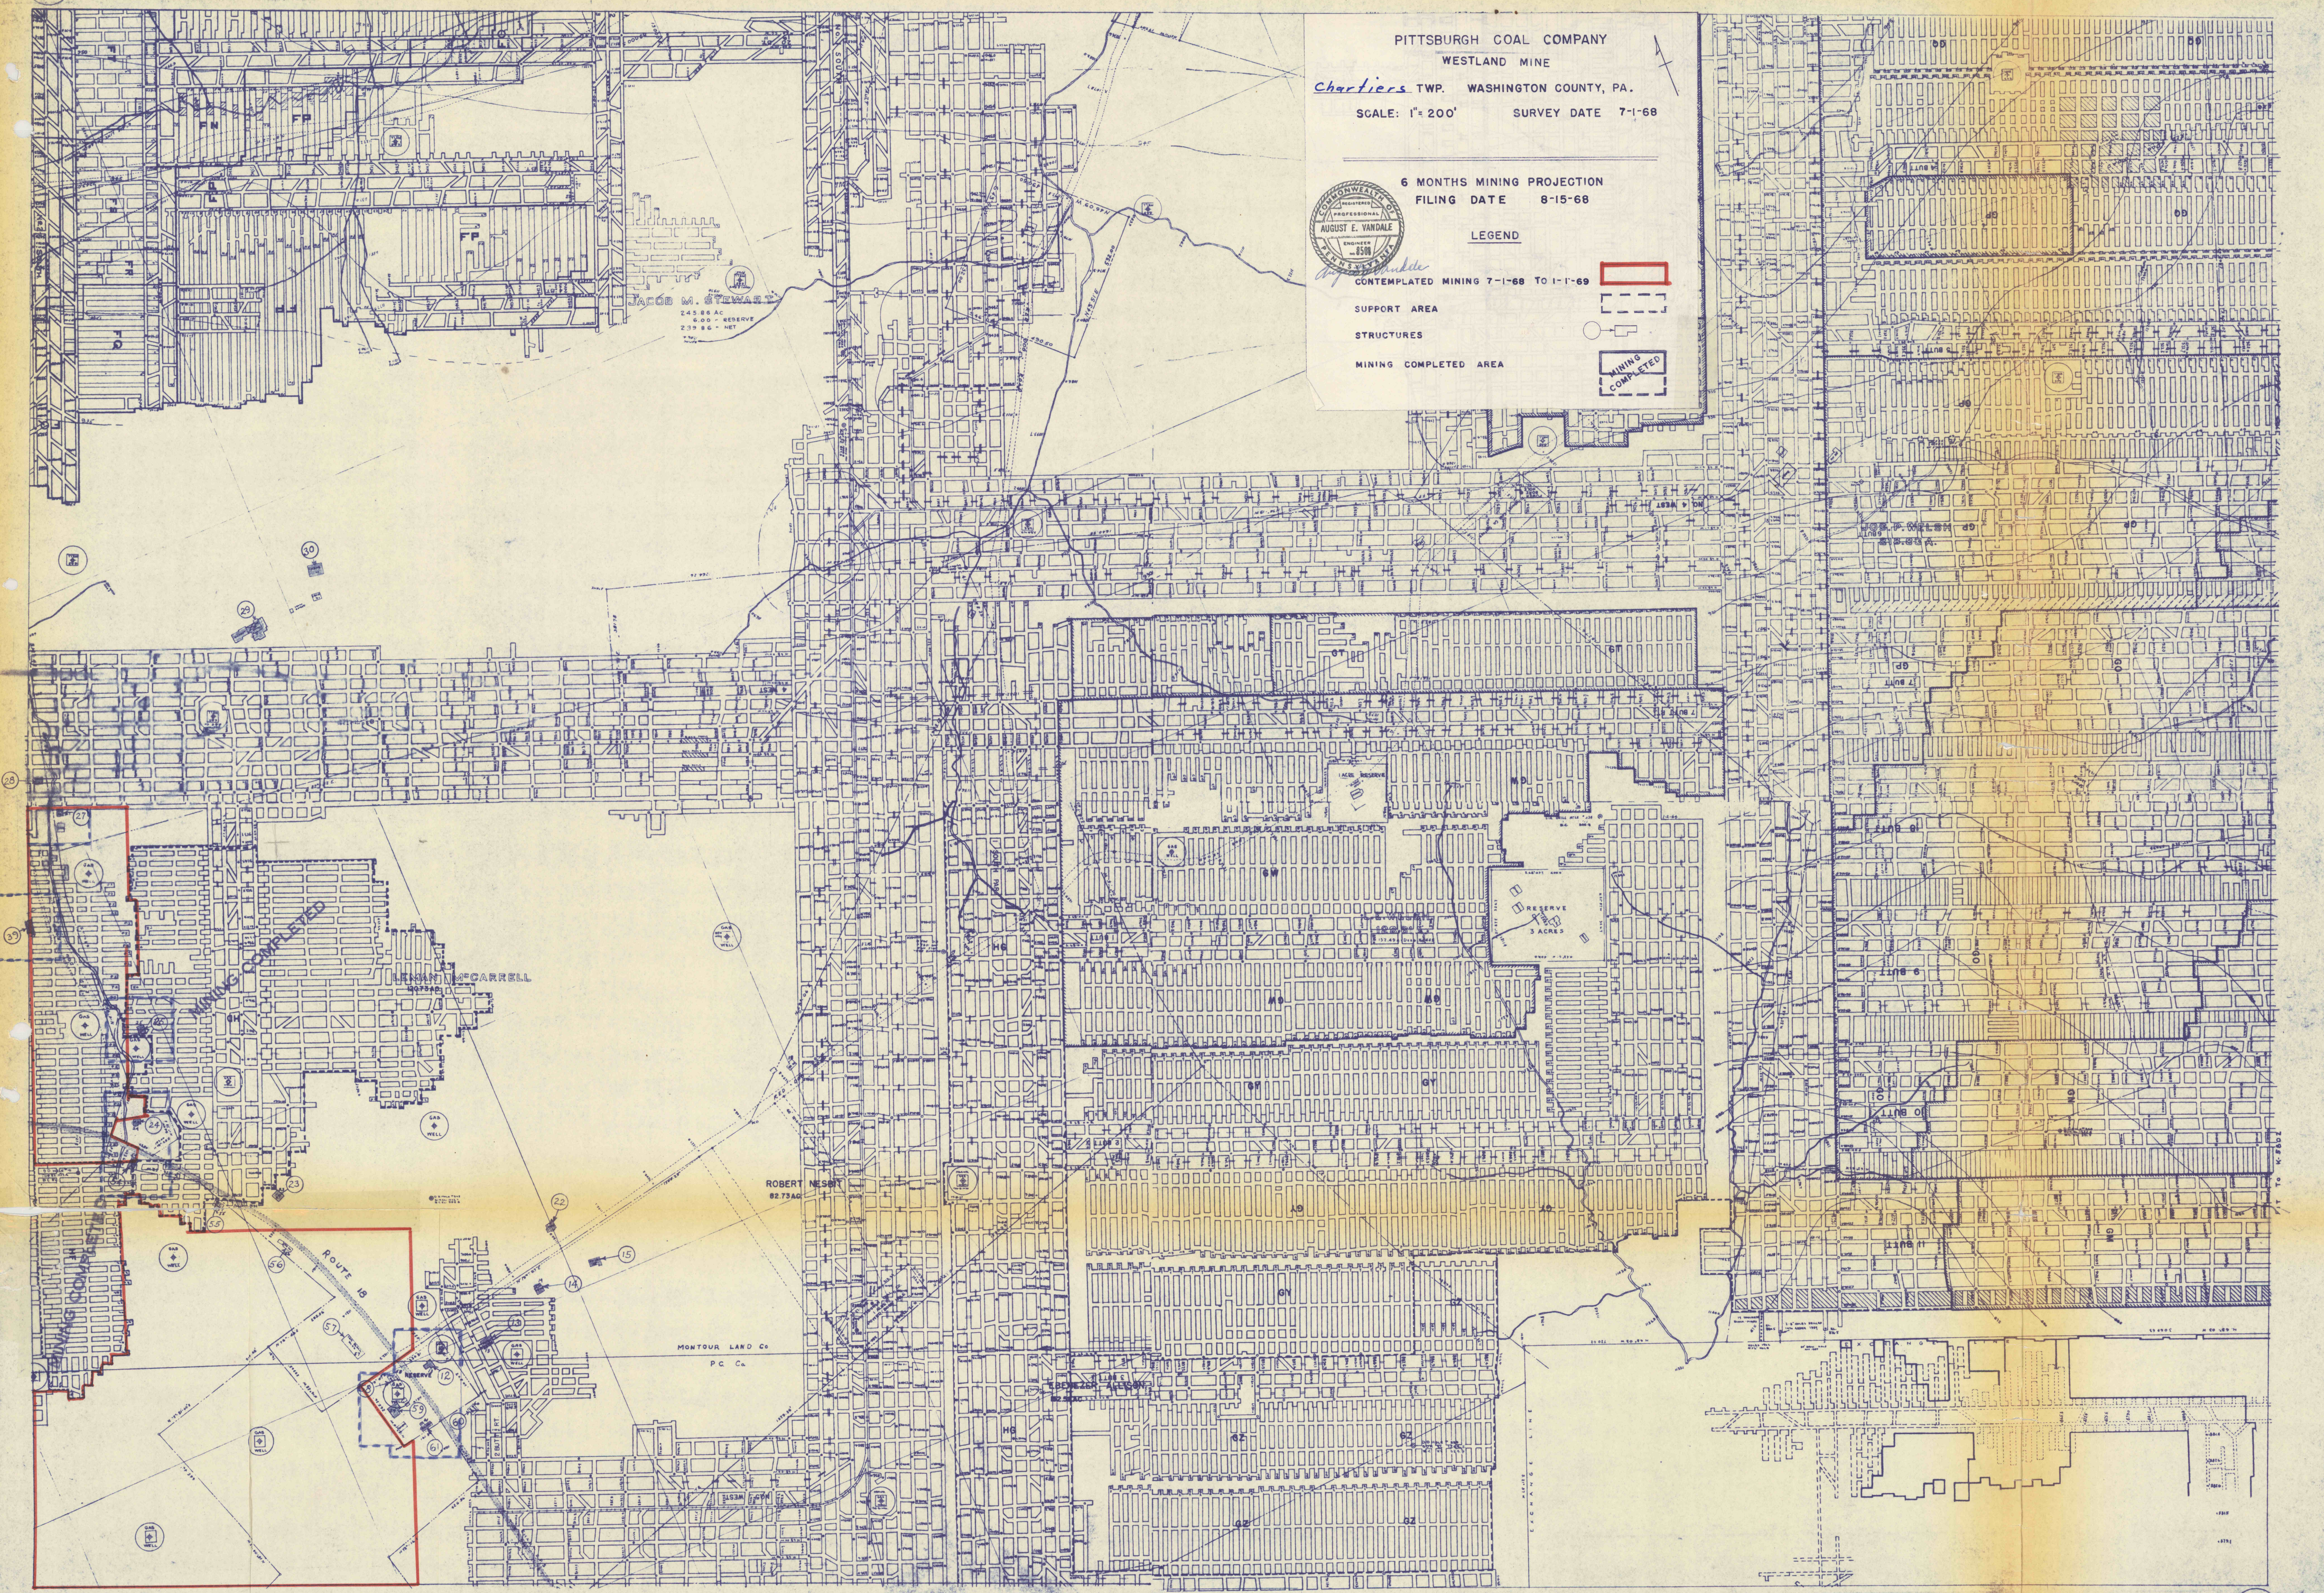

8-15-68 To 2-15-69

WESTLAND
Westland-005