


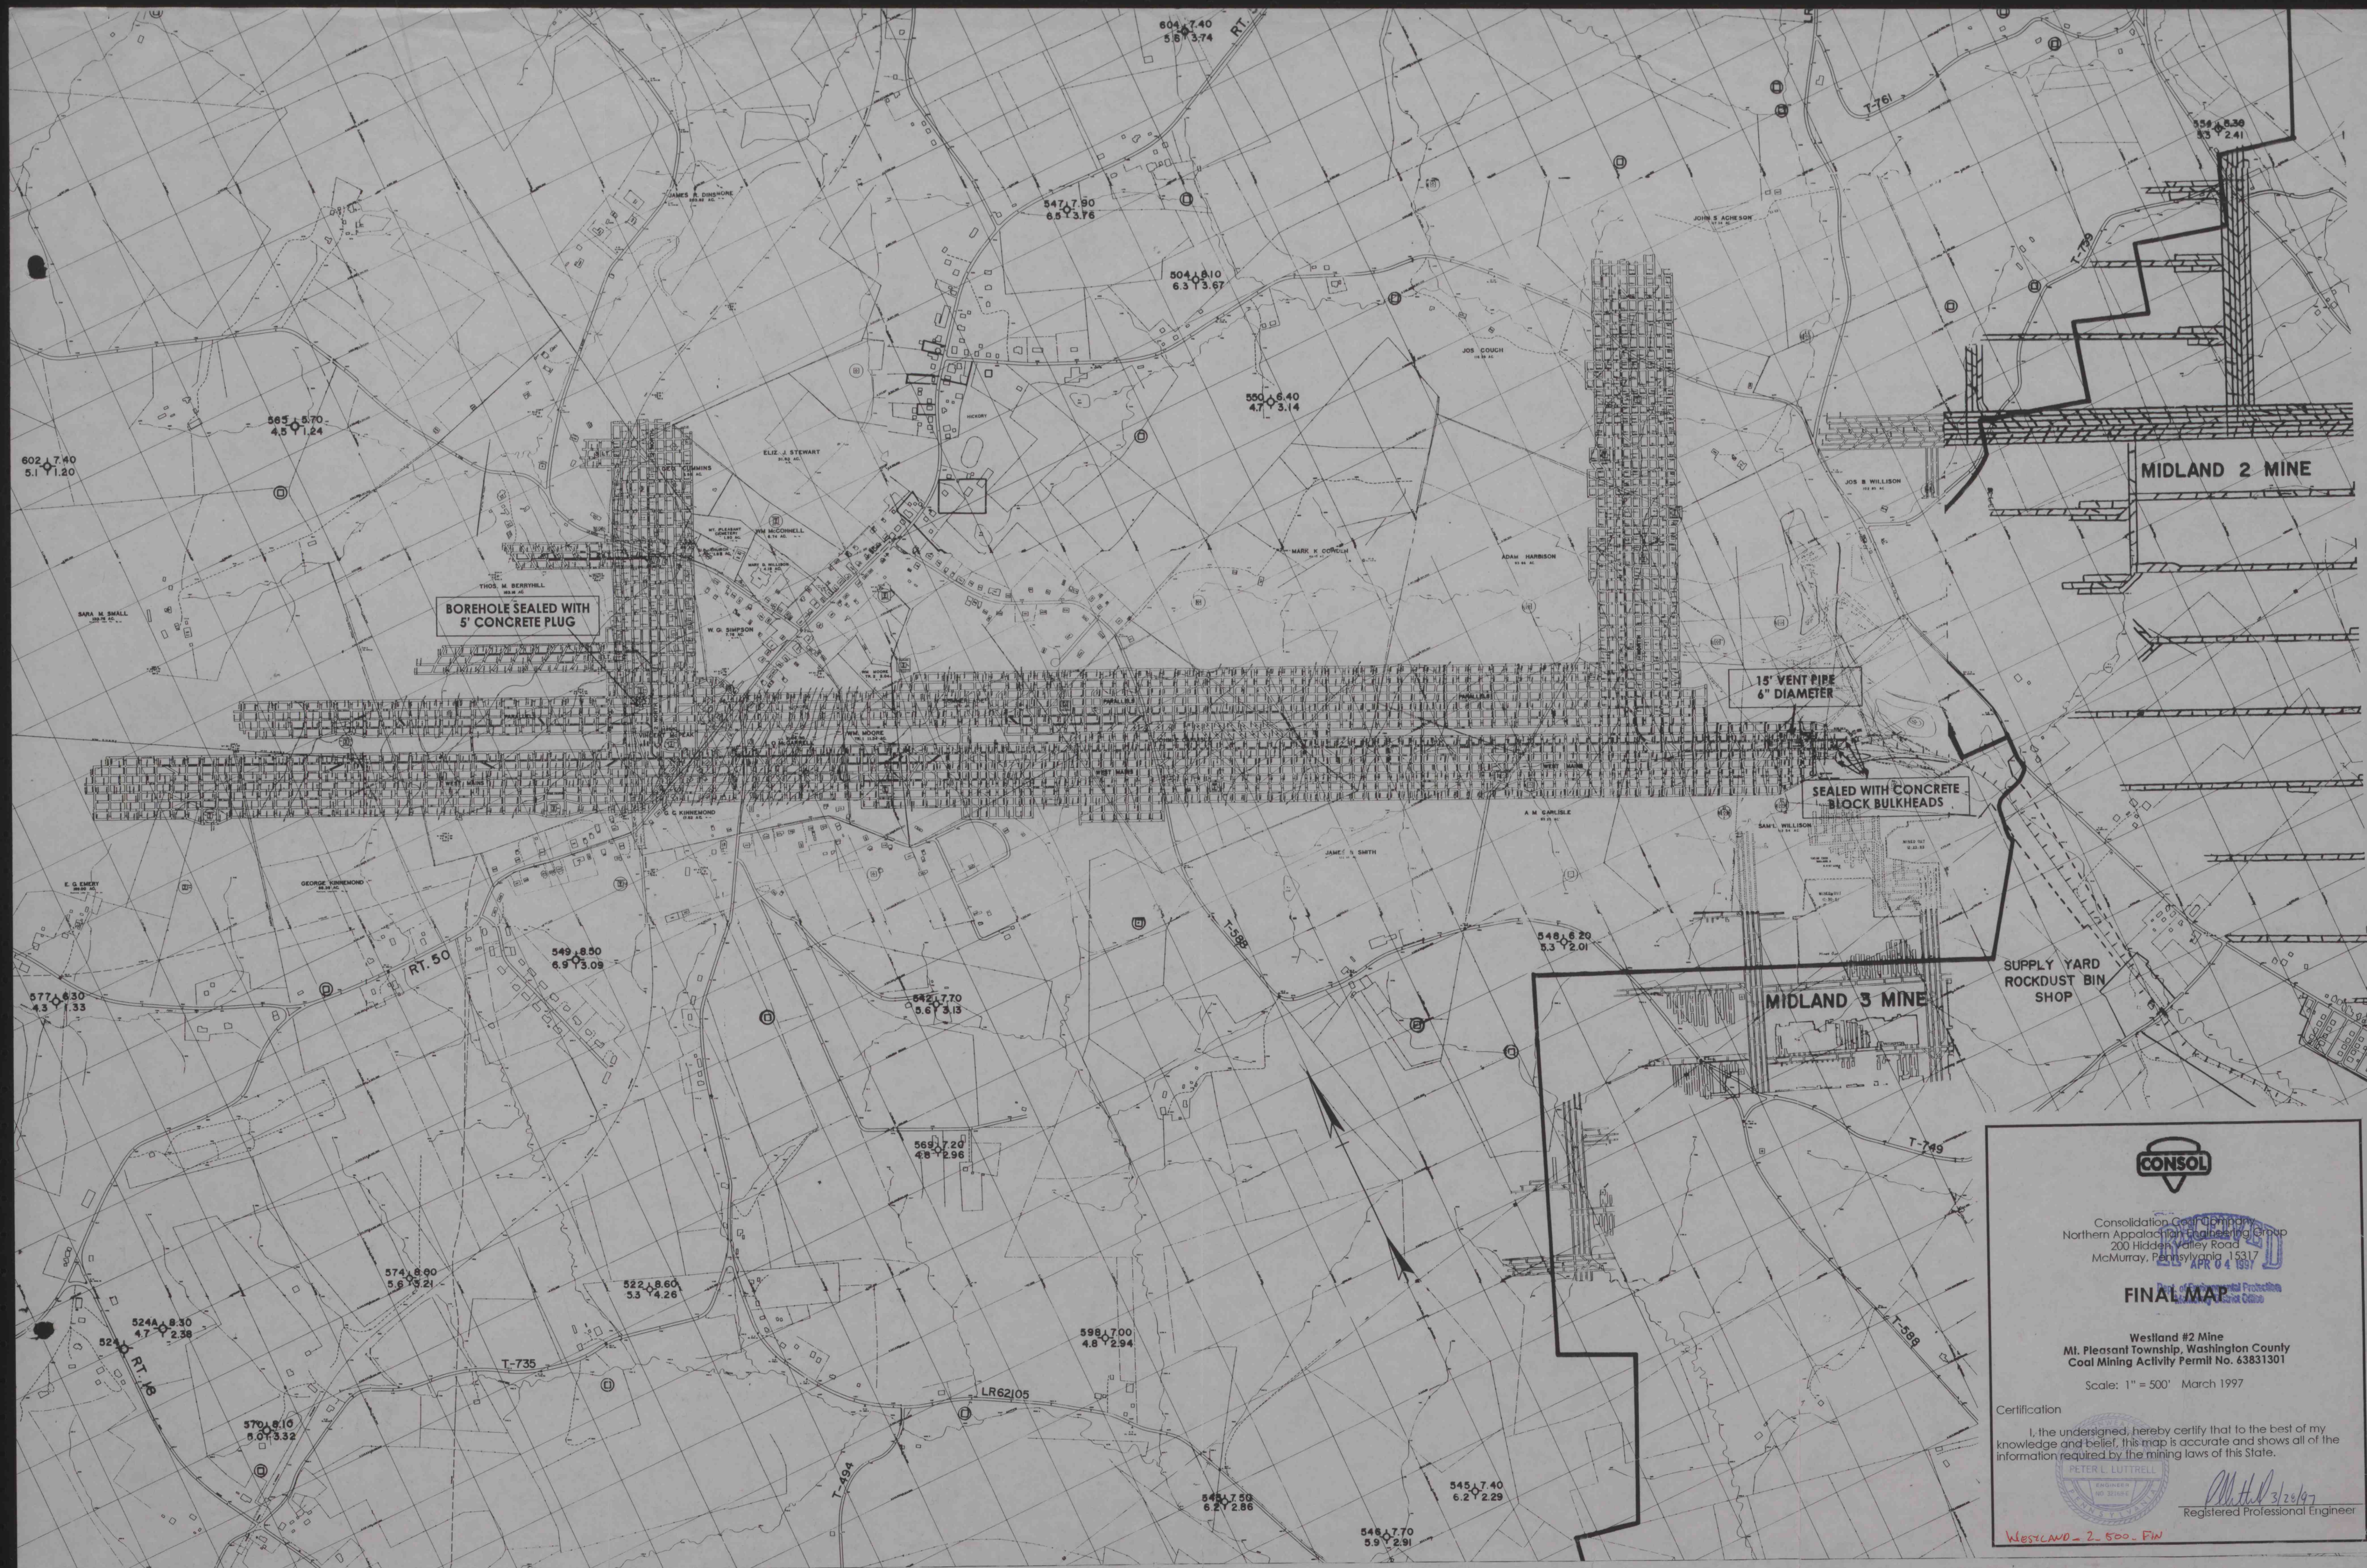

Consolidation Coal Company
Northern Appalachia Coal Mining Group
200 Hidden Valley Road
McMurry, Pennsylvania 15317
APR 04 1997

FINAL MAP

Westland #2 Mine
Mt. Pleasant Township, Washington County
Coal Mining Activity Permit No. 63831301

Scale: 1" = 500' March 1997

Certification

I, the undersigned, hereby certify that to the best of my knowledge and belief, this map is accurate and shows all of the information required by the mining laws of this State.



PETER L. LUTTRELL
3/28/97
Registered Professional Engineer

Westland - 2-500-FW