


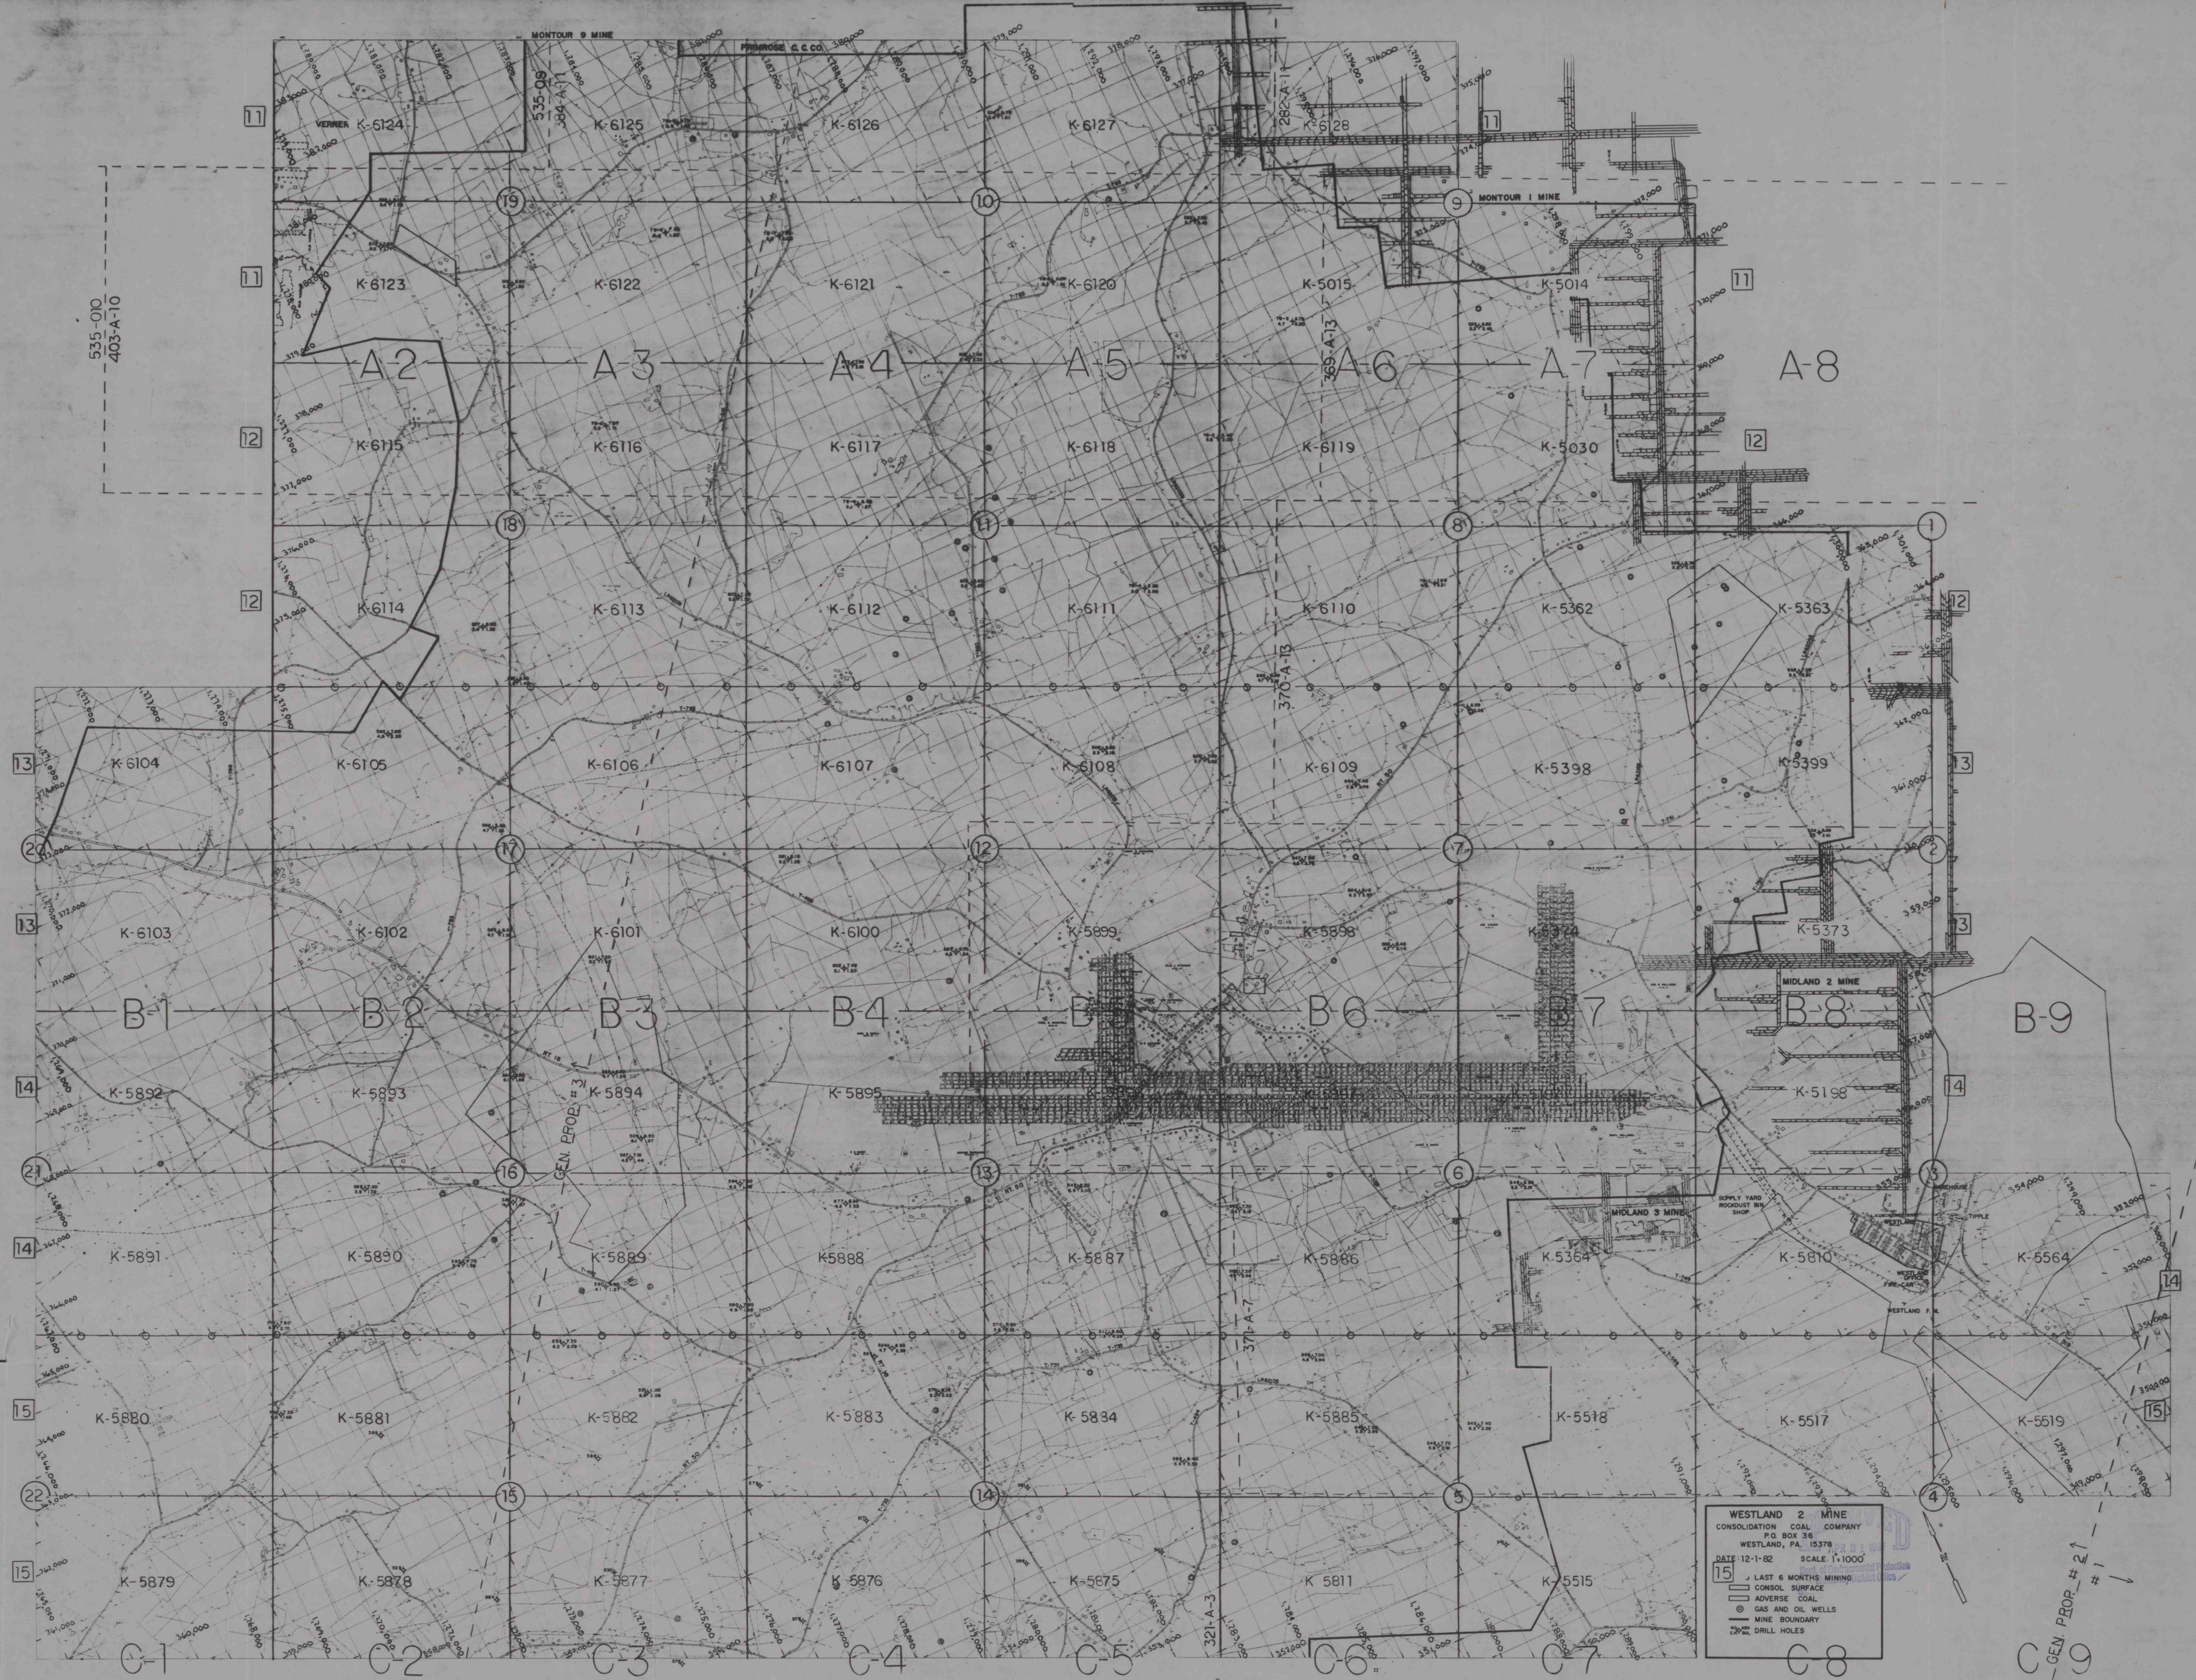

WESTLAND 2 MINE
CONSOLIDATION COAL COMPANY
P.O. BOX 36
WESTLAND, PA. 15378
DATE: 12-1-82 SCALE: 1"=1000'
15 LAST 6 MONTHS MINING
CONSOL SURFACE
ADVERSE COAL
GAS AND OIL WELLS
MINE BOUNDARY
DRILL HOLES

"K" Sheet Index
Westland #2 Mine

Westland 2-K-IND

GEN. PROP. #2