


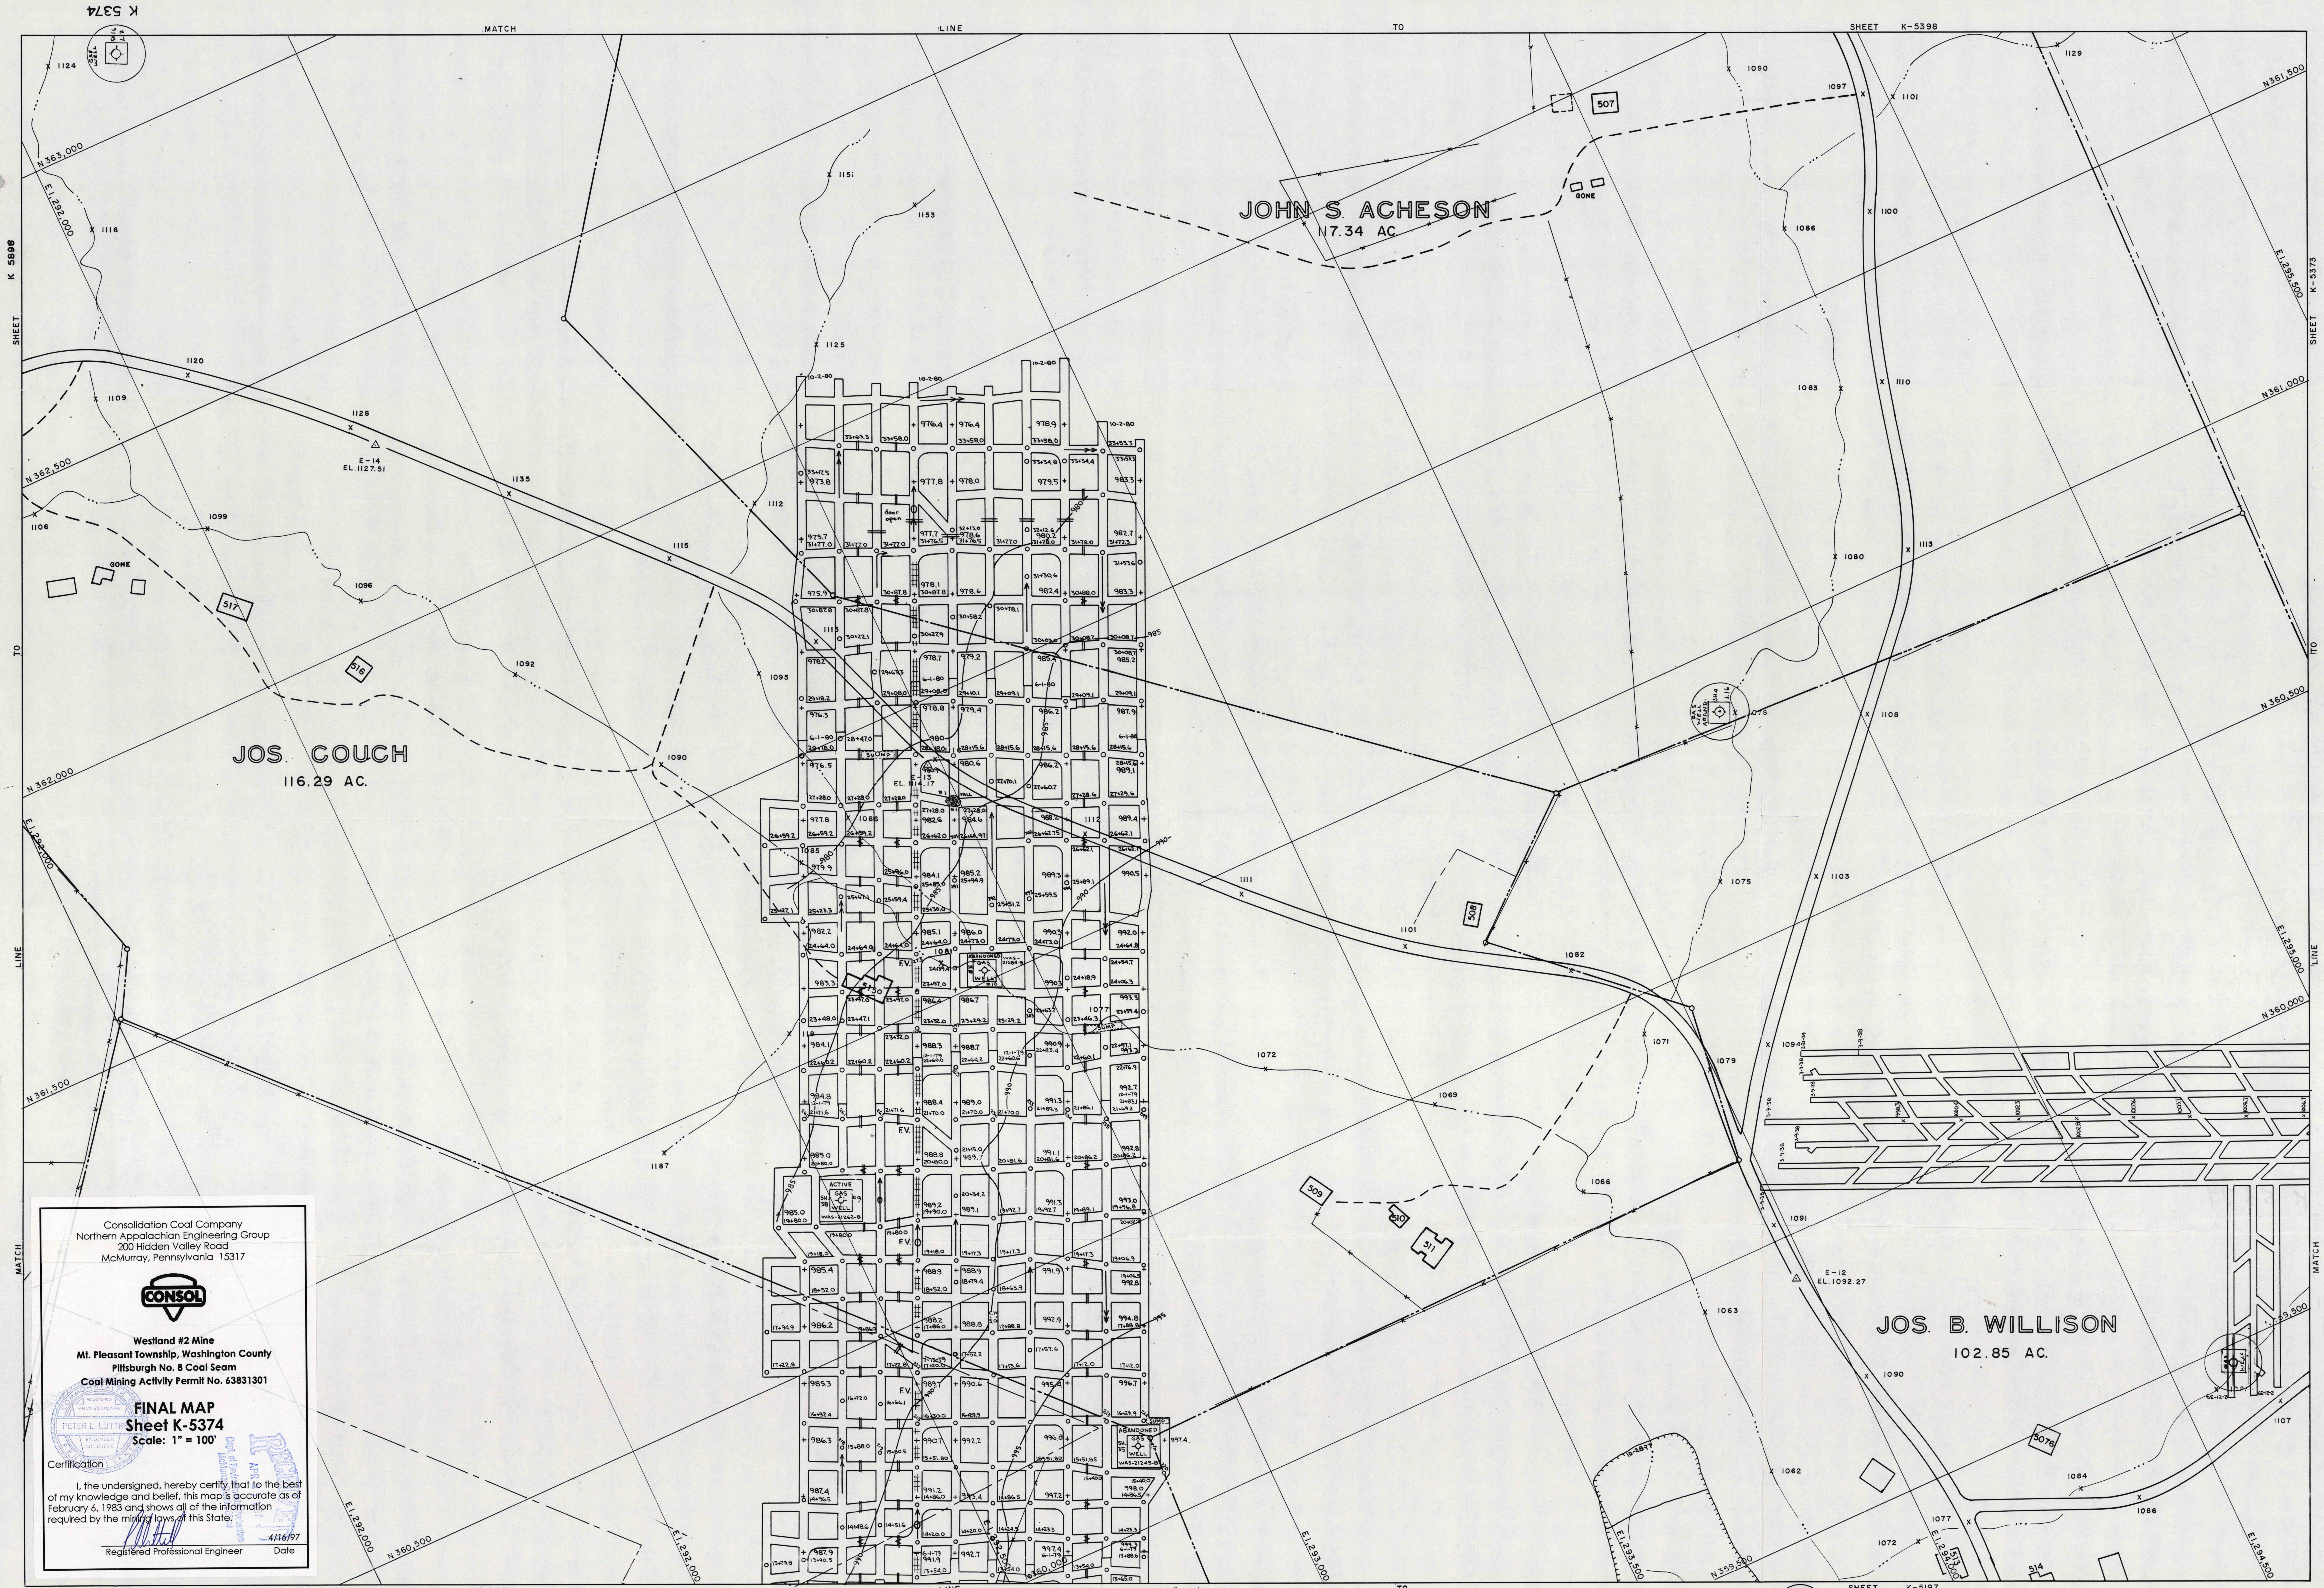

Consolidation Coal Company
Northern Appalachian Engineering Group
200 Hidden Valley Road
McMurray, Pennsylvania 15317

CONSOL

Westland #2 Mine
Mt. Pleasant Township, Washington County
Pittsburgh No. 8 Coal Seam
Coal Mining Activity Permit No. 63831301

FINAL MAP
Sheet K-5374
Scale: 1" = 100'

Certification
I, the undersigned, hereby certify that to the best of my knowledge and belief, this map is accurate as of February 6, 1983 and shows all of the information required by the mining laws of this State.

4/16/97
Registered Professional Engineer Date