


FINAL MINE MAP

200
0
100
200
LUCERNE NO 6 MINE-HELVETIA COAL CO
BLACK LICK
J-3/4

RECEIVED
OCT 23 1930
Div. of Environmental Sciences
Mining District Office



JACKSONVILLE No 6

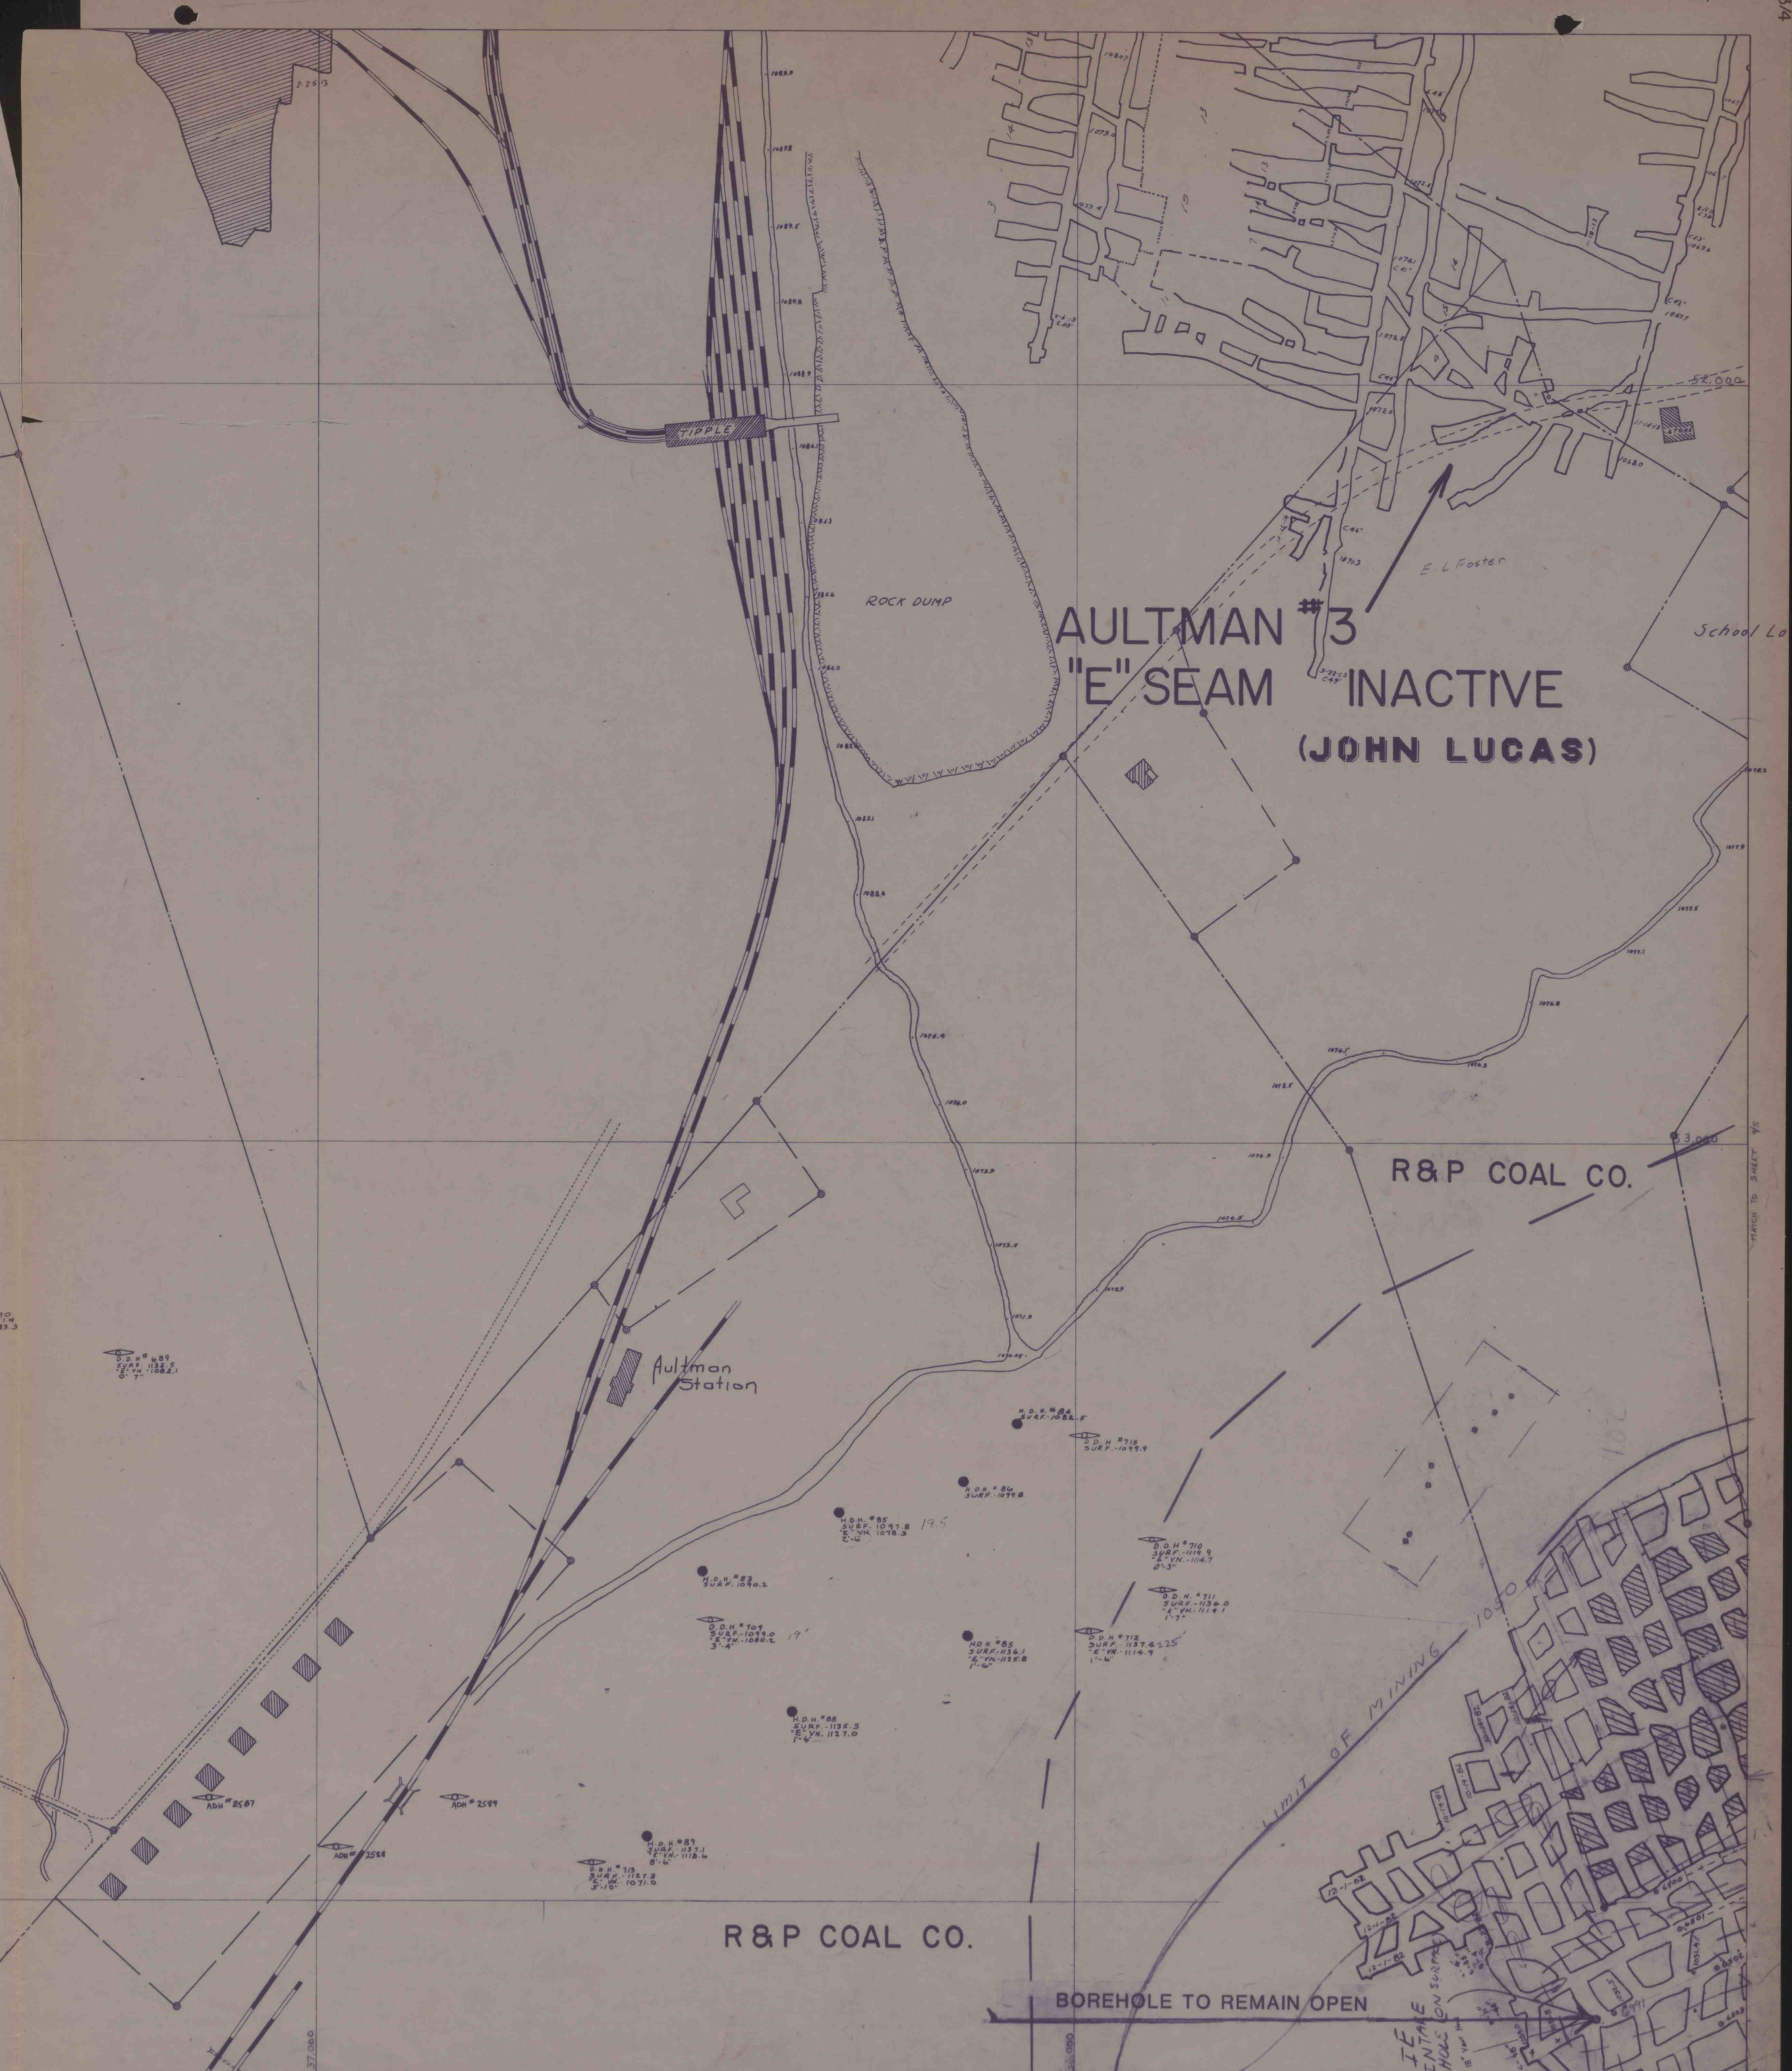

AULTMAN #3
"E" SEAM INACTIVE
(JOHN LUCAS)

ROCK DUMP

Aultman Station

R&P COAL CO.

R&P COAL CO.

BOREHOLE TO REMAIN OPEN

LIMIT OF MINING

ALL TAXES DONE ON THIS SHEET 21218Y M.D.S.

J-3/4
LUCERNE 6