


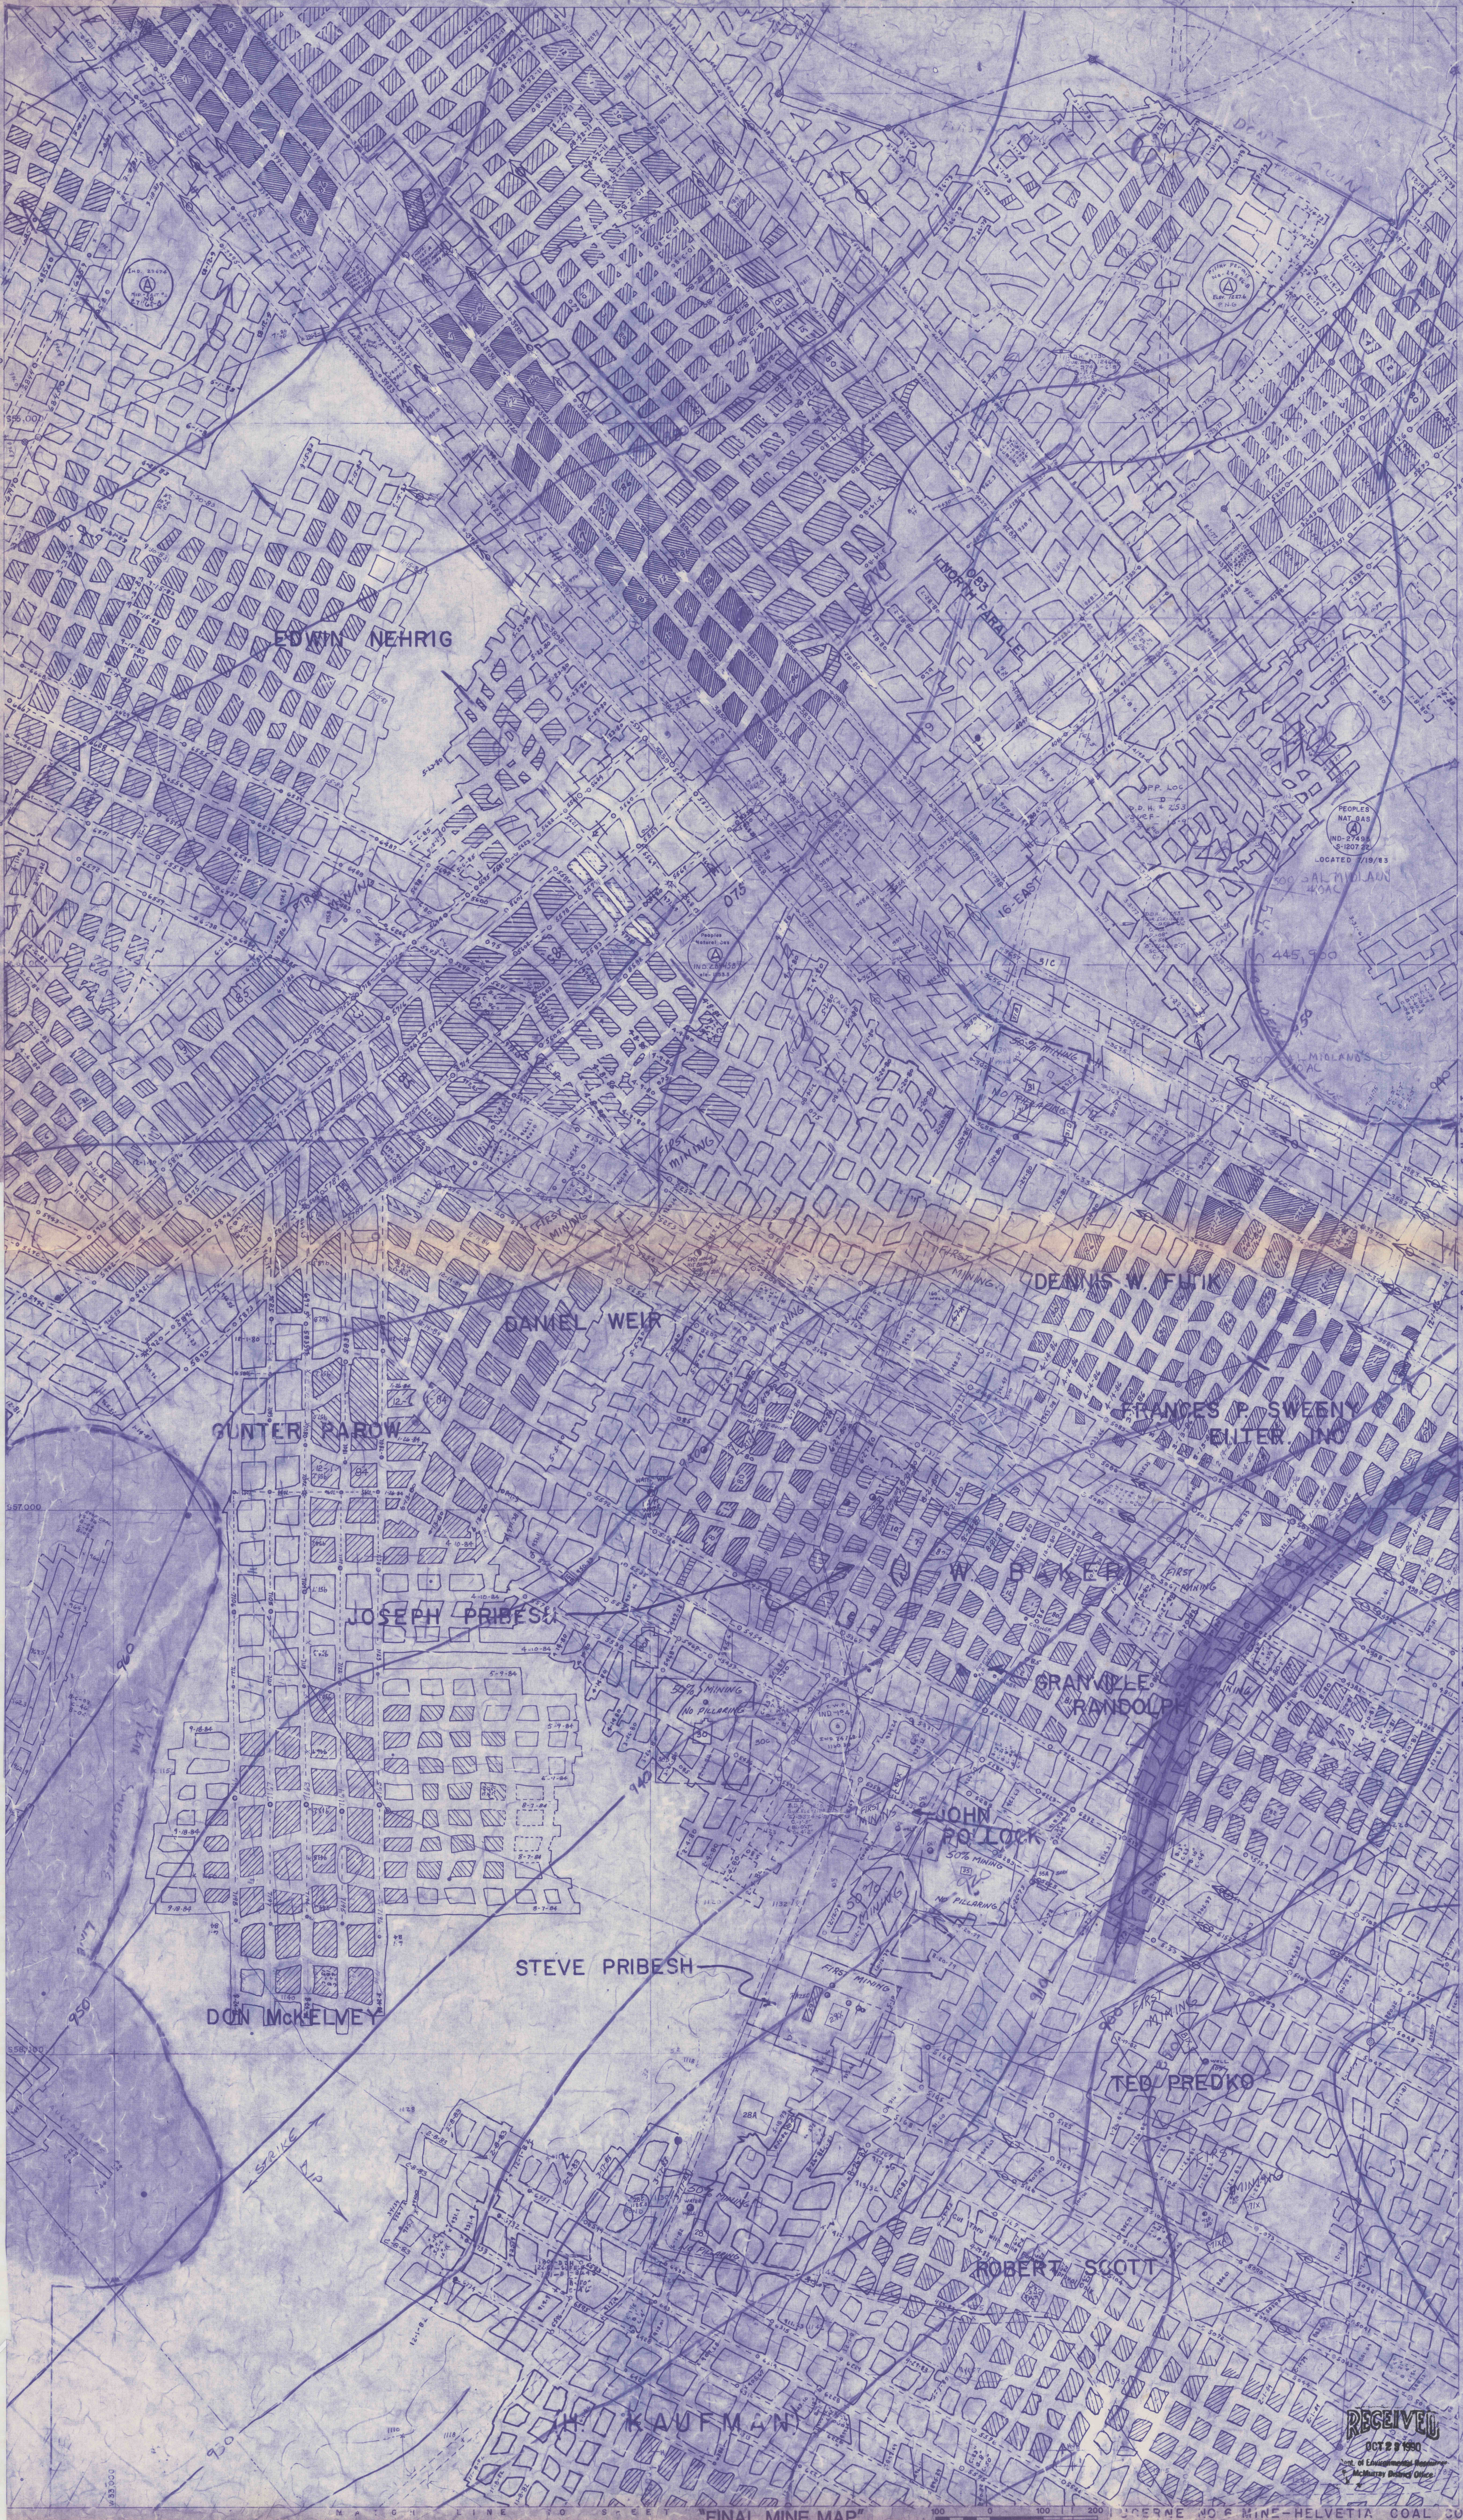

EDWIN NEHRIG

NORTH PARALLEL

DENNIS W. FLIK

FRANCIS P. SWEENEY
ALTER, INC.

GUNTHER PAROW

DANIEL WEIR

JOSEPH PRIBESH

GRANVILLE L.
RANDOLPH

JOHN
POTLOK

STEVE PRIBESH

DON McELVEY

TED PREDKO

ROBERT SCOTT

H. KAUFMAN

RECEIVED
OCT 29 1980

FINAL MINE MAP

BERNE NO. 6 MINE-HELVETIA COAL CO.
CENTER TWP. INDIANA CO.