


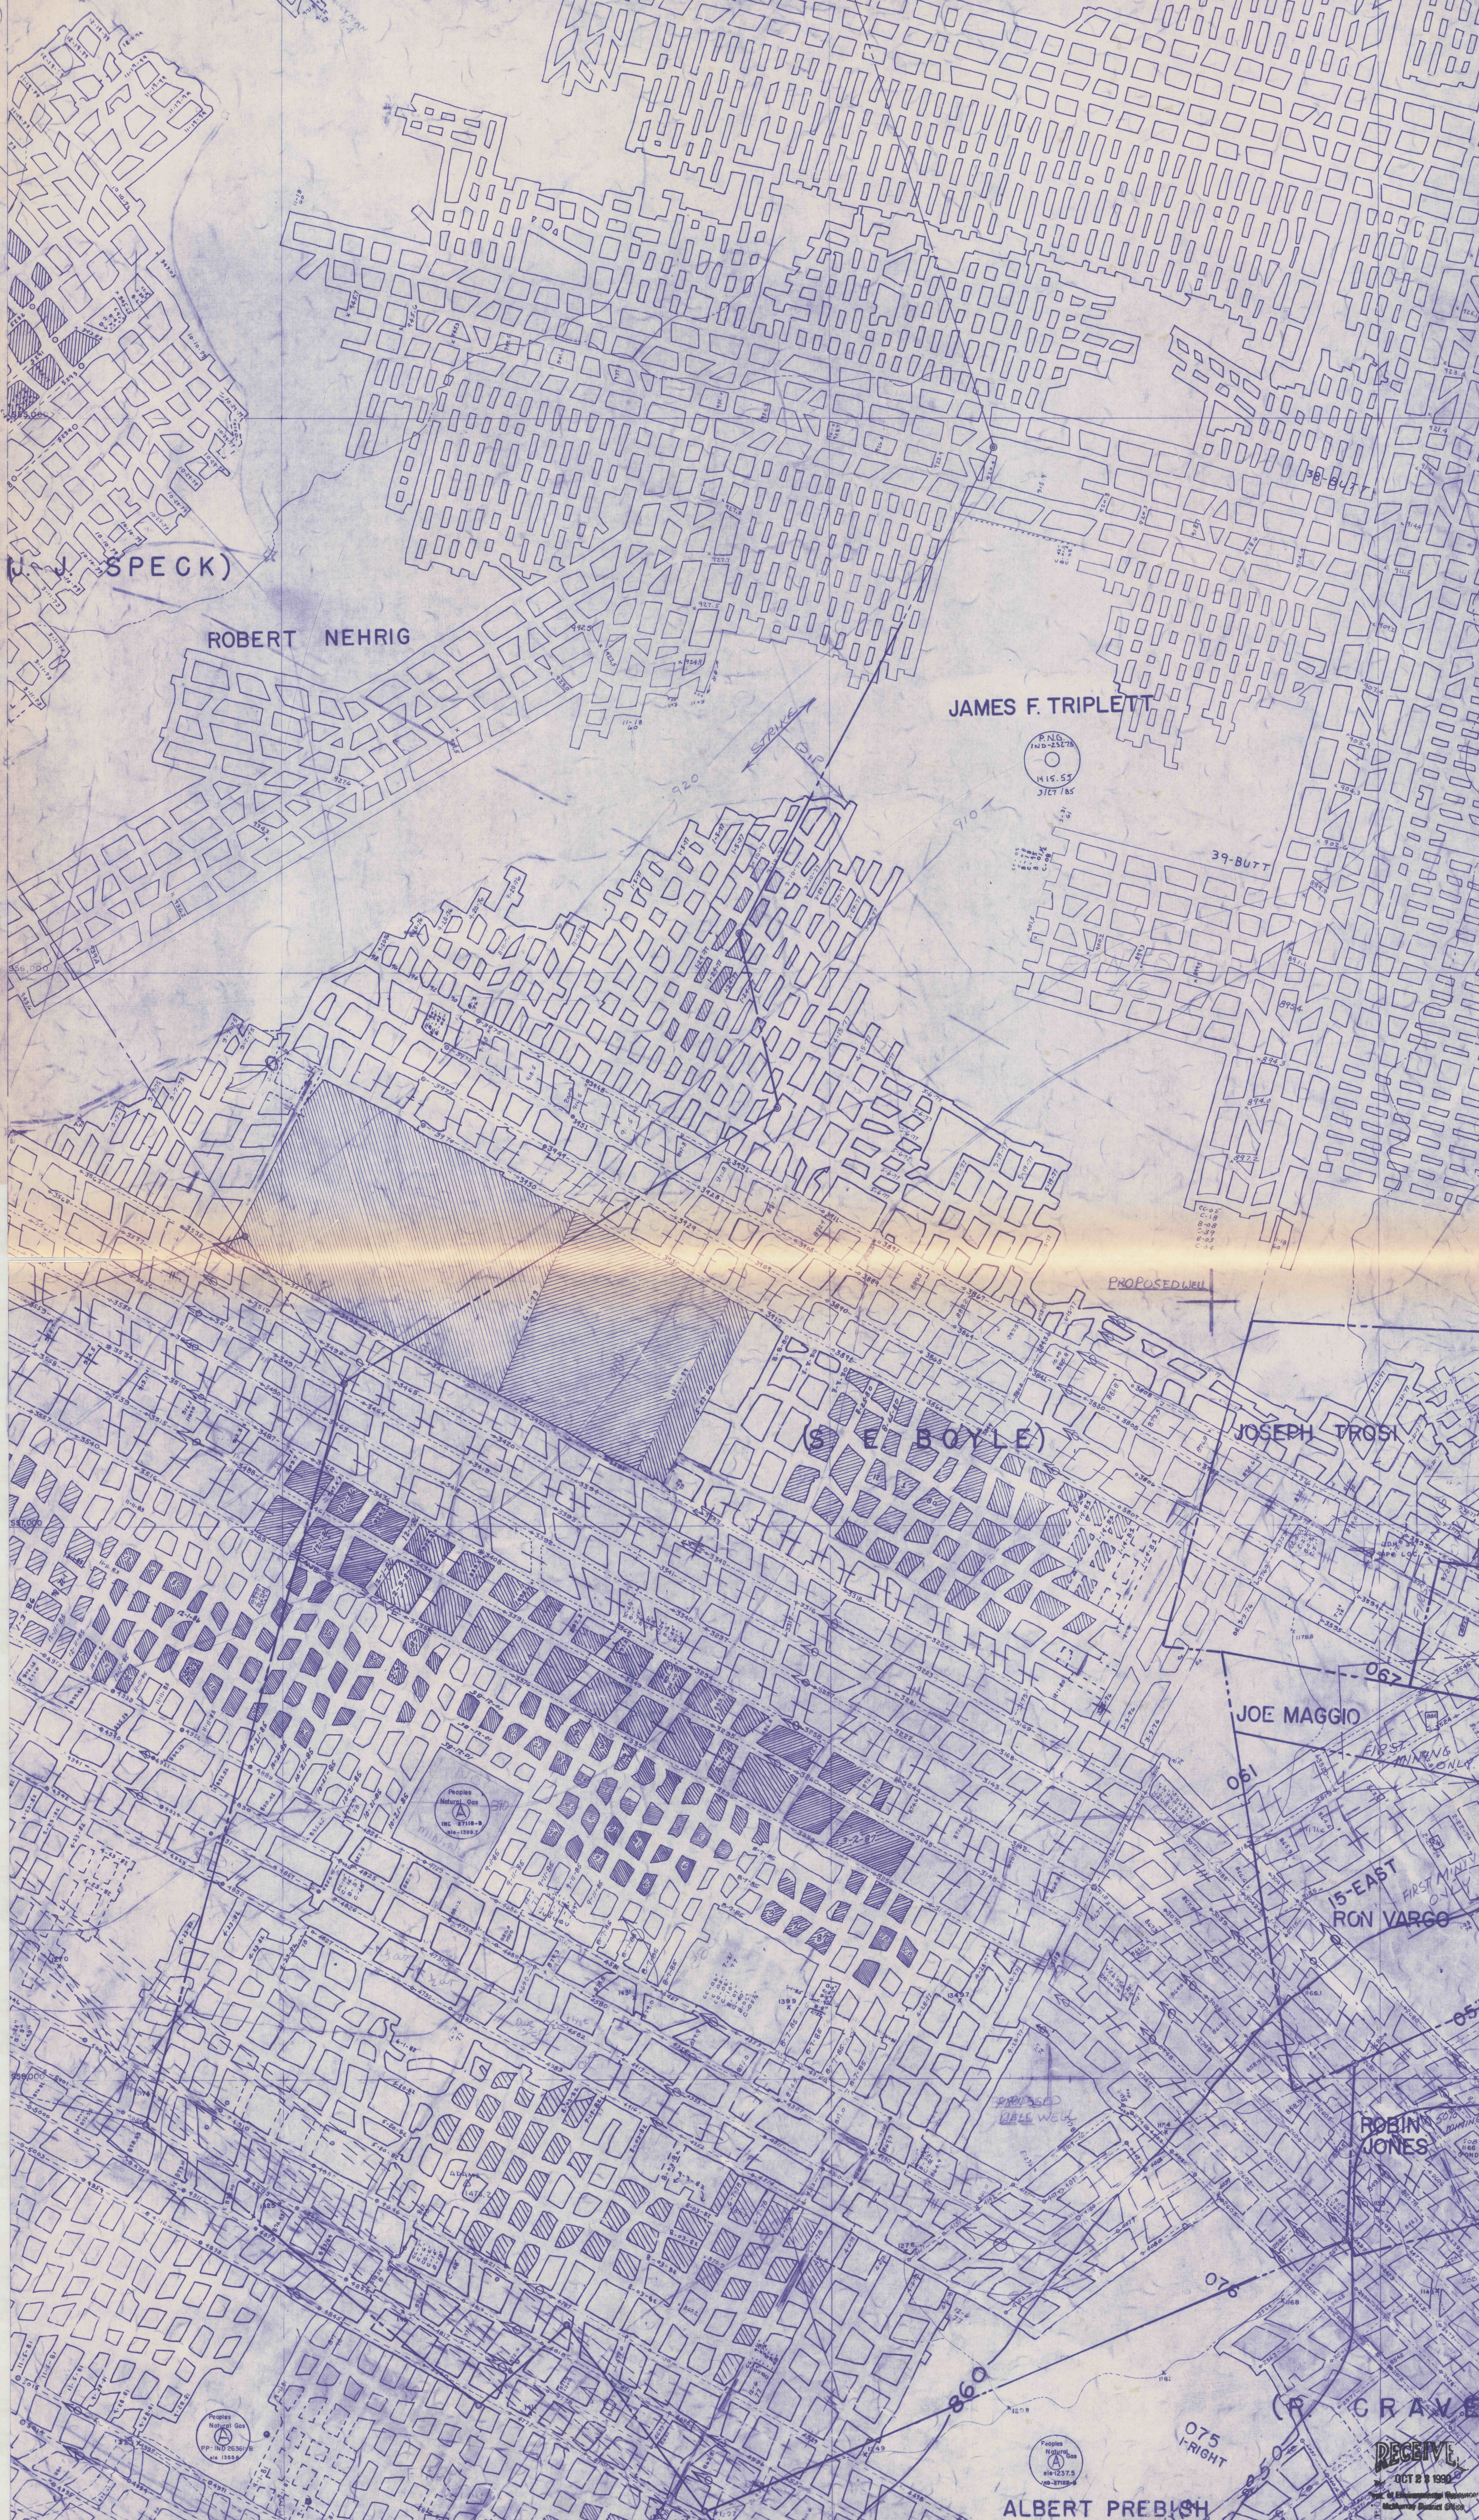

MATCH LINE TO SHEET 1-5

MATCH LINE TO SHEET 1-7