


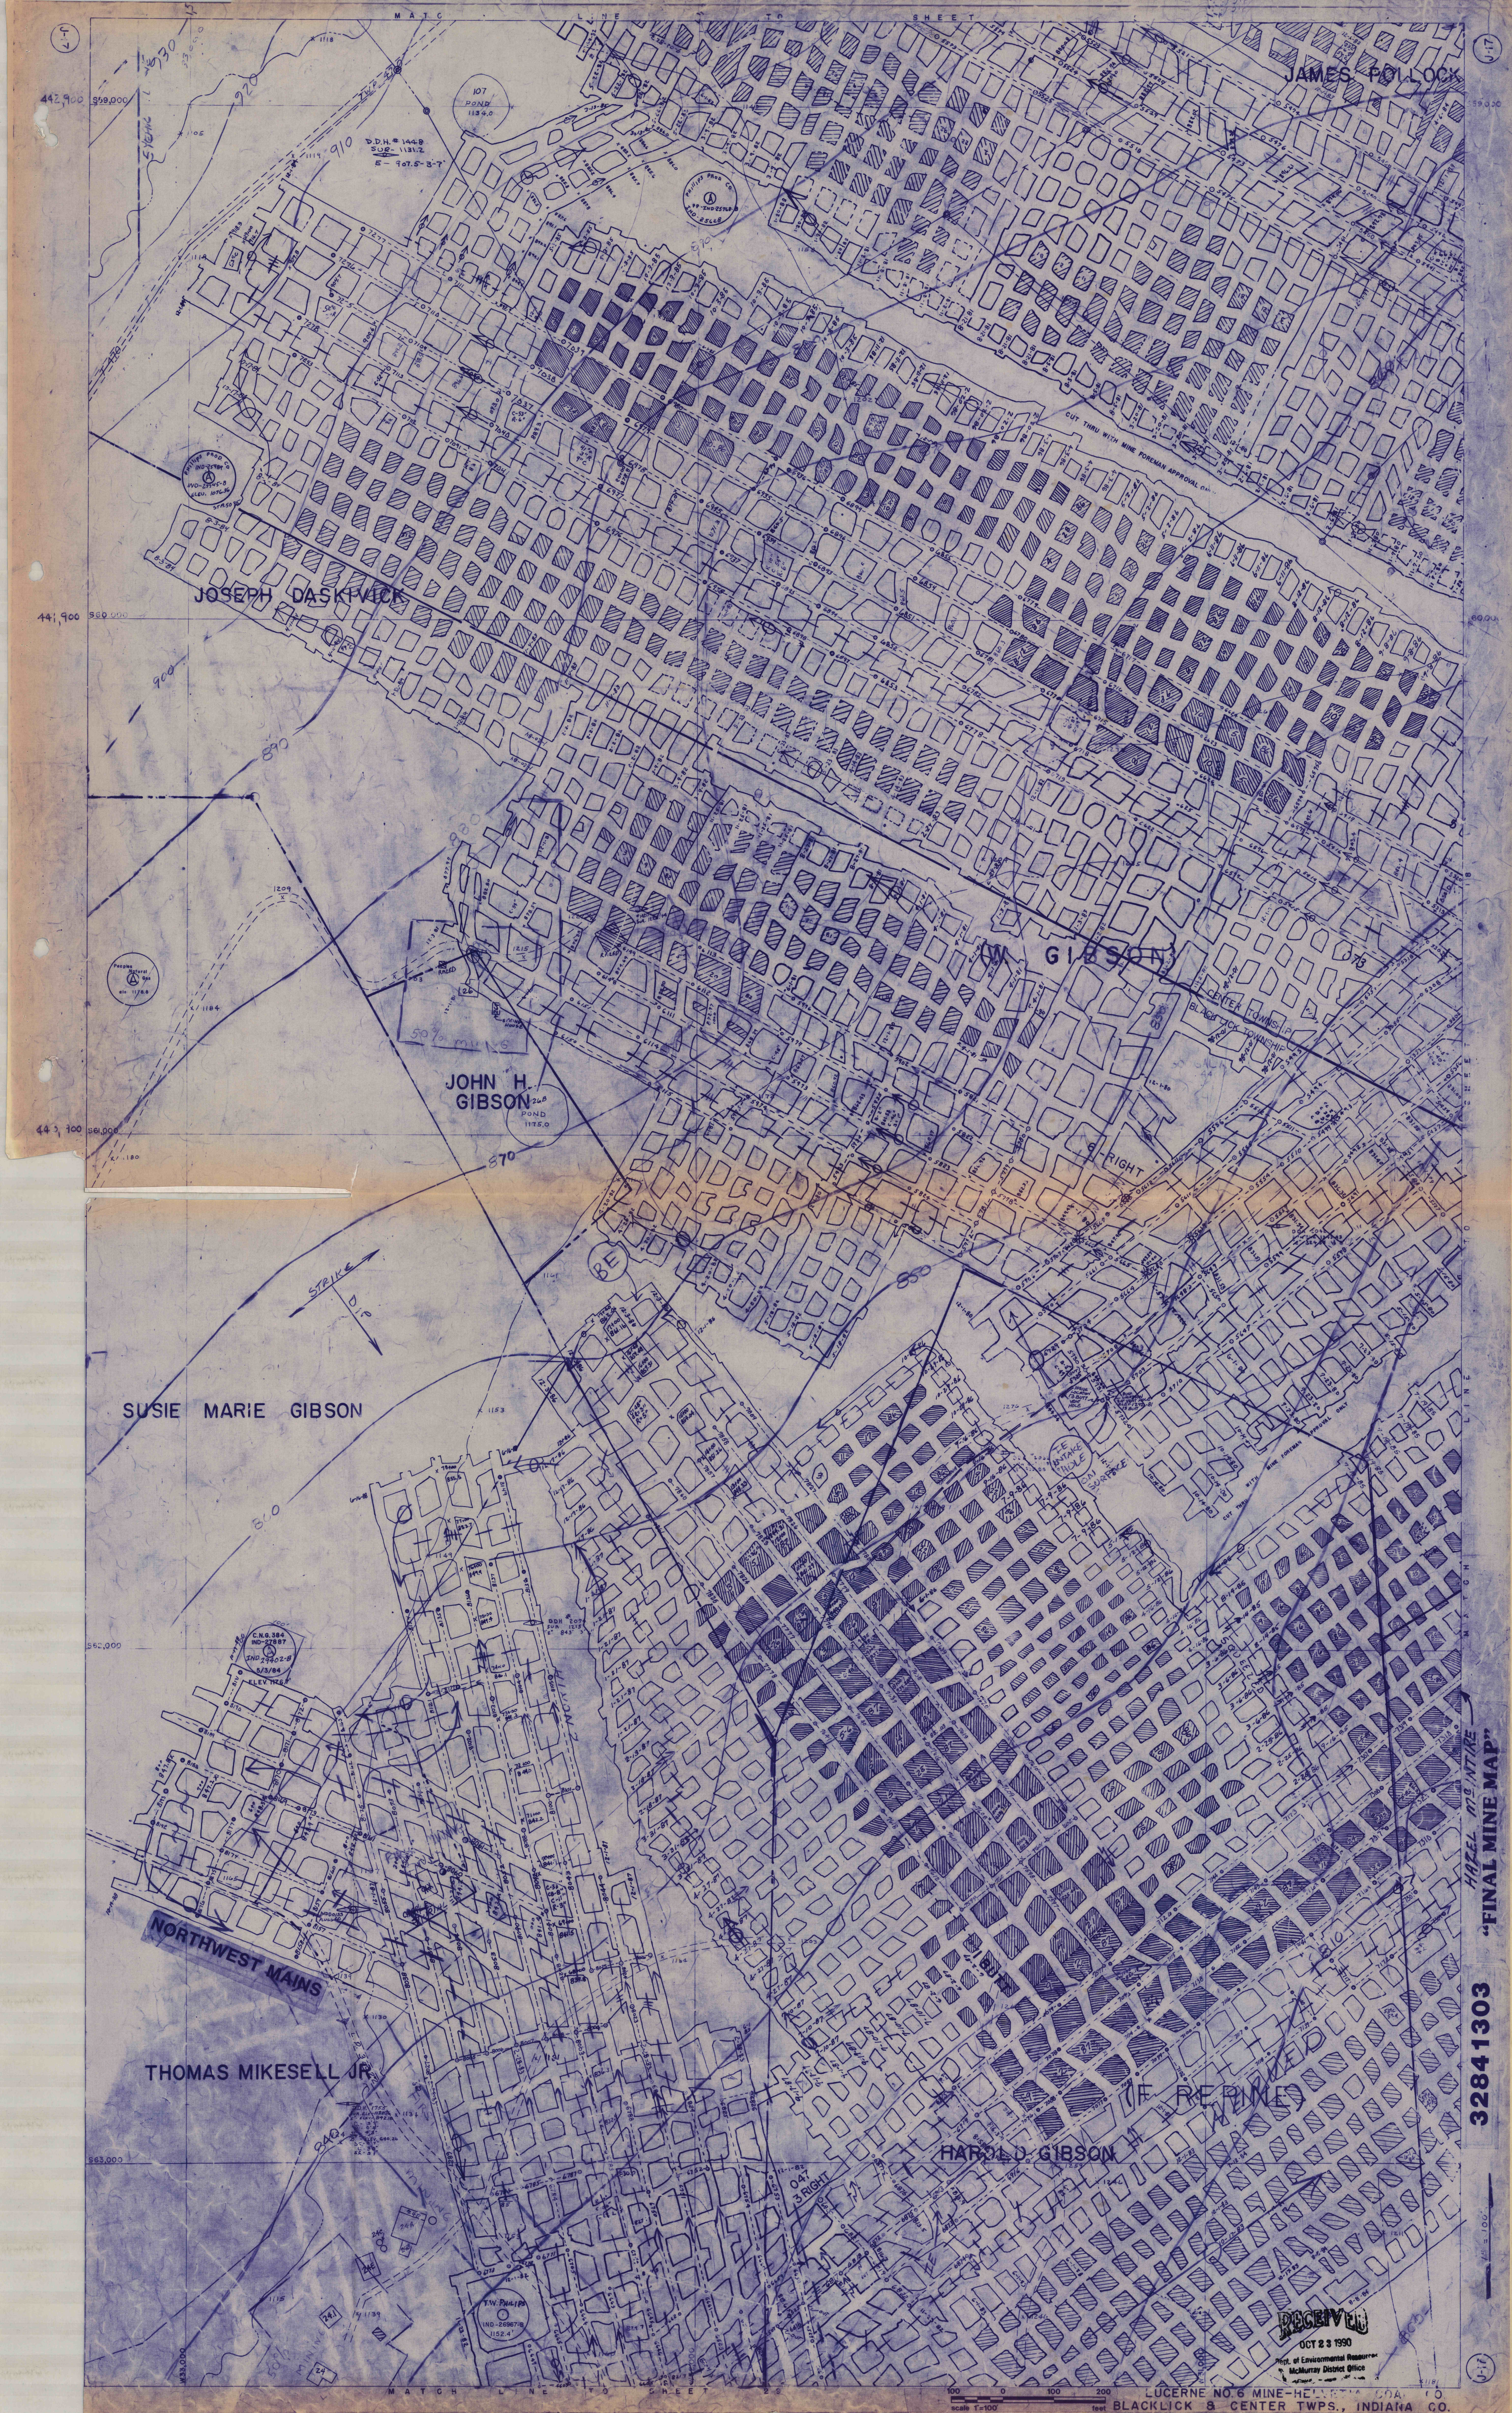

JAMES POLLOCK

JOSEPH DASKWICK

JOHN H. GIBSON

W. GIBSON

SUSIE MARIE GIBSON

THOMAS MIKESSELL JR.

HAROLD GIBSON

REBINE

32841303
"FINAL MINE MAP"

RECEIVED
OCT 23 1990
Dept. of Environmental Resources
McClintock District Office

LUCERNE NO. 6 MINE - HELLERS CO. CO.
BLACKLICK & CENTER TOWNSHIPS, INDIANA CO.
Scale 1"=100'