


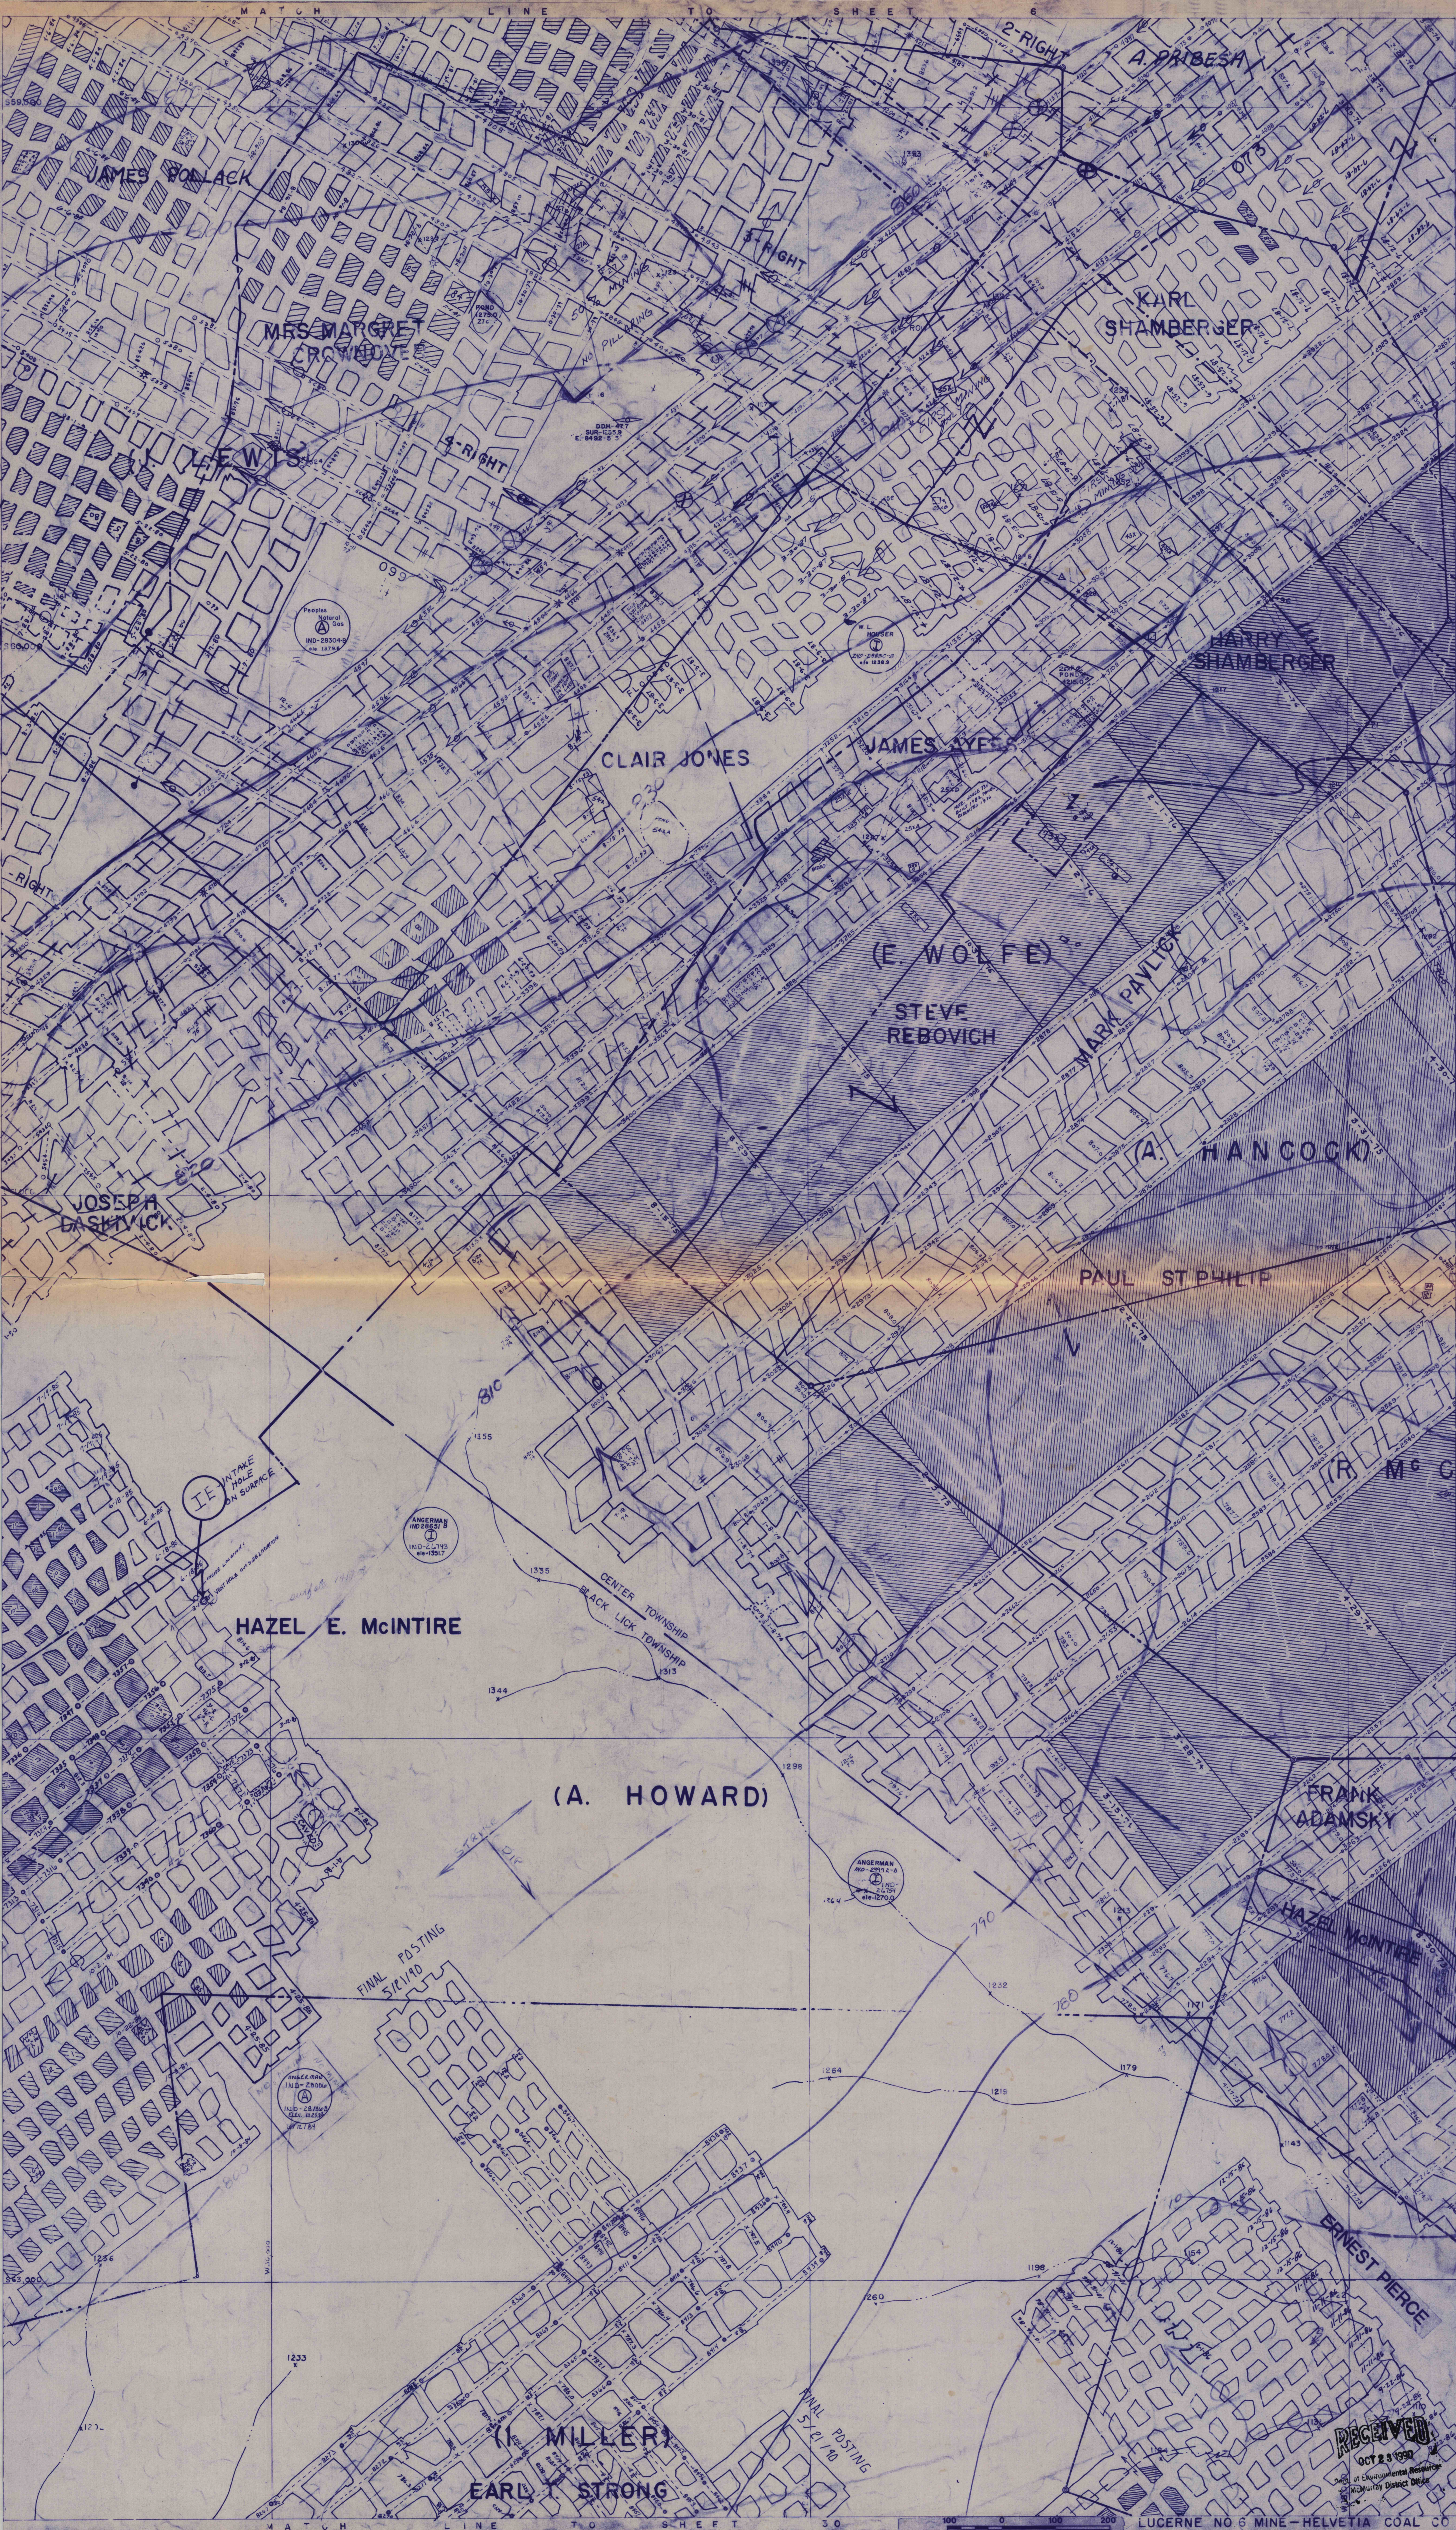

32841303 "FINAL MINE MAP"

1" = 100'

RECEIVED
OCT 23 1990
State of Environmental Resources
Indiana Survey District Office

LUCERNE NO 6 MINE - HELVETIA COAL CO
BLACK LICK & CENTER TOWNS - INDIANA CO