


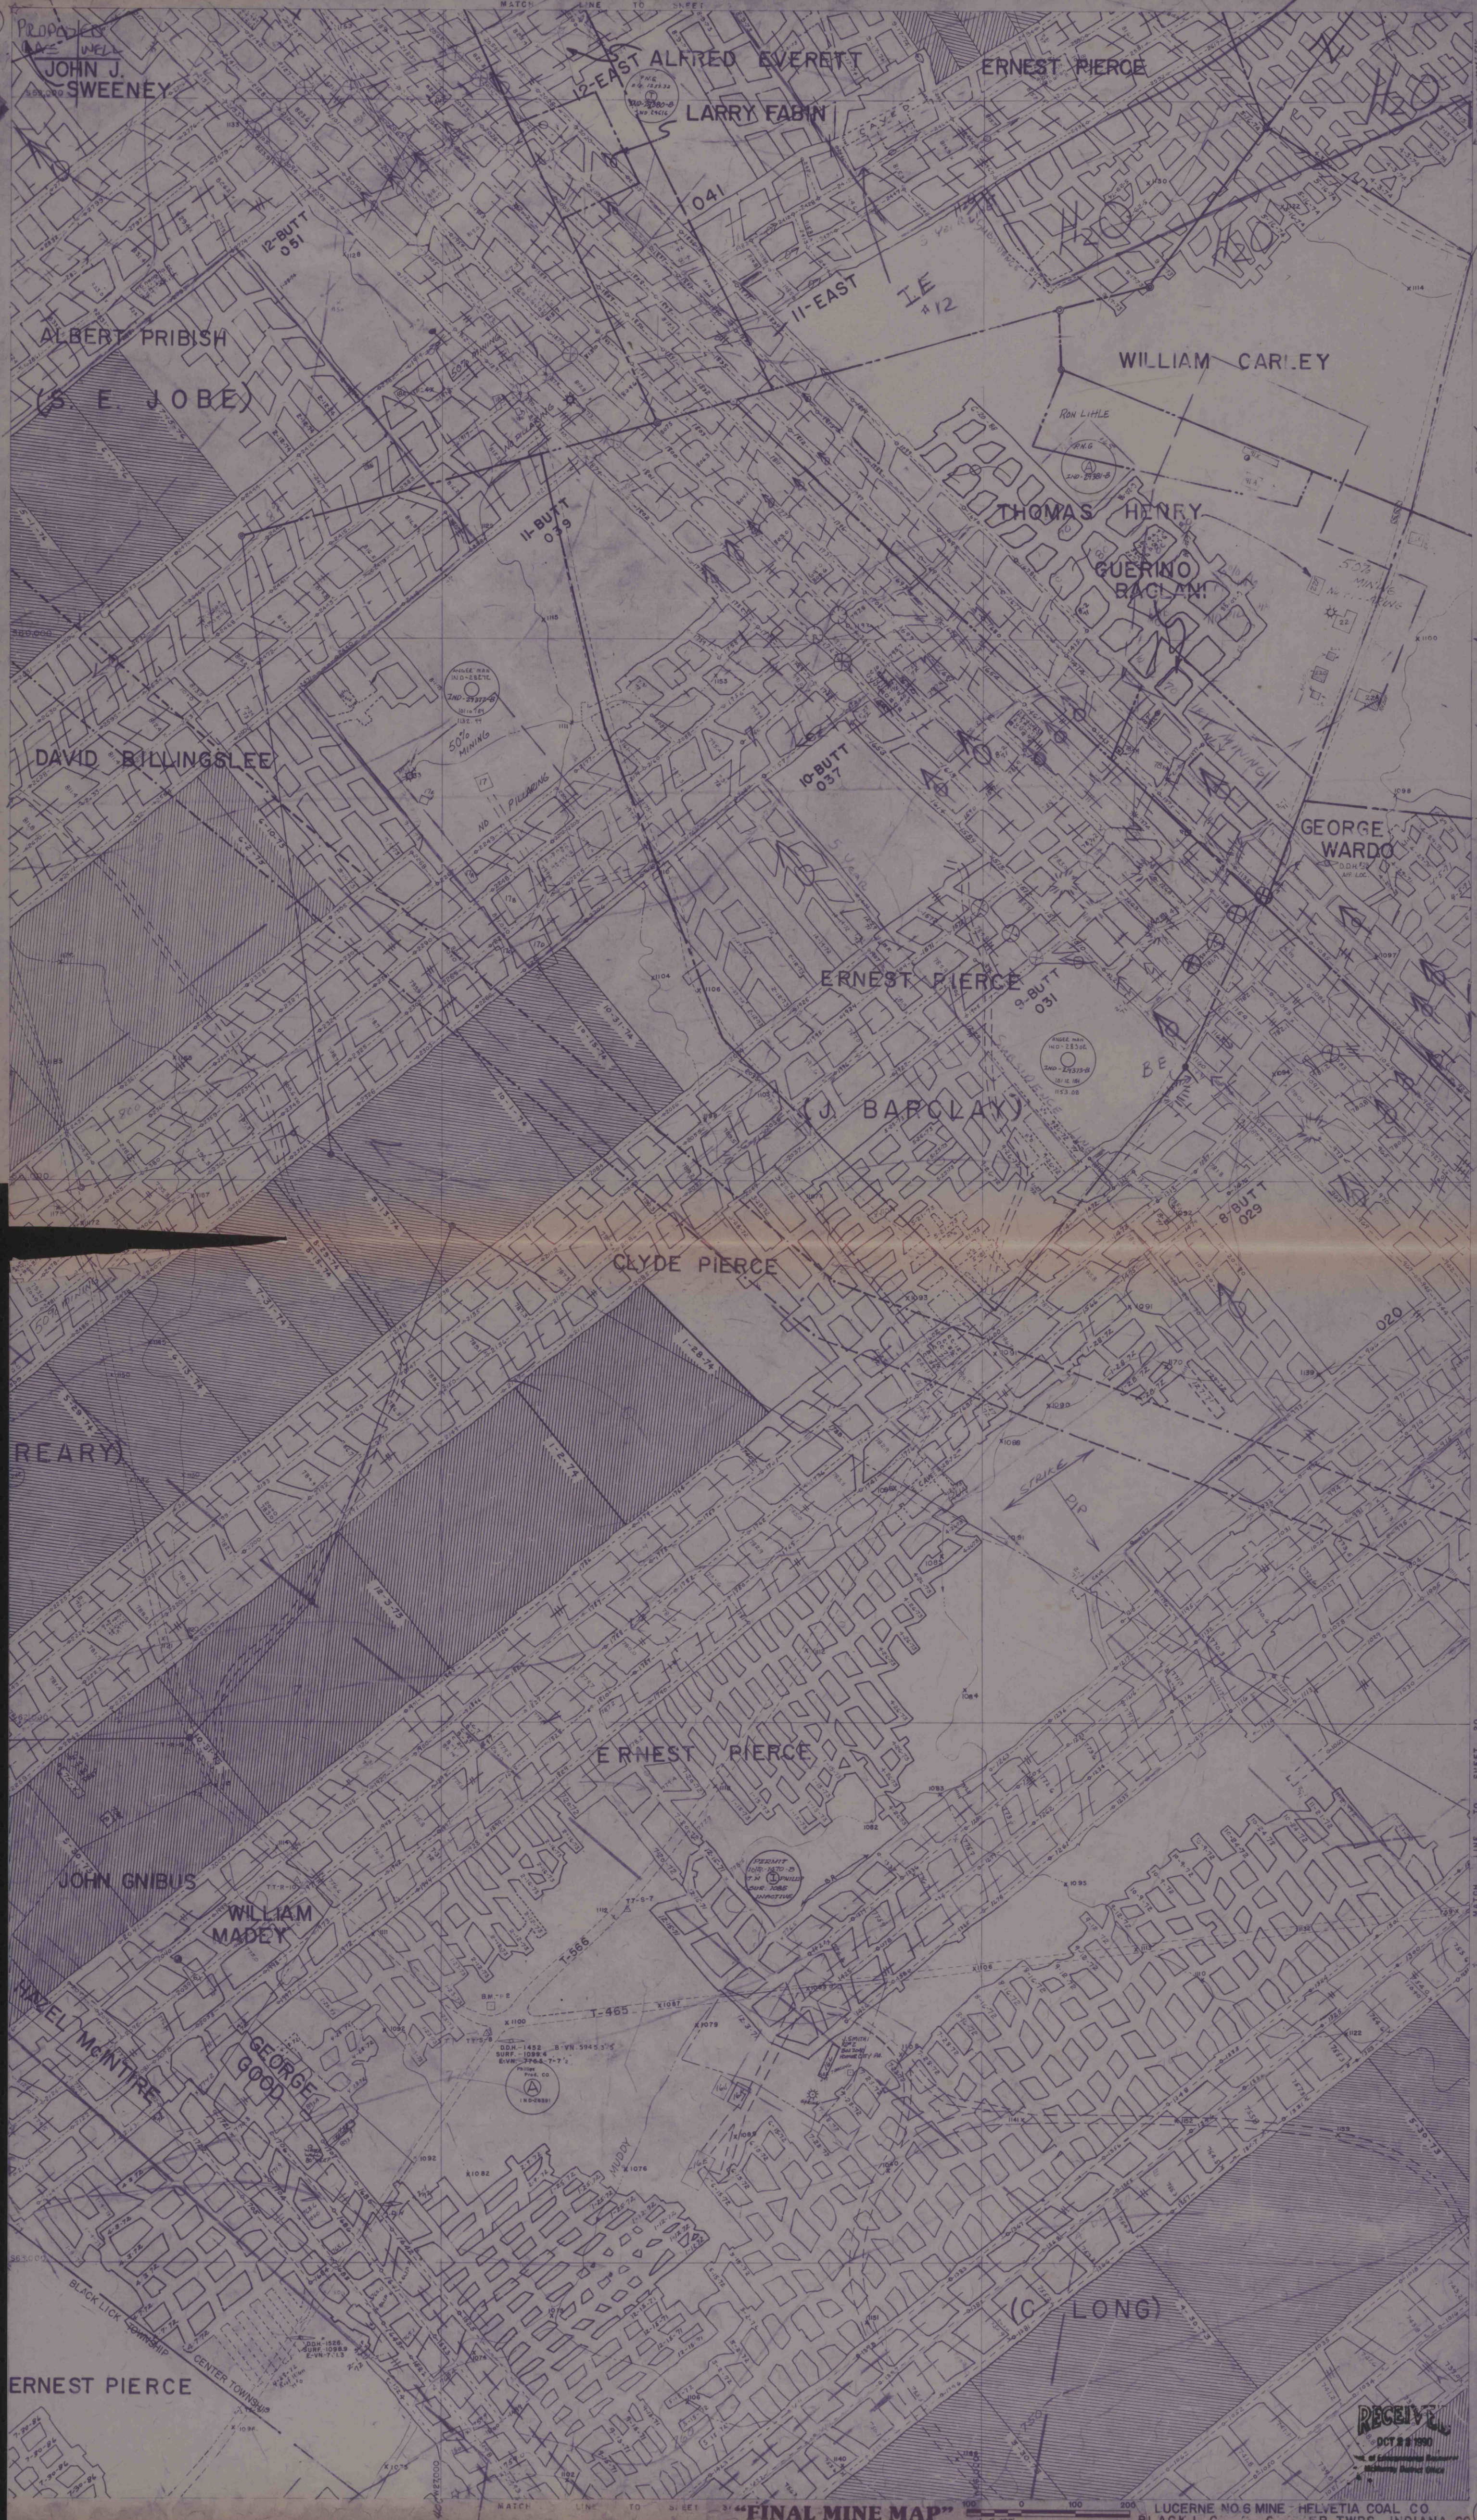

32841303

RECEIVED
OCT 28 1980
U.S. DEPARTMENT OF THE INTERIOR
BUREAU OF LAND MANAGEMENT
Helvetia Coal Co.

ERNEST PIERCE

LUCERNE NO. 6 MINE - HELVETIA COAL CO
BLACK LICK TOWNSHIP, CENTER TOWNSHIP, INDIANA CO.

FINAL MINE MAP