


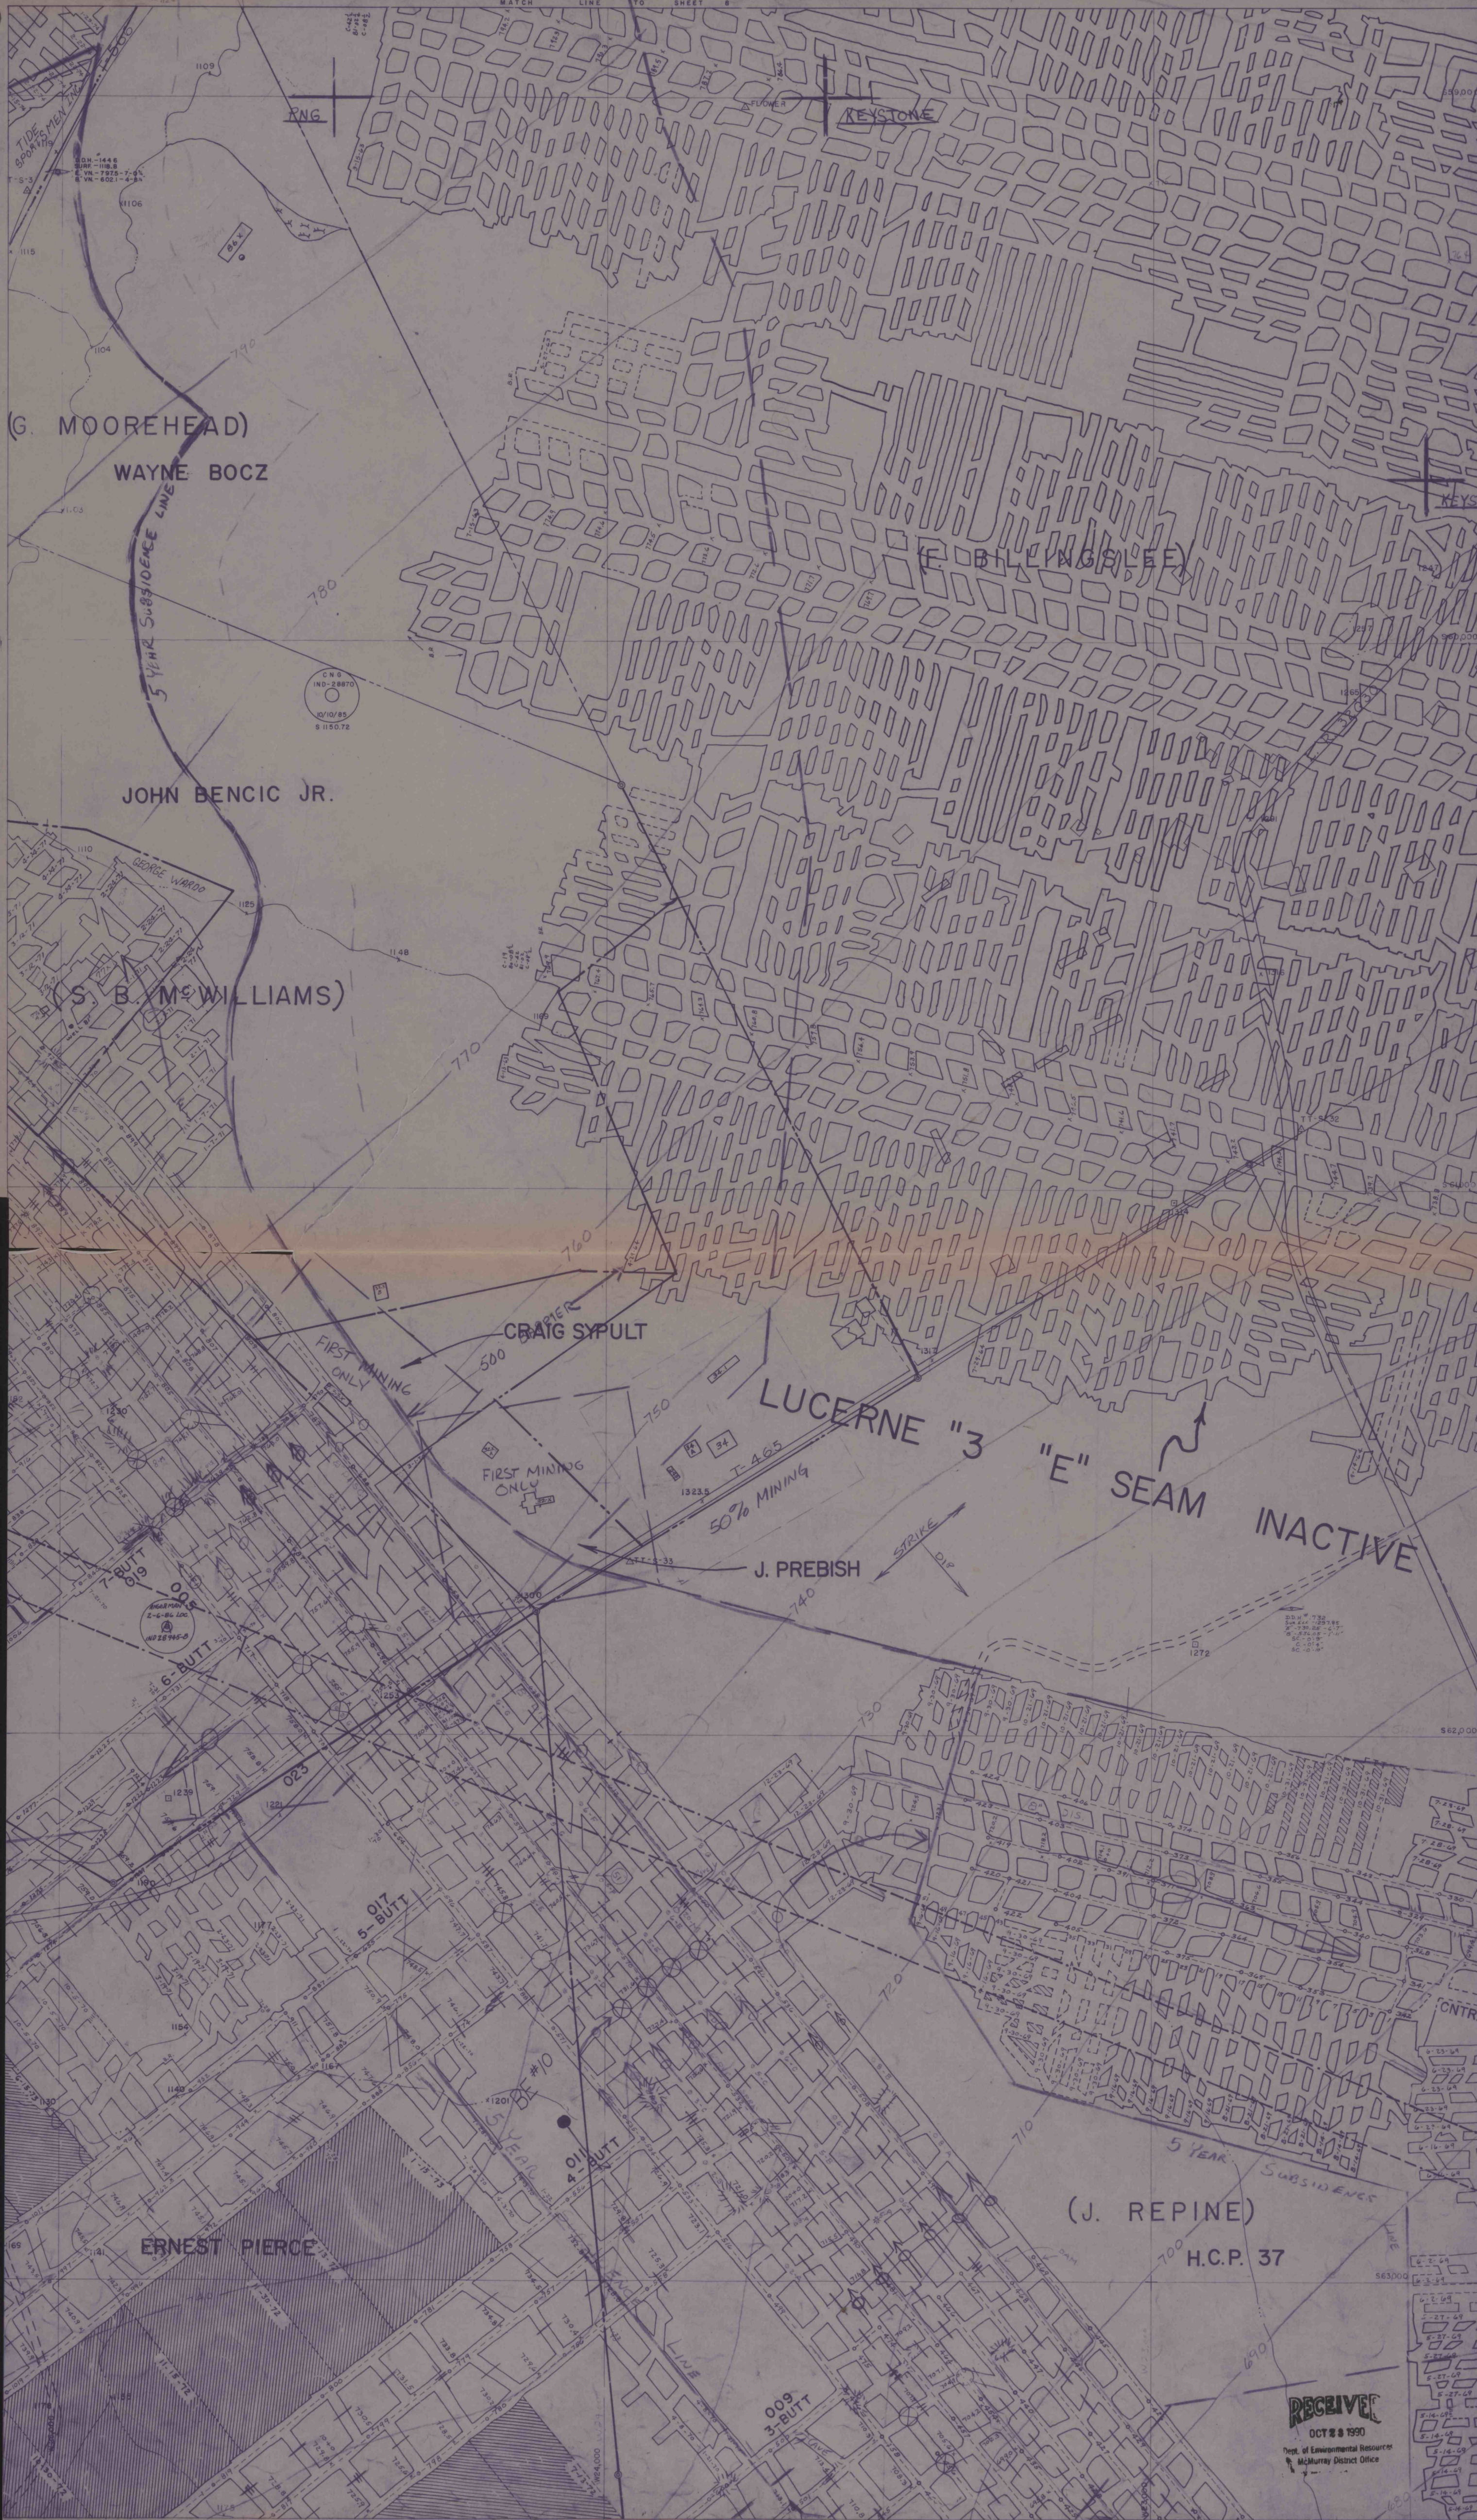

C.N.S.
IND-28870
10/10/85
S 1150.72

6-B BUTT
NO 28195-0

017
5-B BUTT

014
4-B BUTT

009
3-B BUTT

RECEIVED
OCT 23 1990
Dept. of Environmental Resources
McMurray District Office

FINAL MINE MAP

LUCERNE NO. 6 MINE - HELVETIA COAL CO.
CENTER TWP. - INDIANA CO.

32841303