


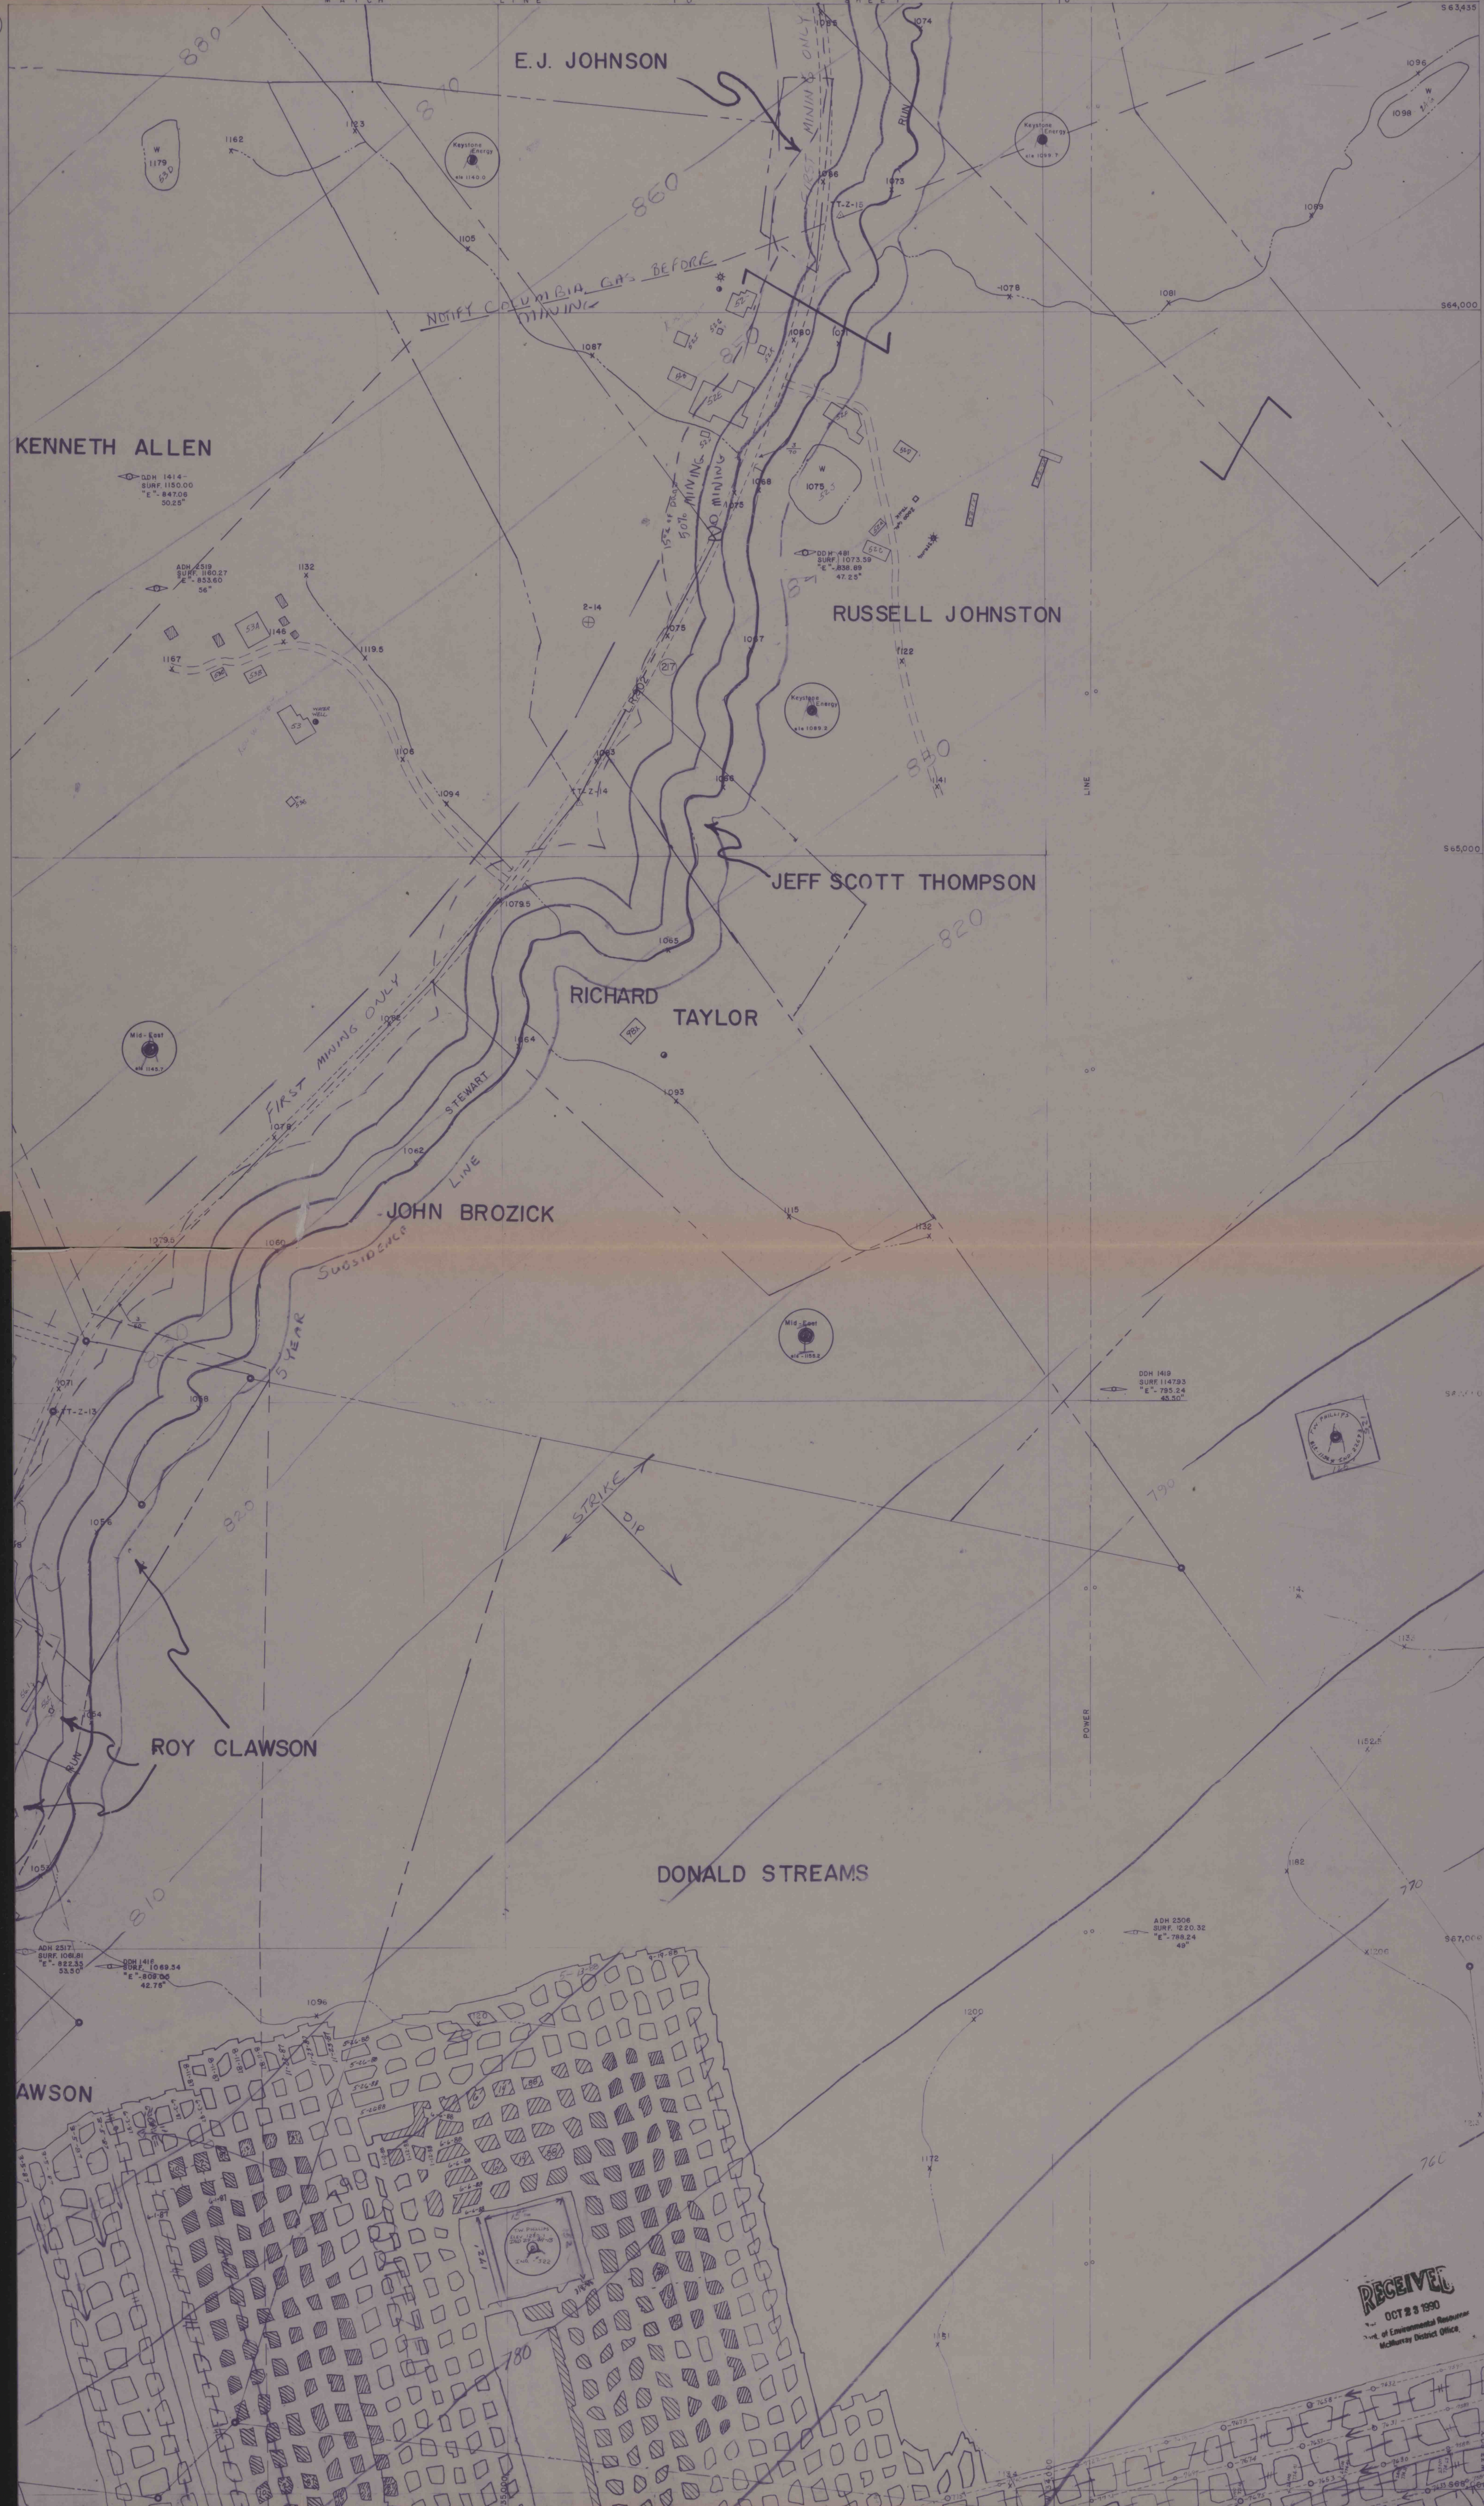

"FINAL MINE MAP"

32841303

RECEIVED
OCT 23 1990
U.S. Department of Environmental Protection
McMurray District Office

LUCERNE NO. 6 MINE - HELVETIA COAL CO.
BLACKLICK TWP., INDIANA CO.