


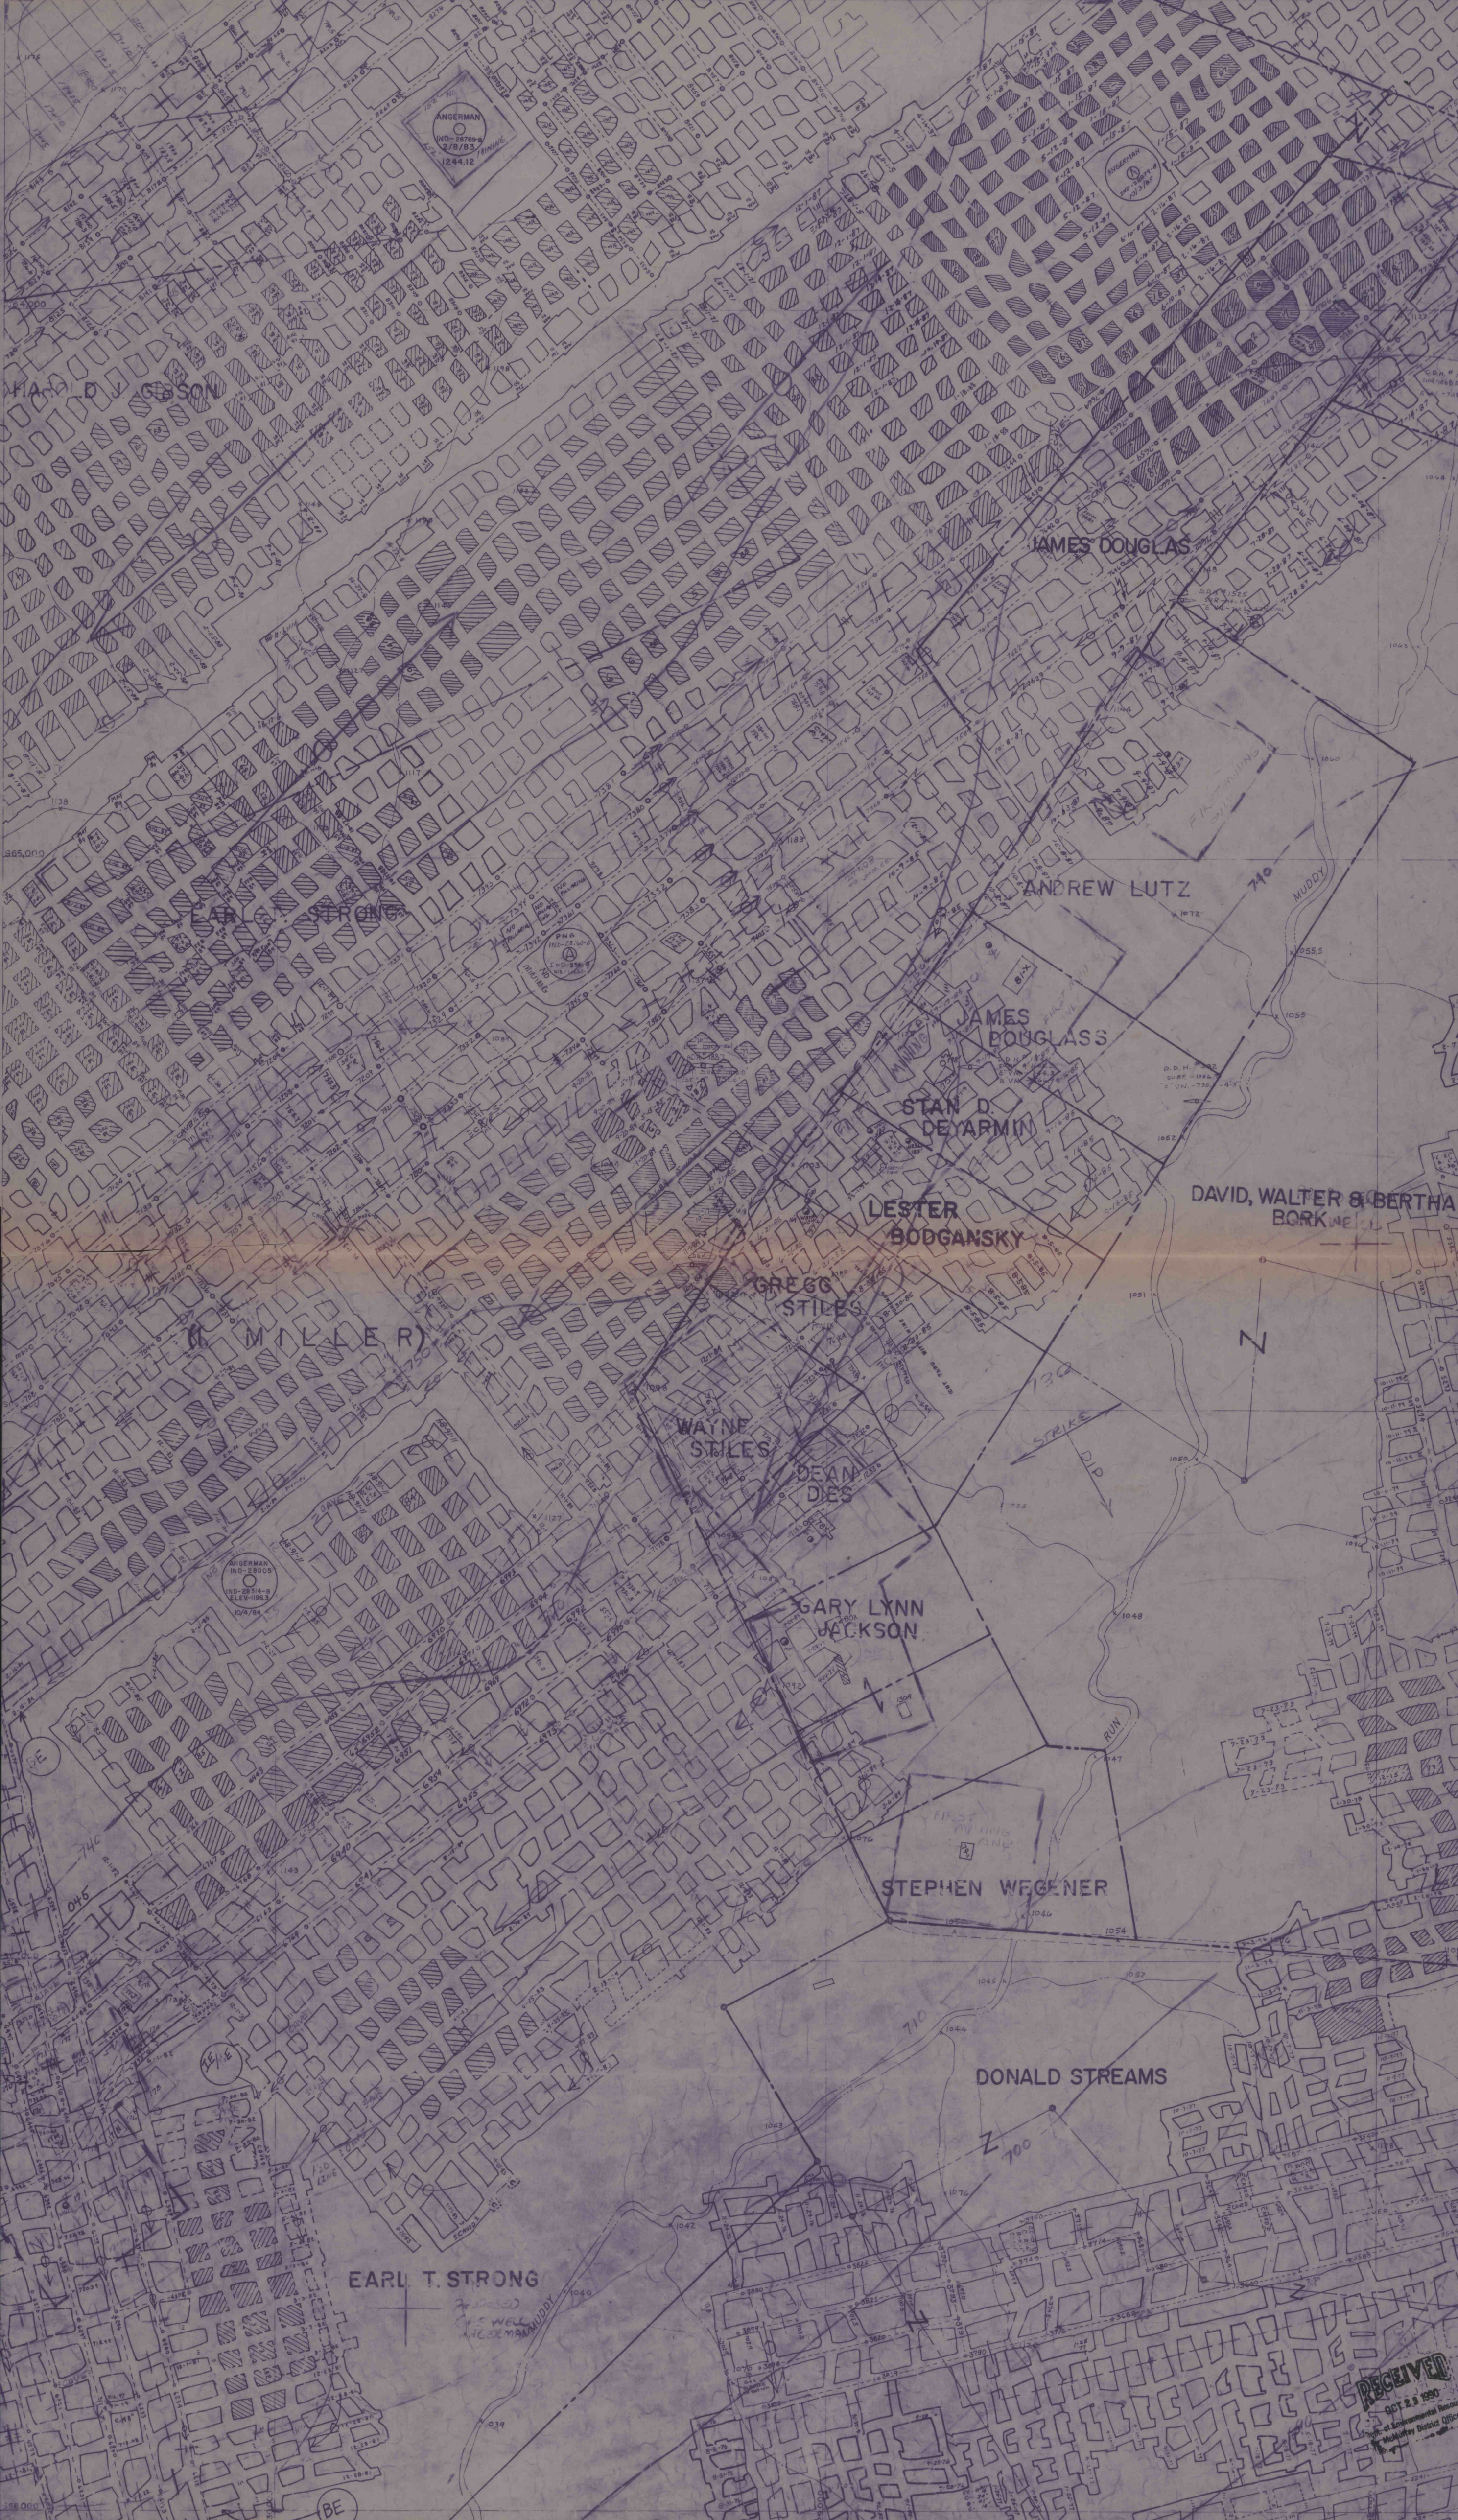

RECEIVED
OCT 23 1990
