


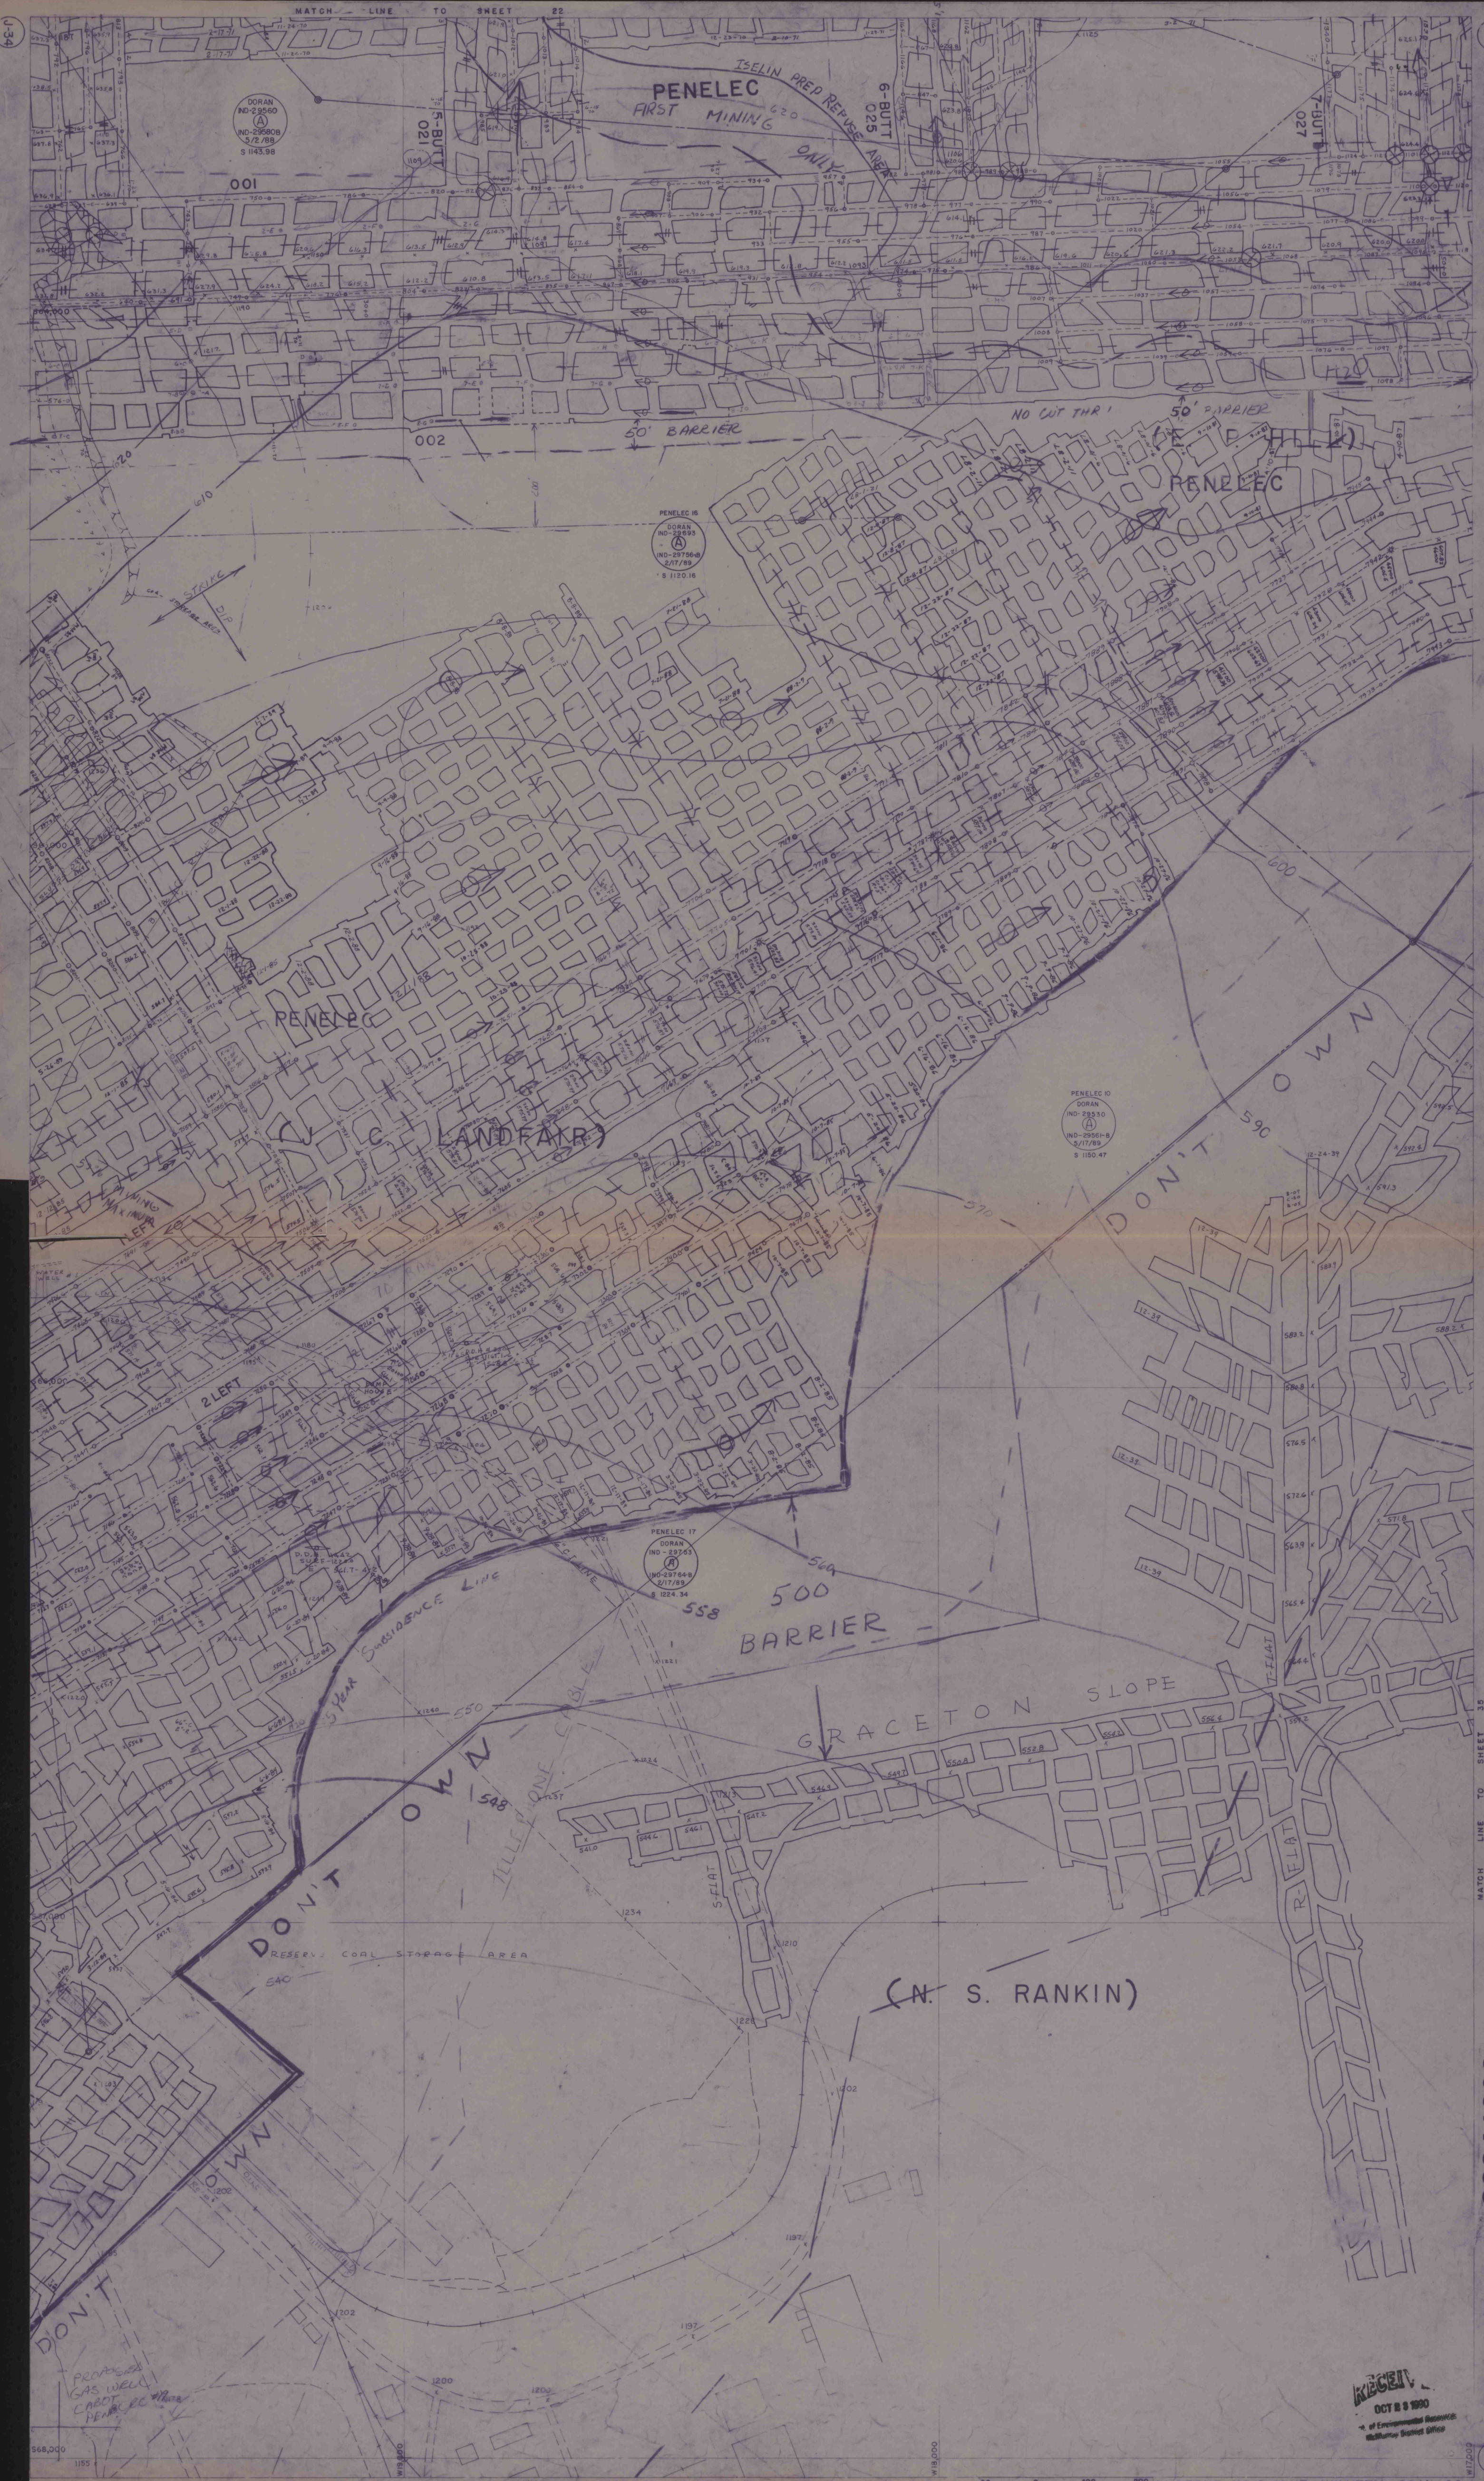

1-34

J-34

MATCH LINE TO SHEET 46

MATCH LINE TO SHEET 35

"FINAL MINE MAP"

32841303

1"=100'

J-34

0 100 200 feet
Scale 1"=100'

LUCERNE NO. 6 MINE - HELVETIA COAL CO.
CENTER TWP. - INDIANA CO.

RECEIVED
OCT 29 1990
U.S. Environmental Research
McHenry Survey Office