


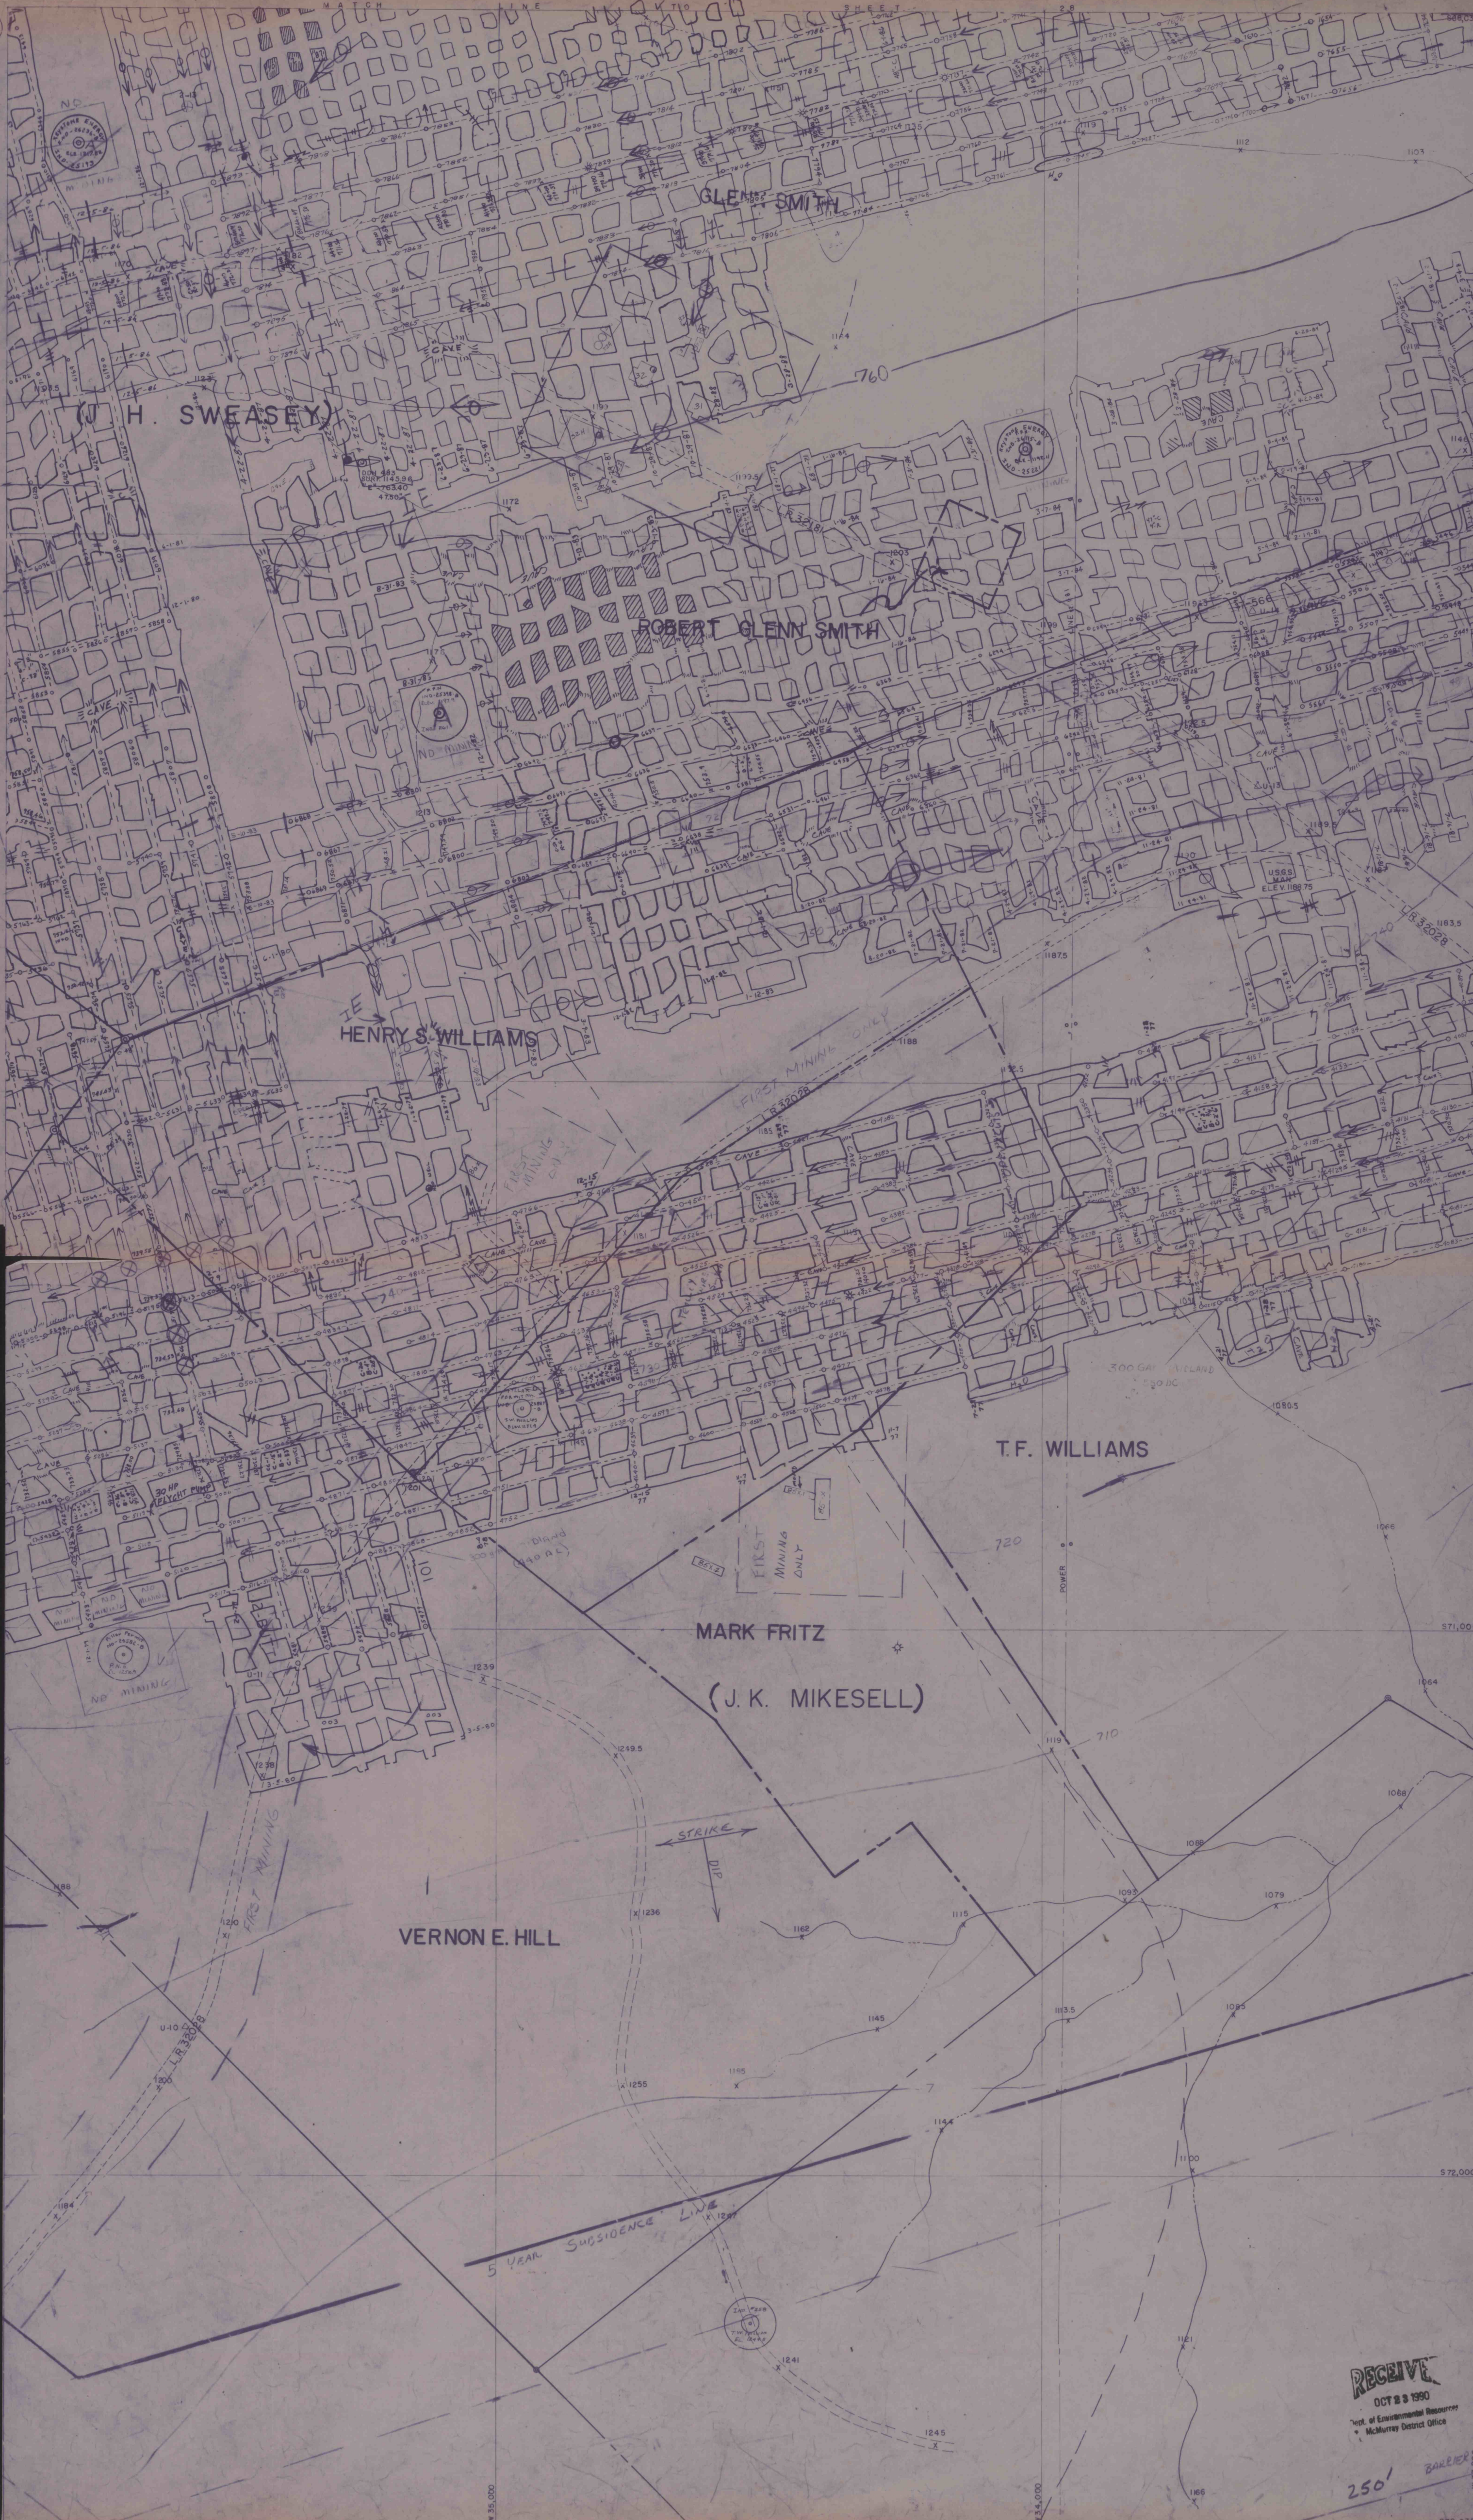

149

"FINAL MINE MAP"

32841303

149

RECEIVED
OCT 23 1990
Dept. of Environmental Resources
McMurry District Office

250'