


J-43

J-43

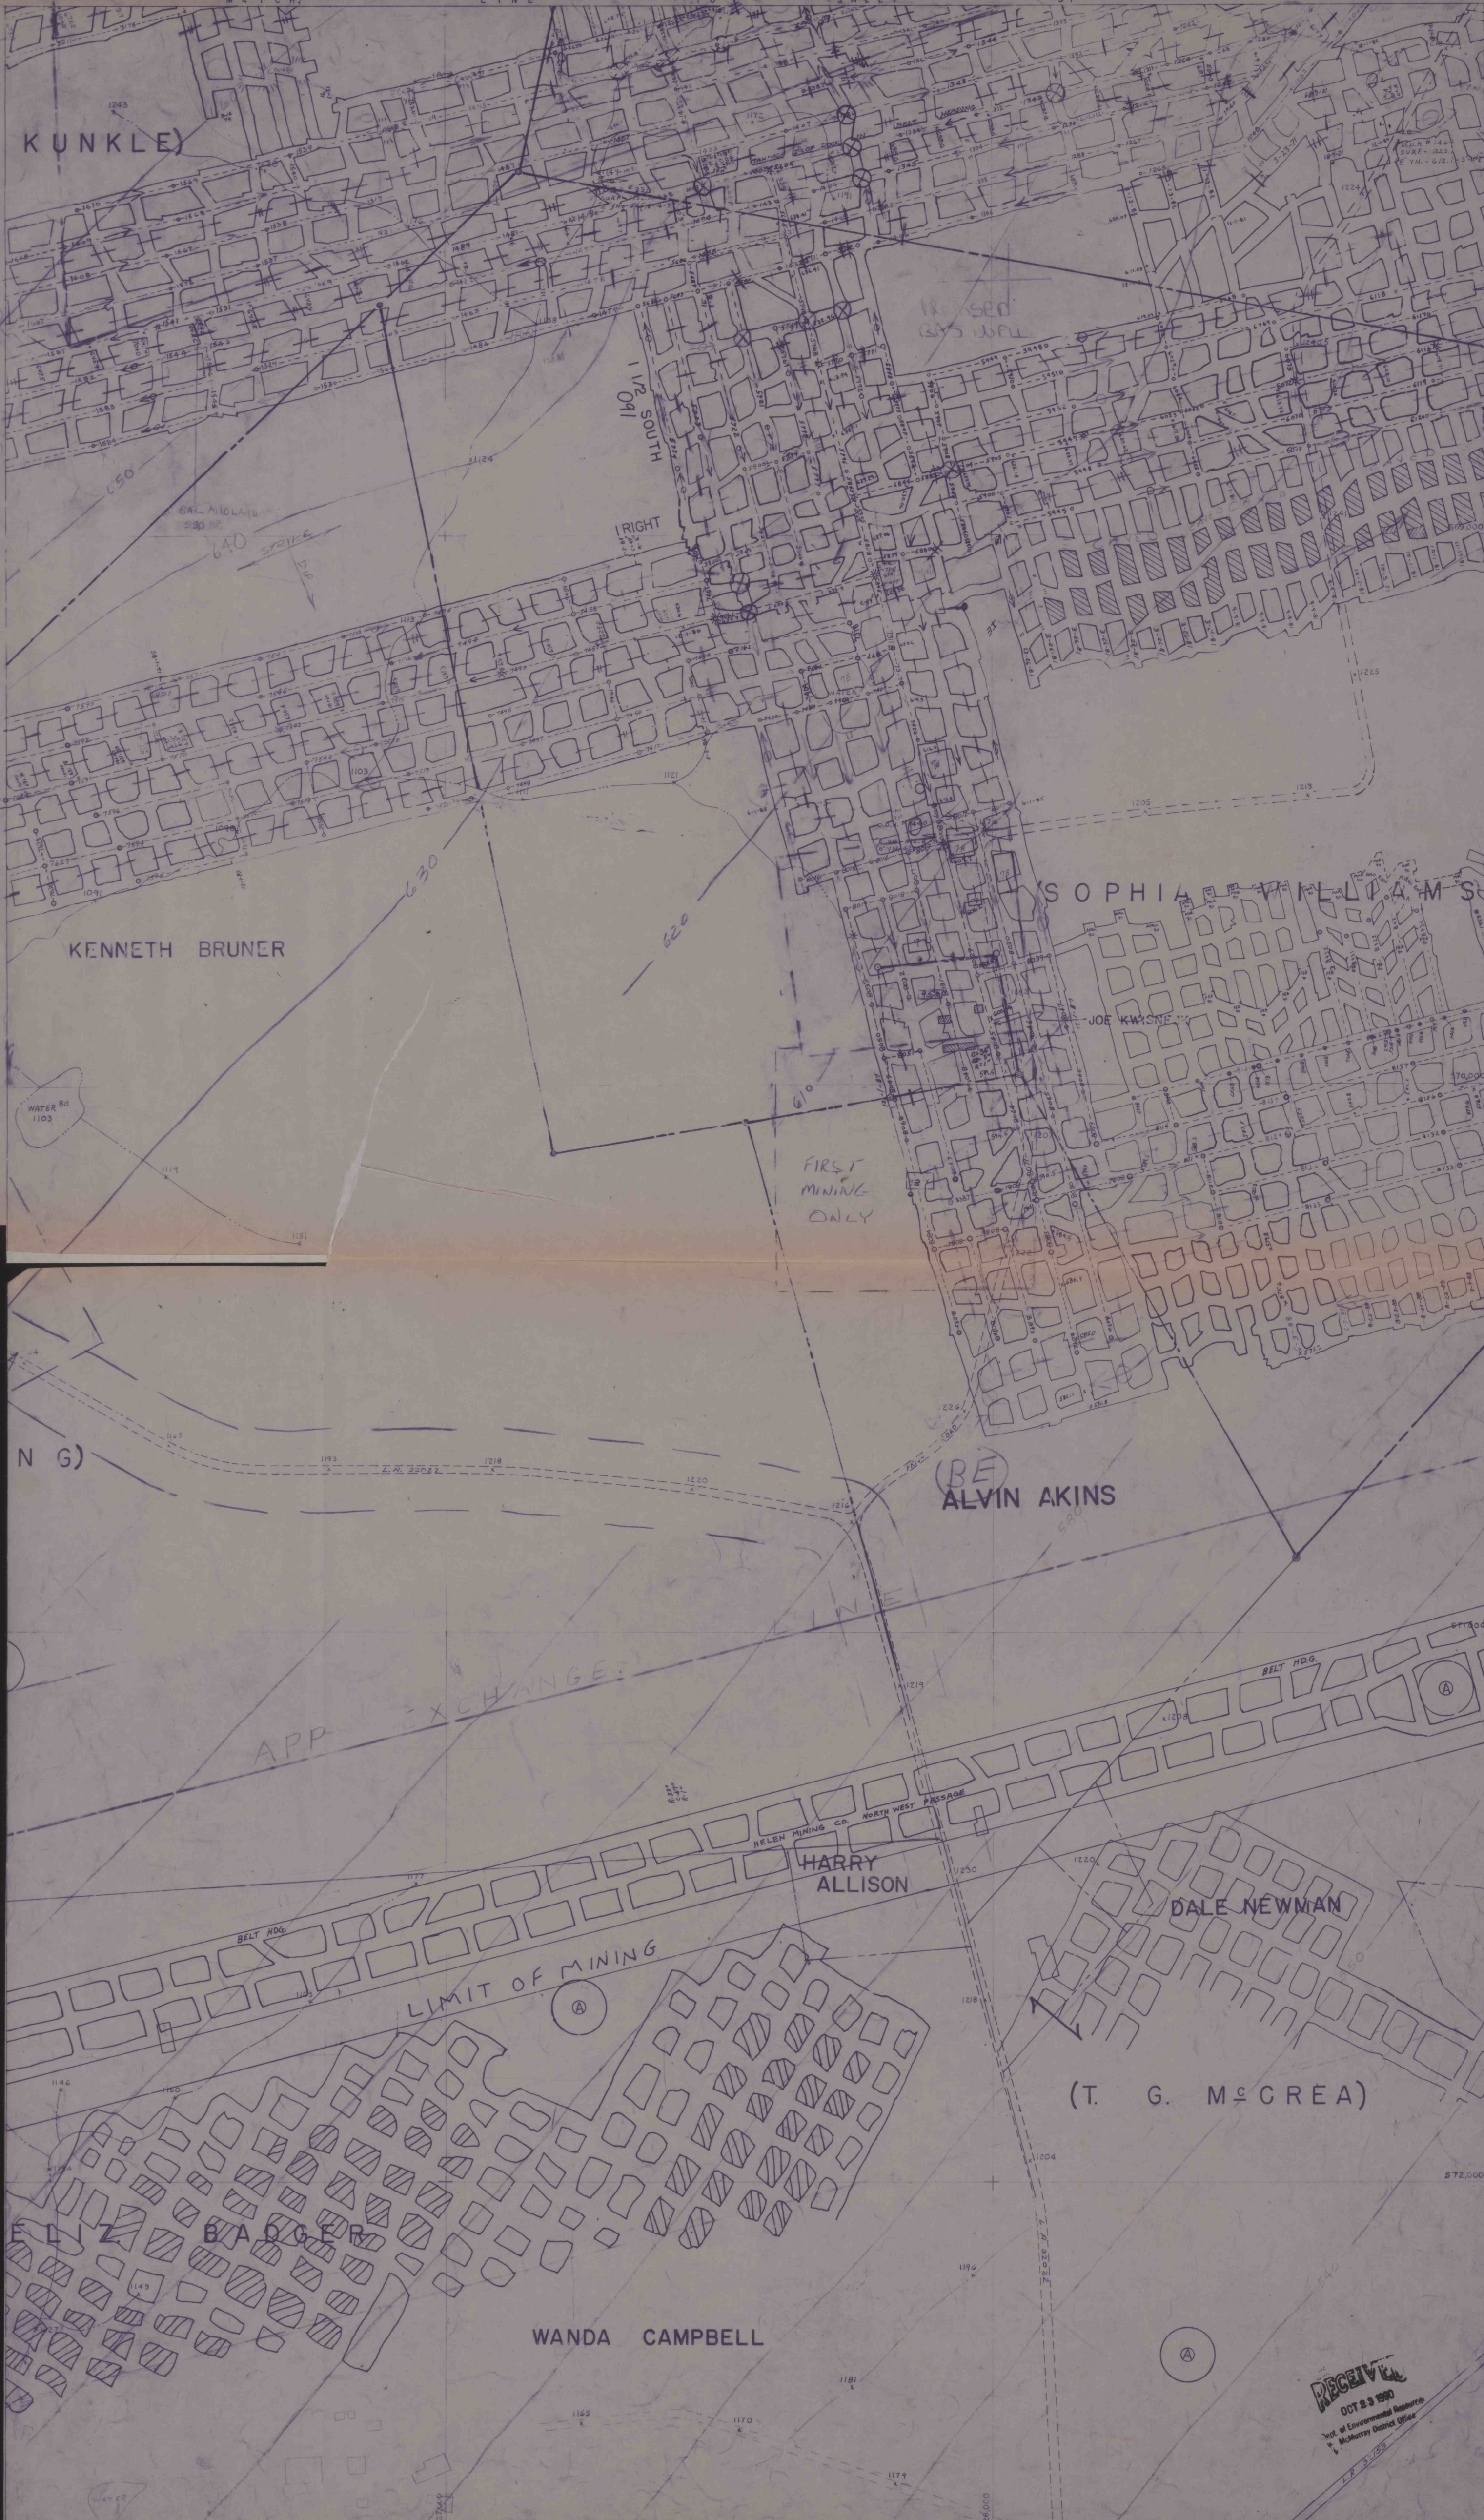

"FINAL MINE MAP"

32841303

J-43

RECEIVED
OCT 23 1990
Dept. of Environmental Resources
McMurry District Office