


J-45

J-45

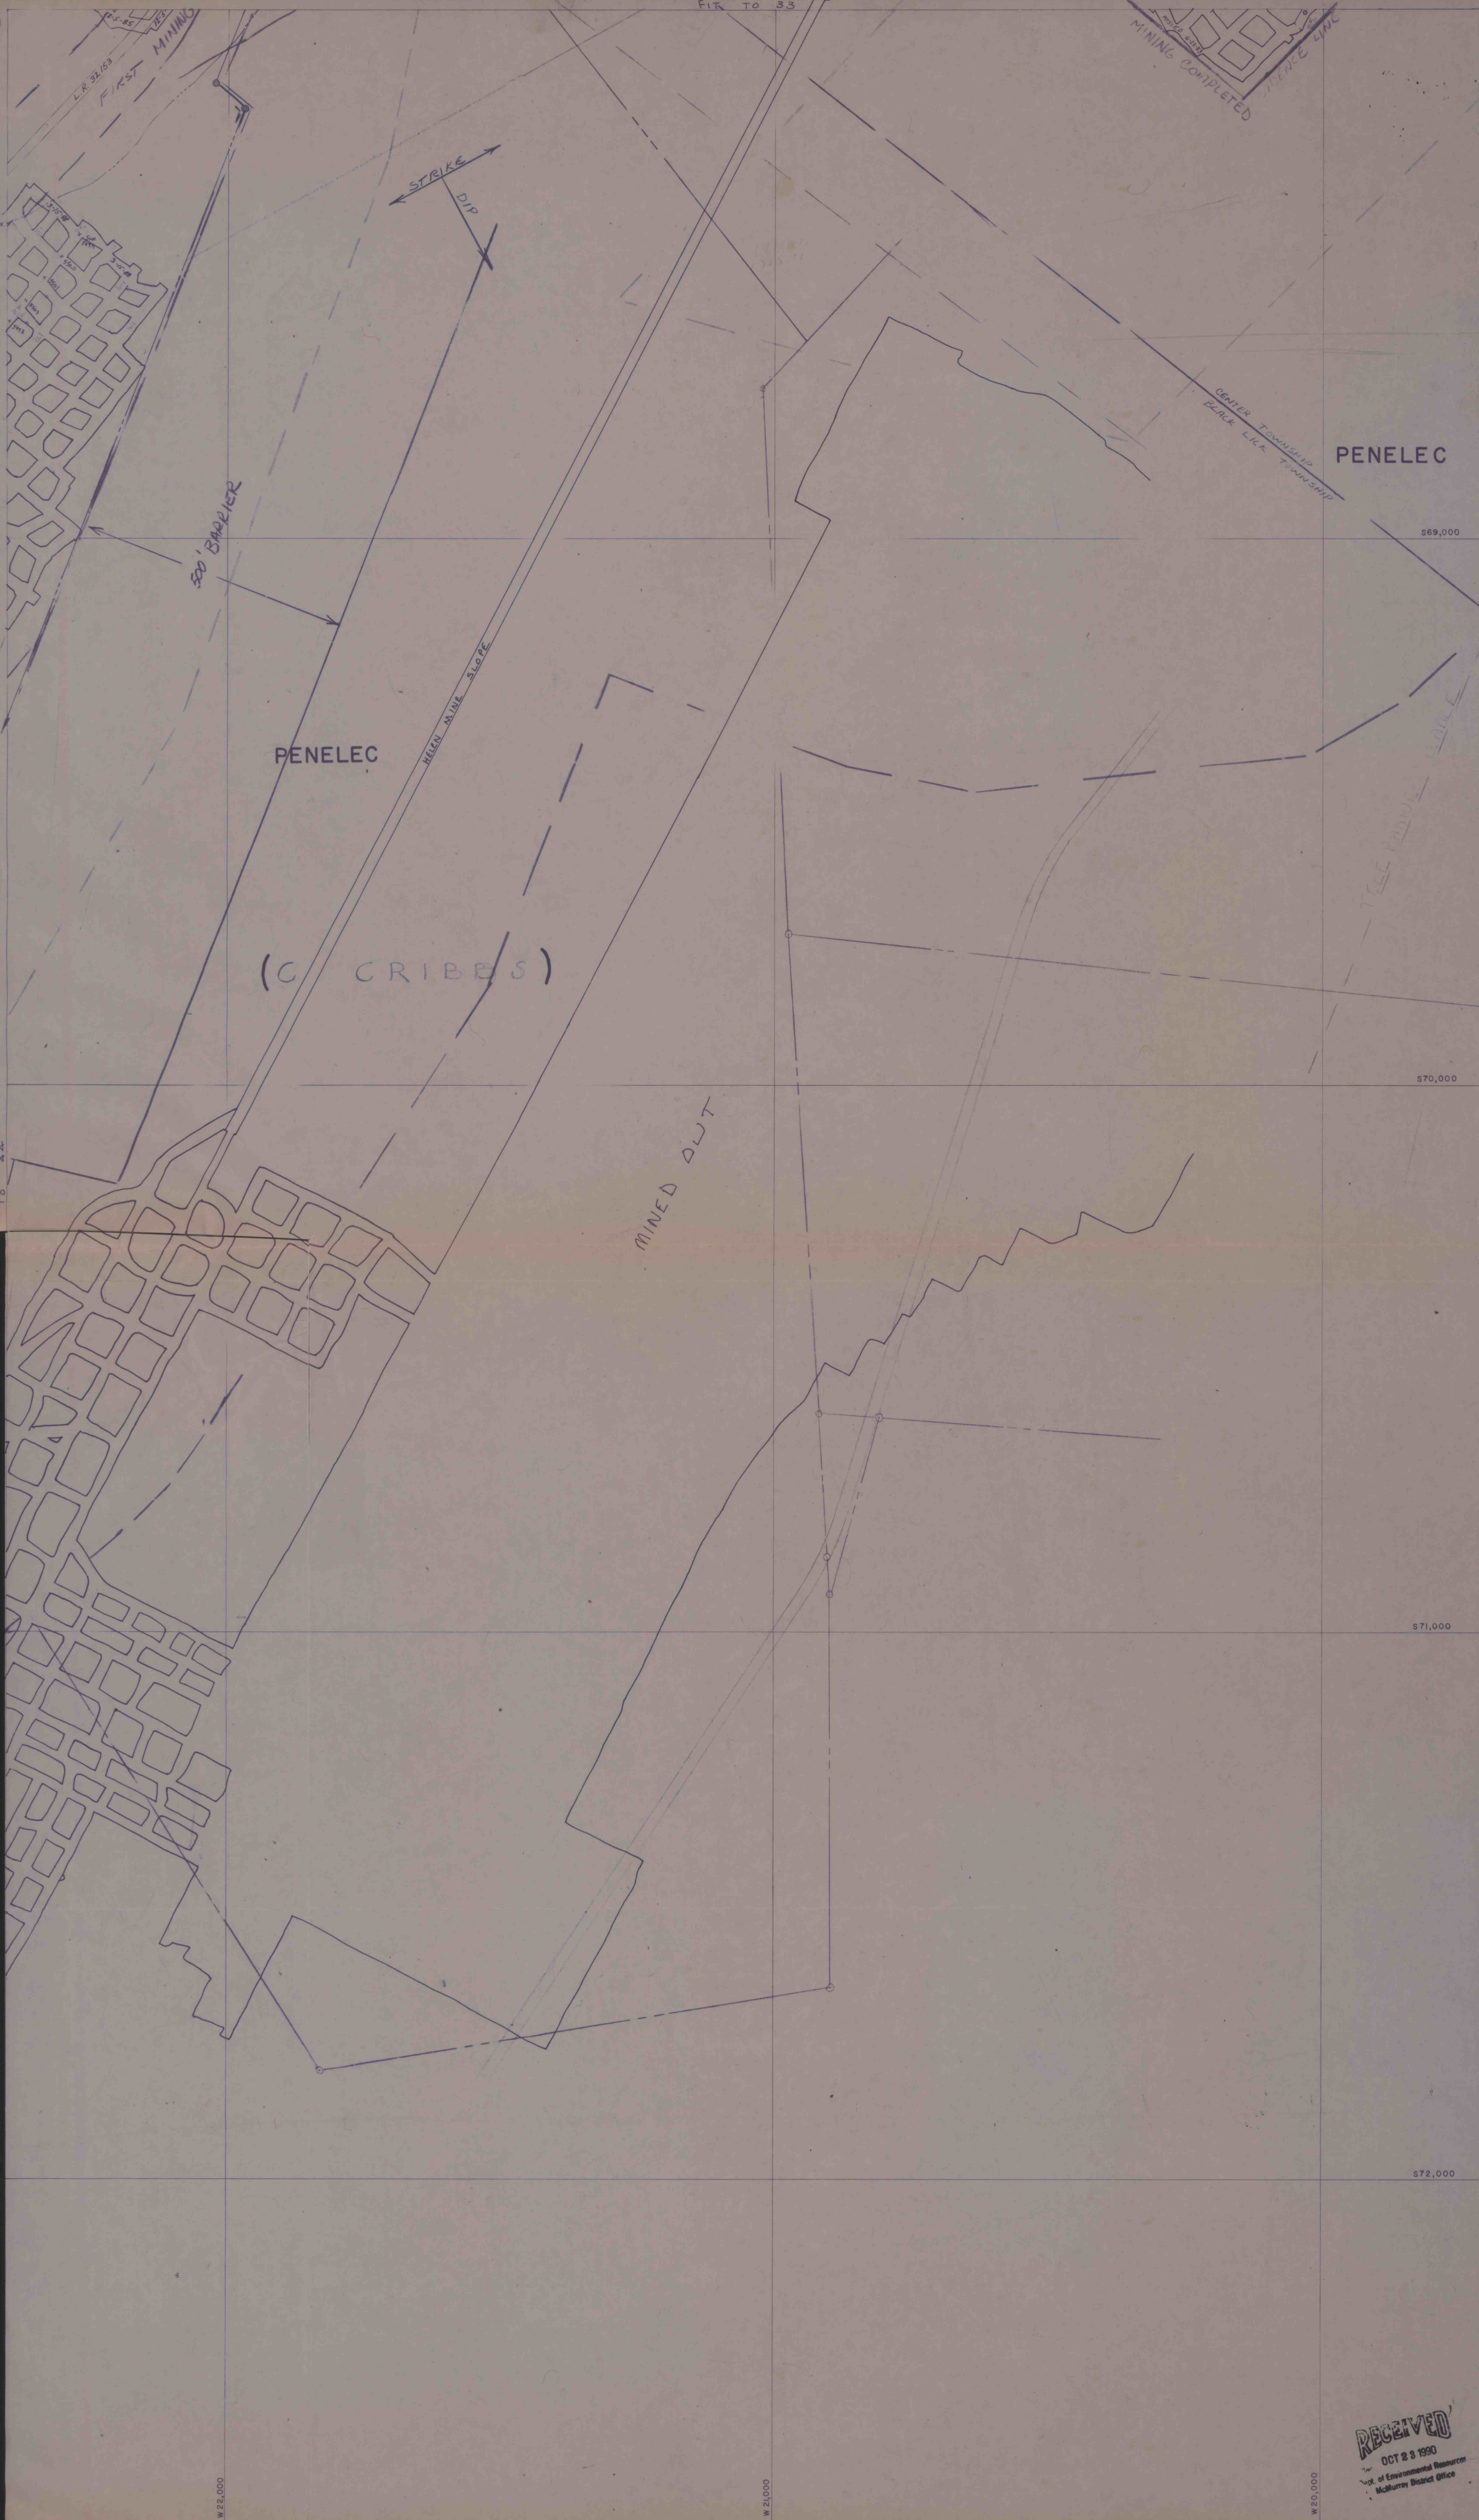

"FINAL MINE MAP"

32841303

J-45

RECEIVED
OCT 23 1990
Dept. of Environmental Resources
McMurray District Office

100 0 100 200
Scale T=100 feet

LUCERNE NO. 6 MINE - HELVETIA COAL CO
BLACKLICK TWP., INDIANA CO.