


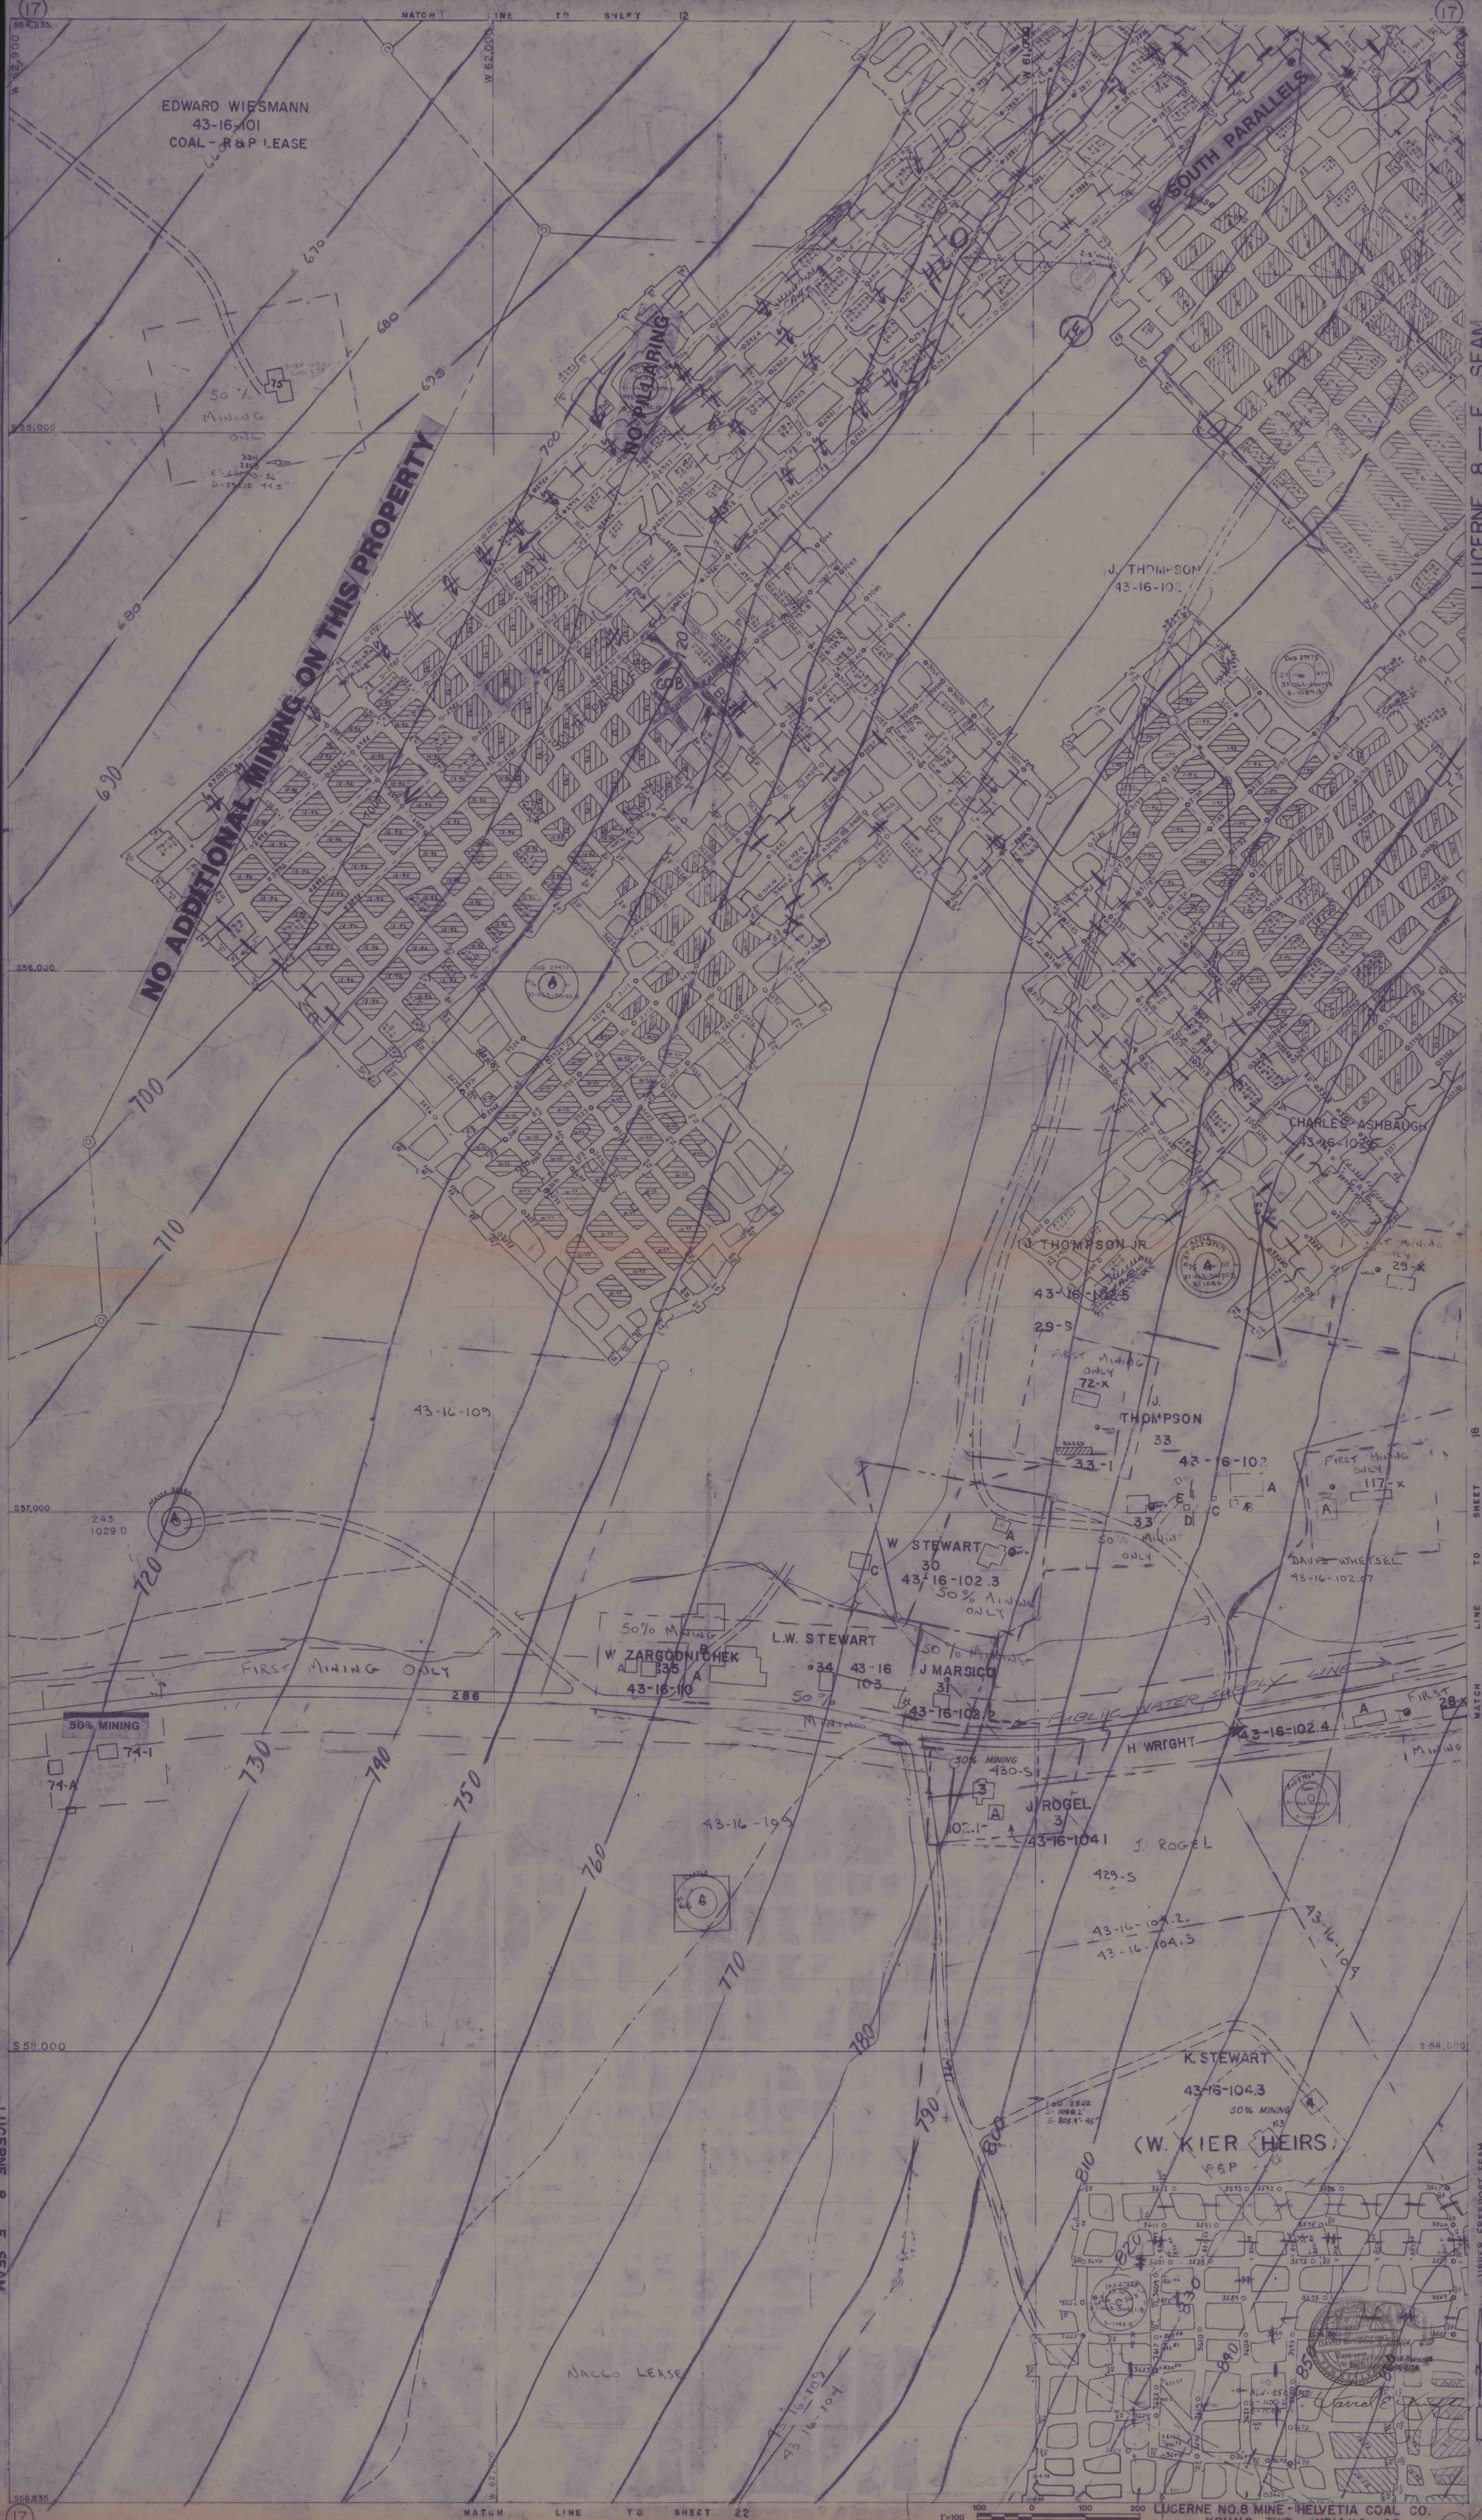

EDWARD WIESMANN
43-16-101
COAL - R & P LEASE

NO ADDITIONAL MINING ON THIS PROPERTY

NO PILLARING

J. THOMPSON
43-16-102

CHARLES ASHBAUGH
43-16-102.5

J. THOMPSON JR.
43-16-102.5

J. THOMPSON
43-16-102

W. STEWART
43-16-102.3

L.W. STEWART
43-16-103

J. MARSICO
43-16-102.2

J. ROGEL
43-16-104.1

K. STEWART
43-16-104.3

(W. KIER HEIRS)
43-16-104.3