


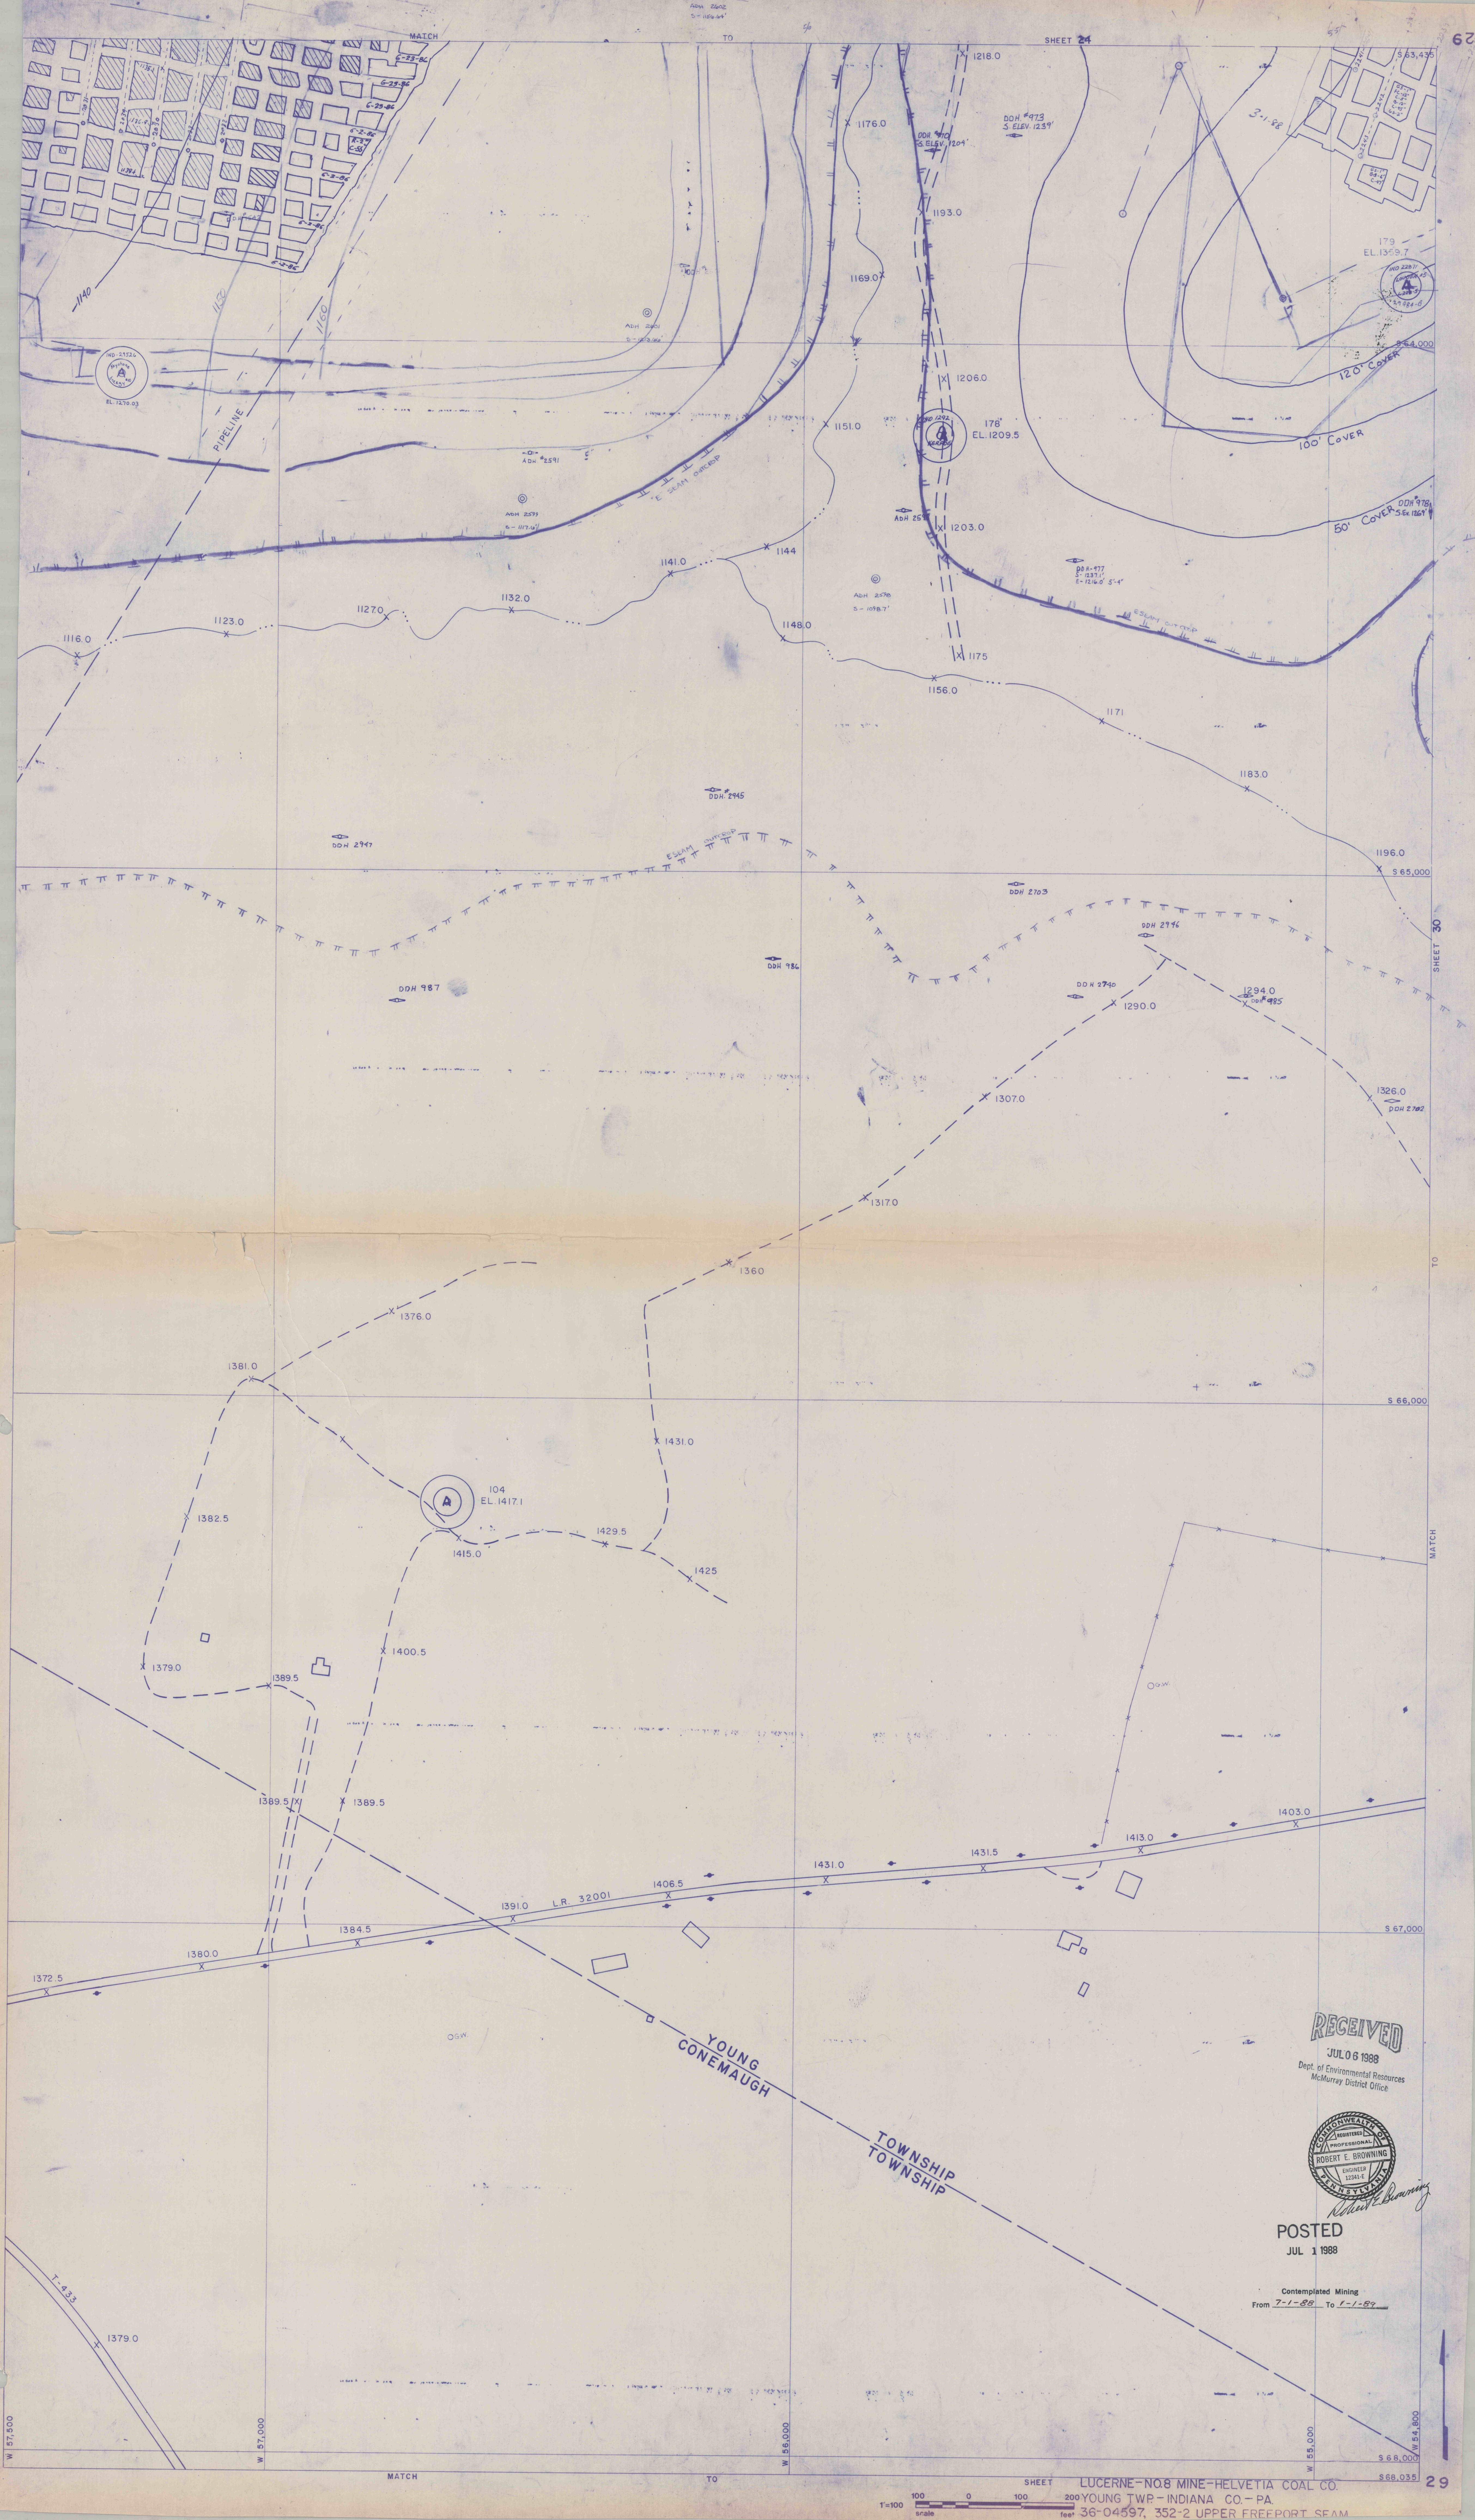

RECEIVED
JUL 06 1988

JUL 06 1988
Dept. of Environmental Resources
McMurray District Office



POSTED
JUL 1 1988

Contemplated Mining
From 7-1-88 To 1-1-89

LUCERNE-NO.8 MINE-HELVETIA COAL CO

200 YOUNG TWP. - INDIANA CO. - PA

feet 36-04597, 352-2 UPPER FREEPORT SEAM