


563,435

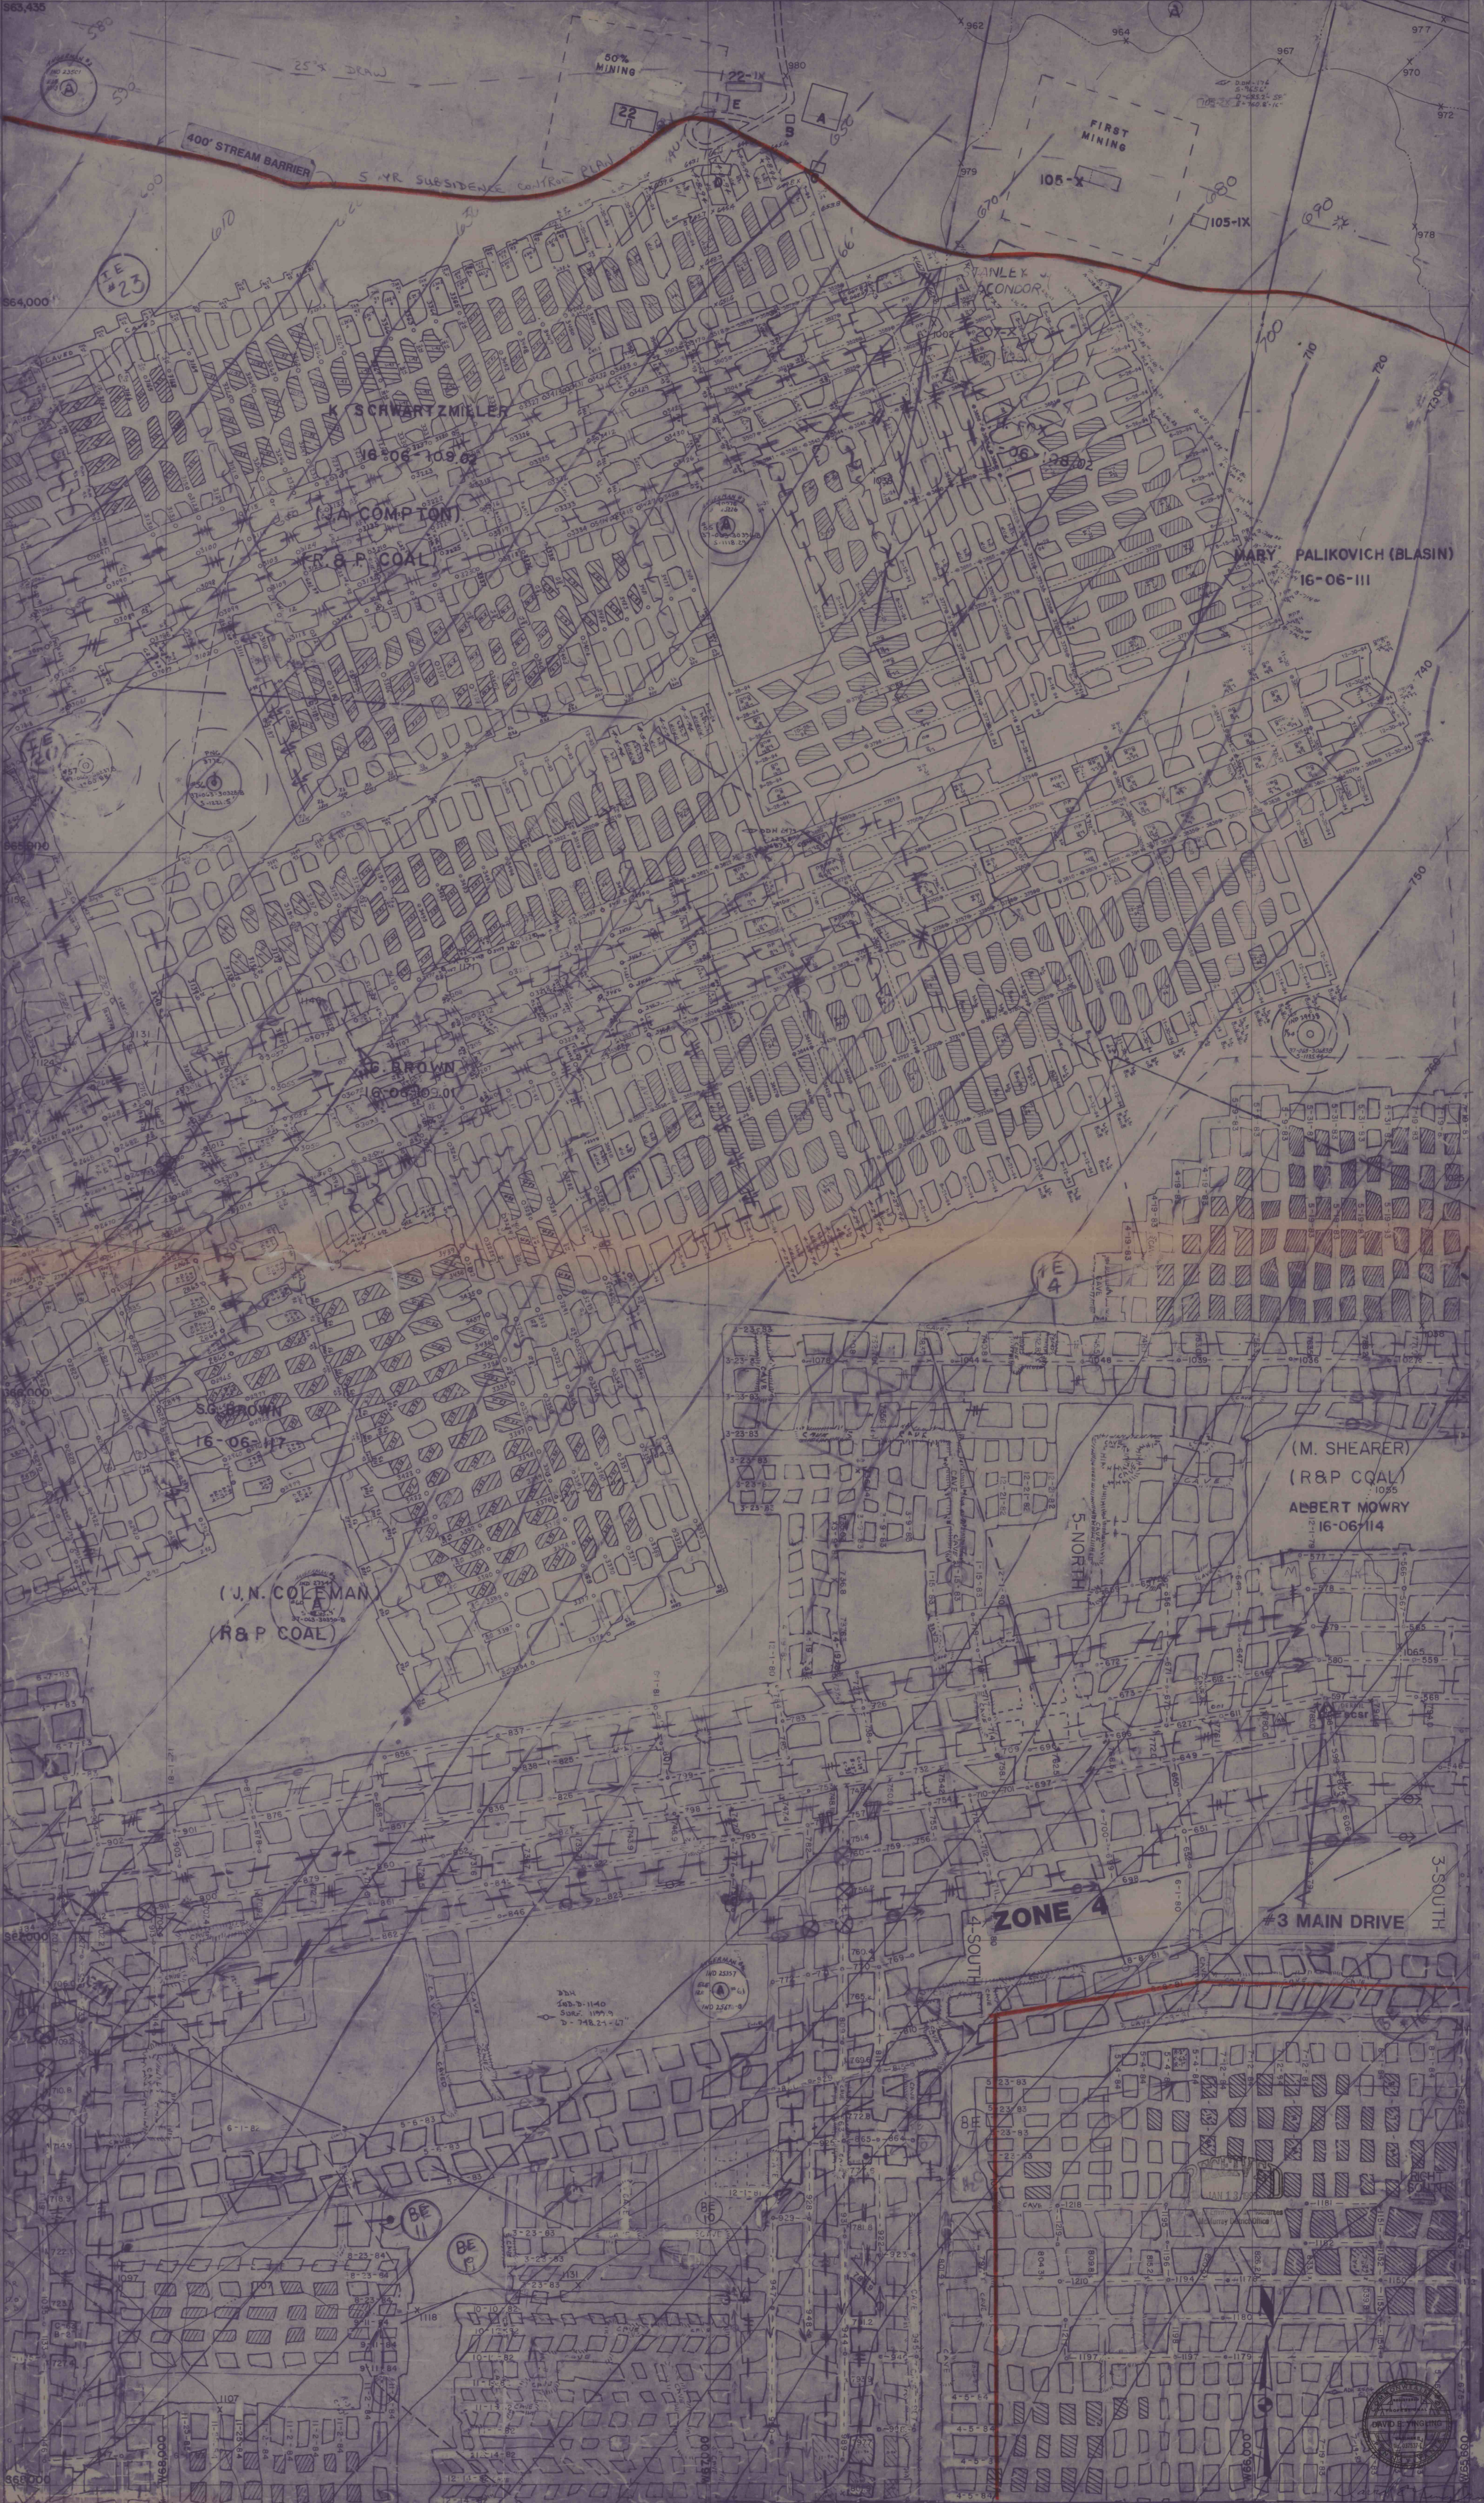

SHEET 13

TO

LINE

MATCH