


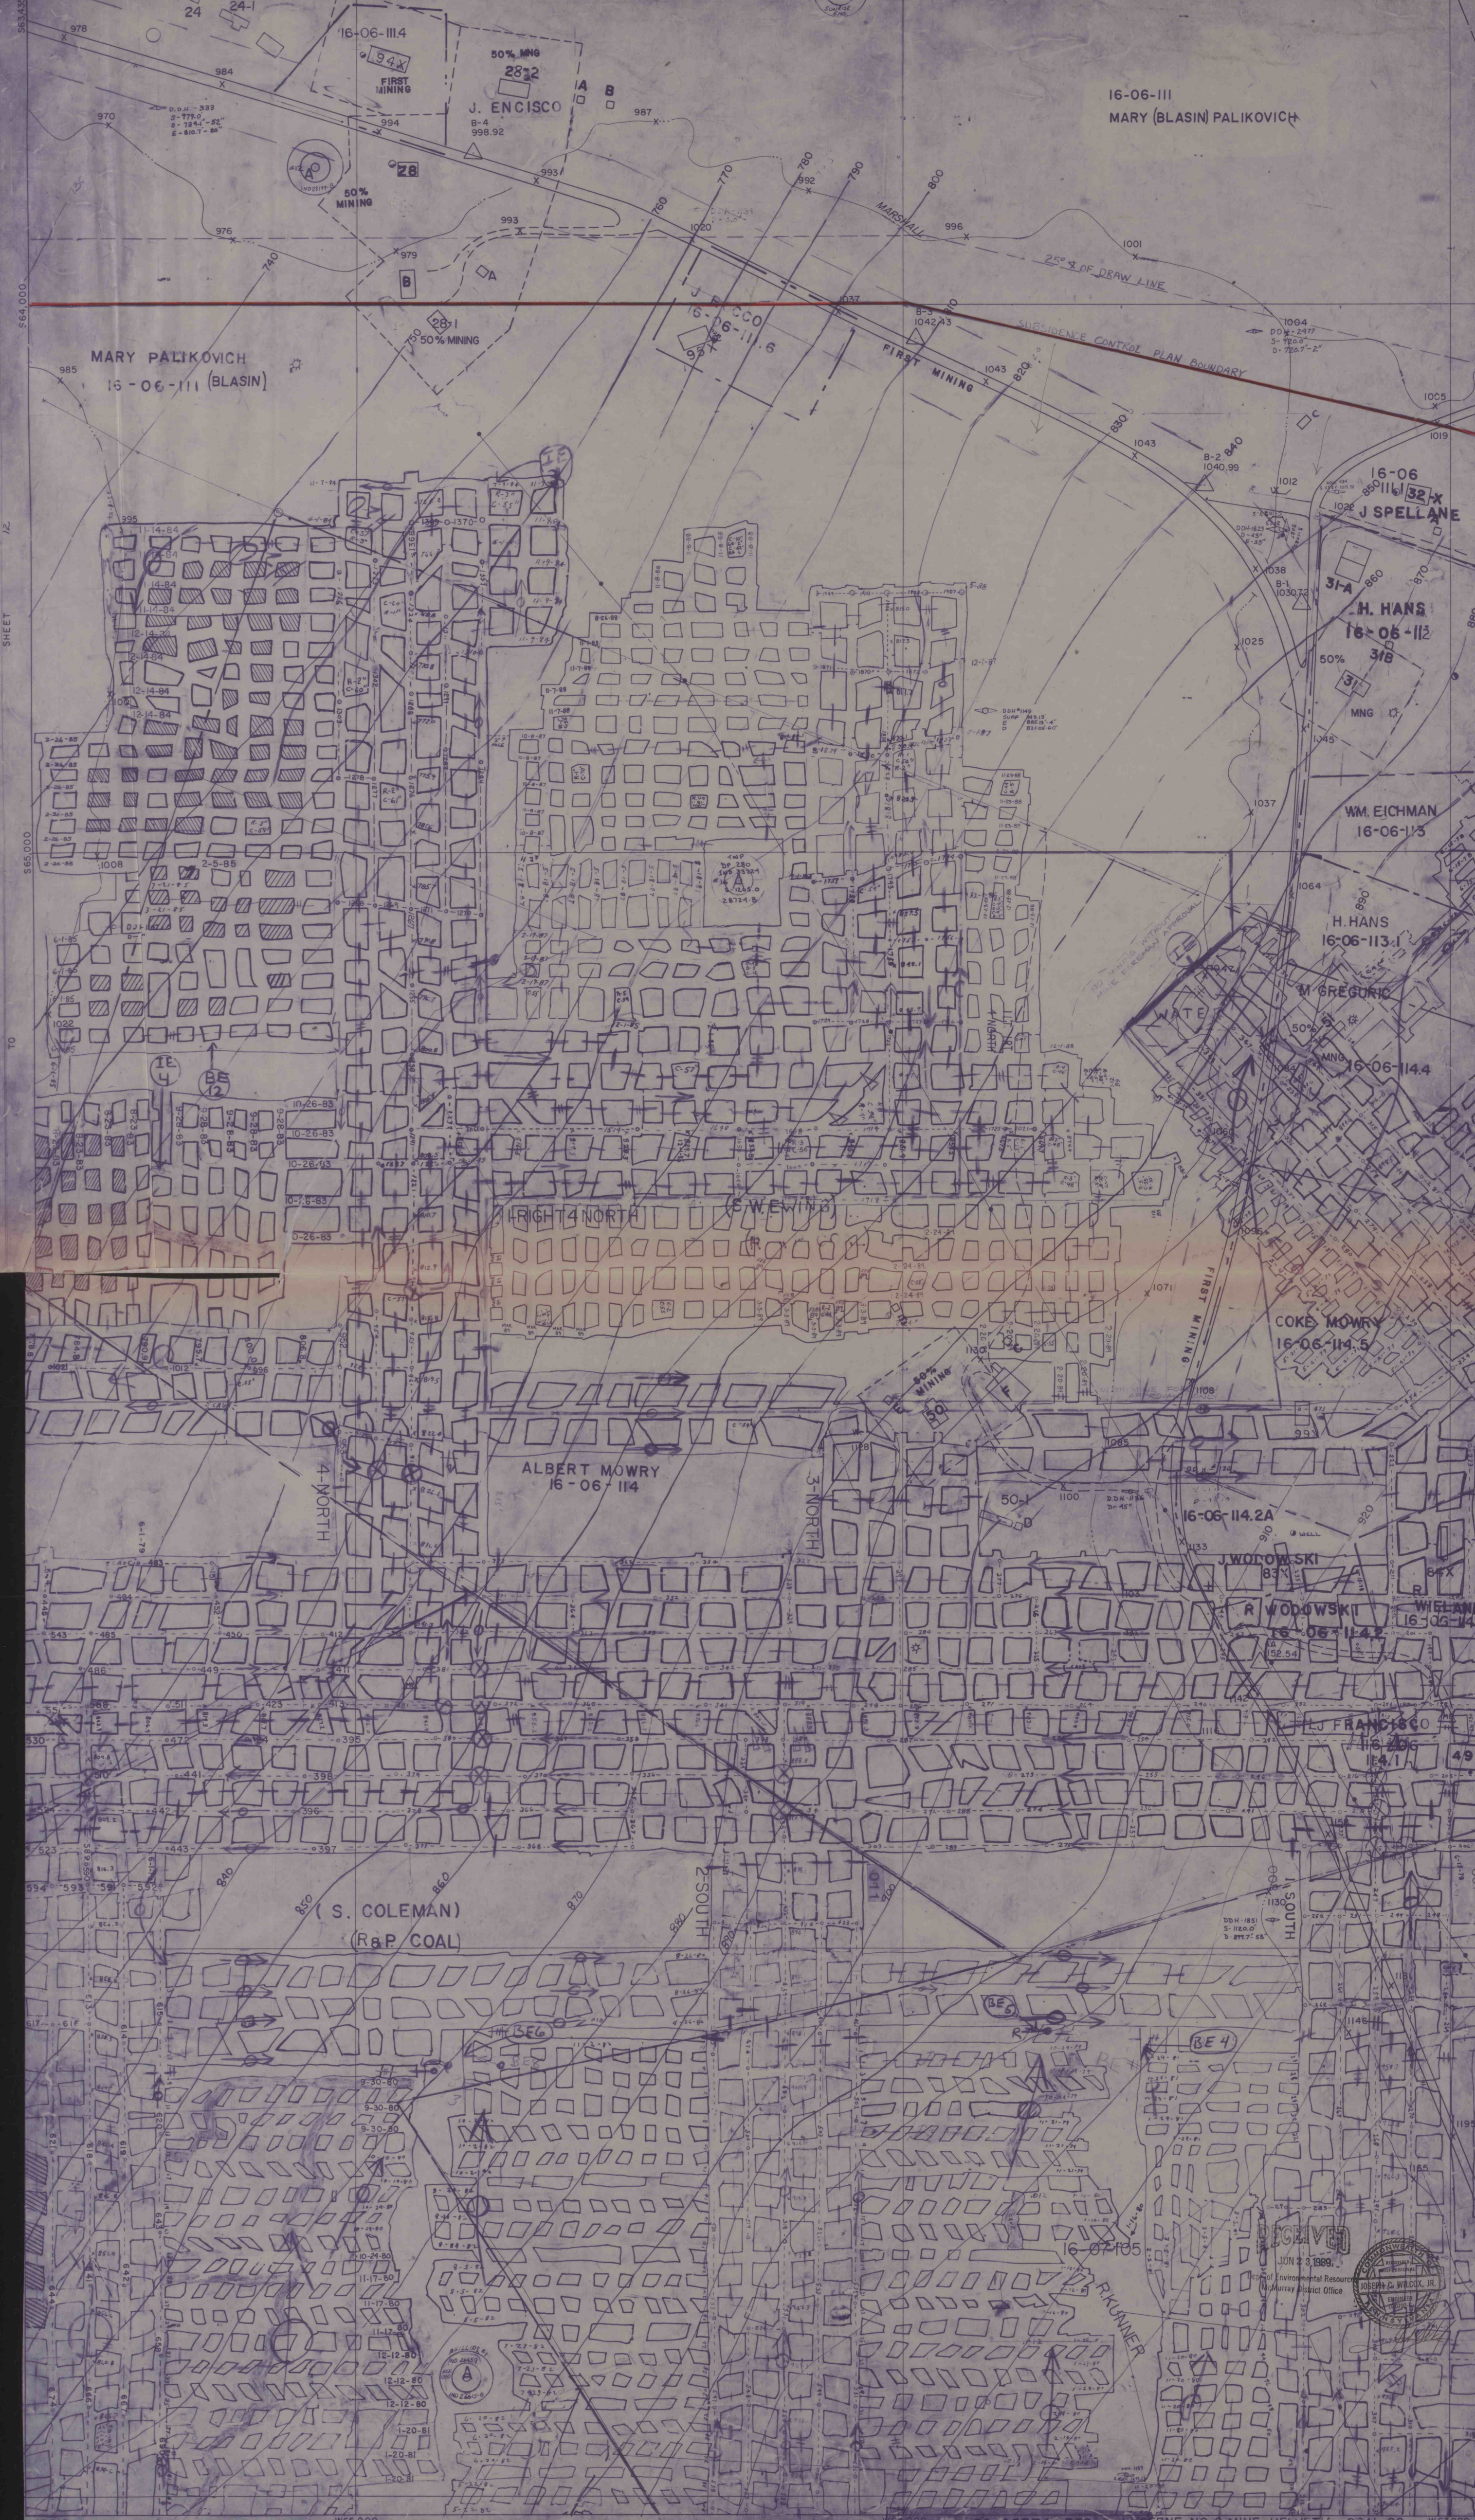

POSTED 68-1-8 TO 68-1-8 CONTEMPLATED MINING 6-1-8 TO 6-1-8