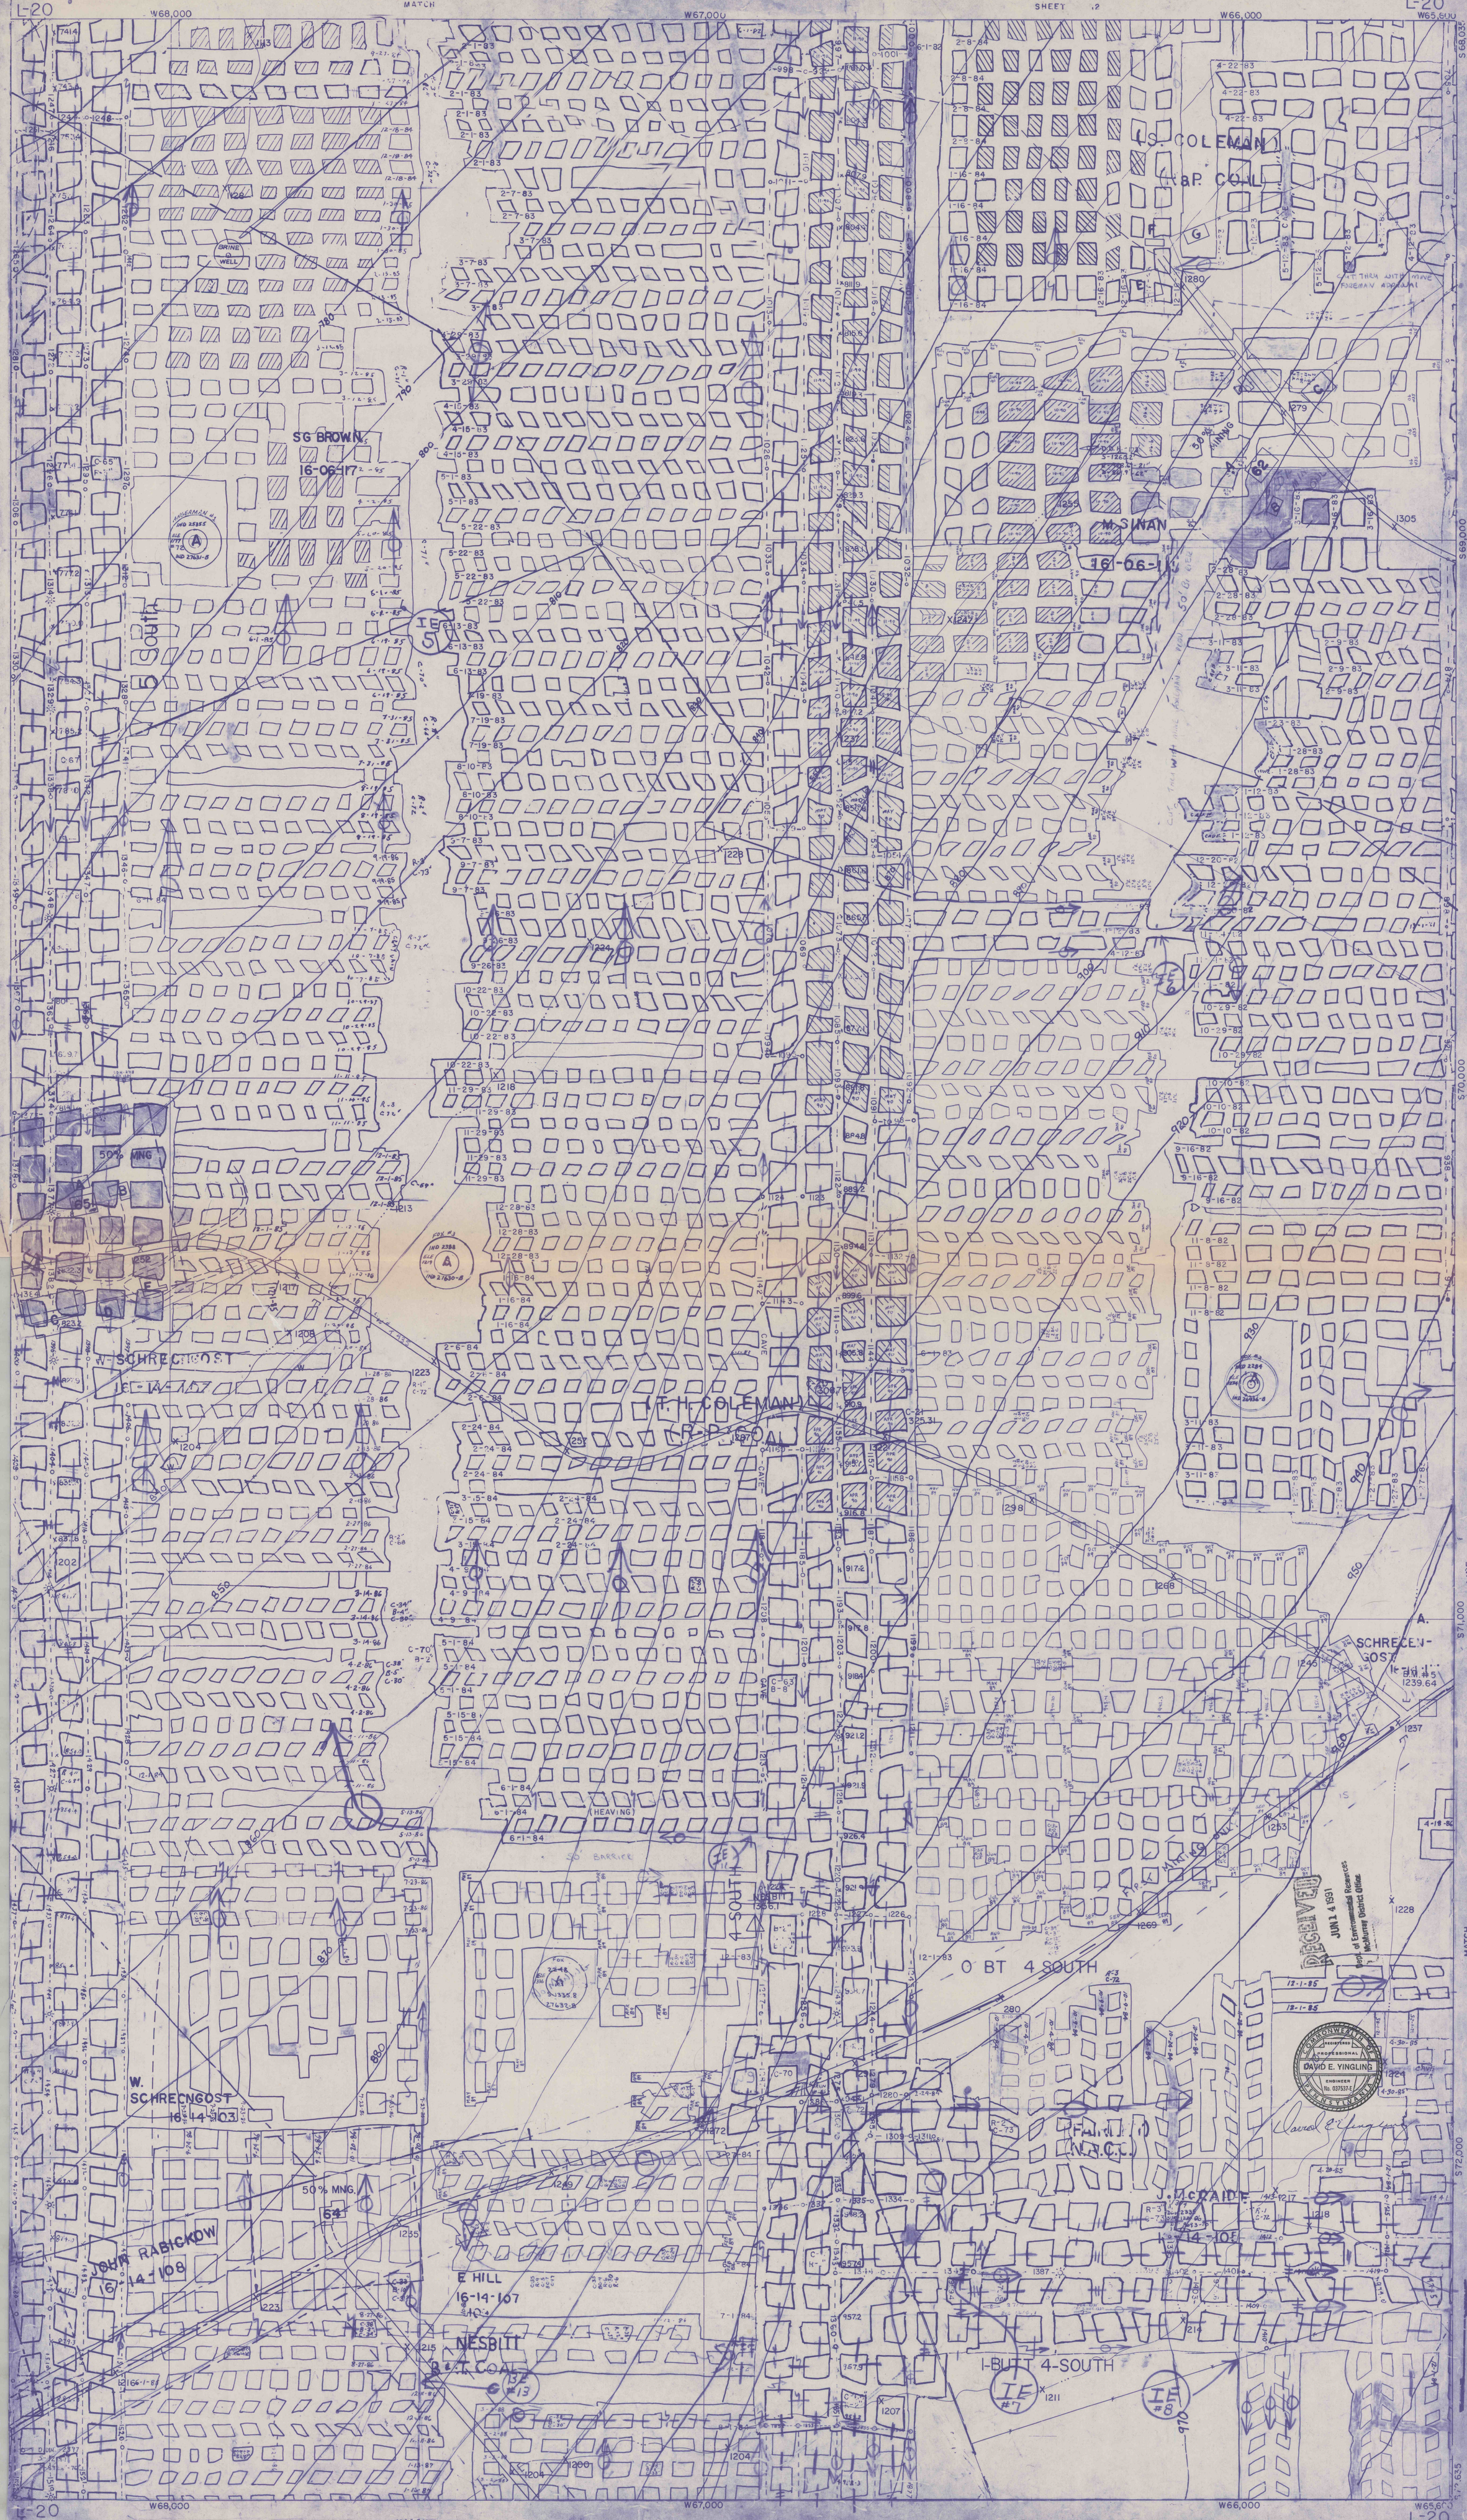
L-20
W68,000
MATCH
W67,000
SHEET 2
W66,000
W65,000
S68,000
S69,000
S70,000
S71,000
S72,000
S72,635
SHEET
TO
MATCH
L-20
T.S. COLEMAN
T.&P. COAL
SG BROWN
16-06-117
M. SINAN
16-06-115
5 South
BRINE WELL
(T.H. COLEMAN)
(R.P. COAL)
W. SCHRECENGOST
16-14-103
JOHN RABICKOW
16-14-108
E HILL
16-14-107
NESBITT
B.&T. COAL
I-BUTT 4-SOUTH
O BT 4 SOUTH
J. MCBRIDE
16-14-105
SCHRECEN-GOST
BM #5
1239.64
50% MNG.
(HEAVING)
50' BARRIER
RECEIVED
JUN 14 1991
Dept. of Environmental Resources
McMurray District Office
COMMONWEALTH OF PENNSYLVANIA
REGISTERED PROFESSIONAL
DAVID E. YINGLING
ENGINEER
No. 037537-E
POSTED 6-1-91
CONTEMPLATED MINING 6-1-91 TO 12-1-91
HELVETIA COAL CO LUCERNE NO.9 36-05374, 35
CONEMAUGH TWP. INDIANA CO. LOWER FREEPORT SEAM