



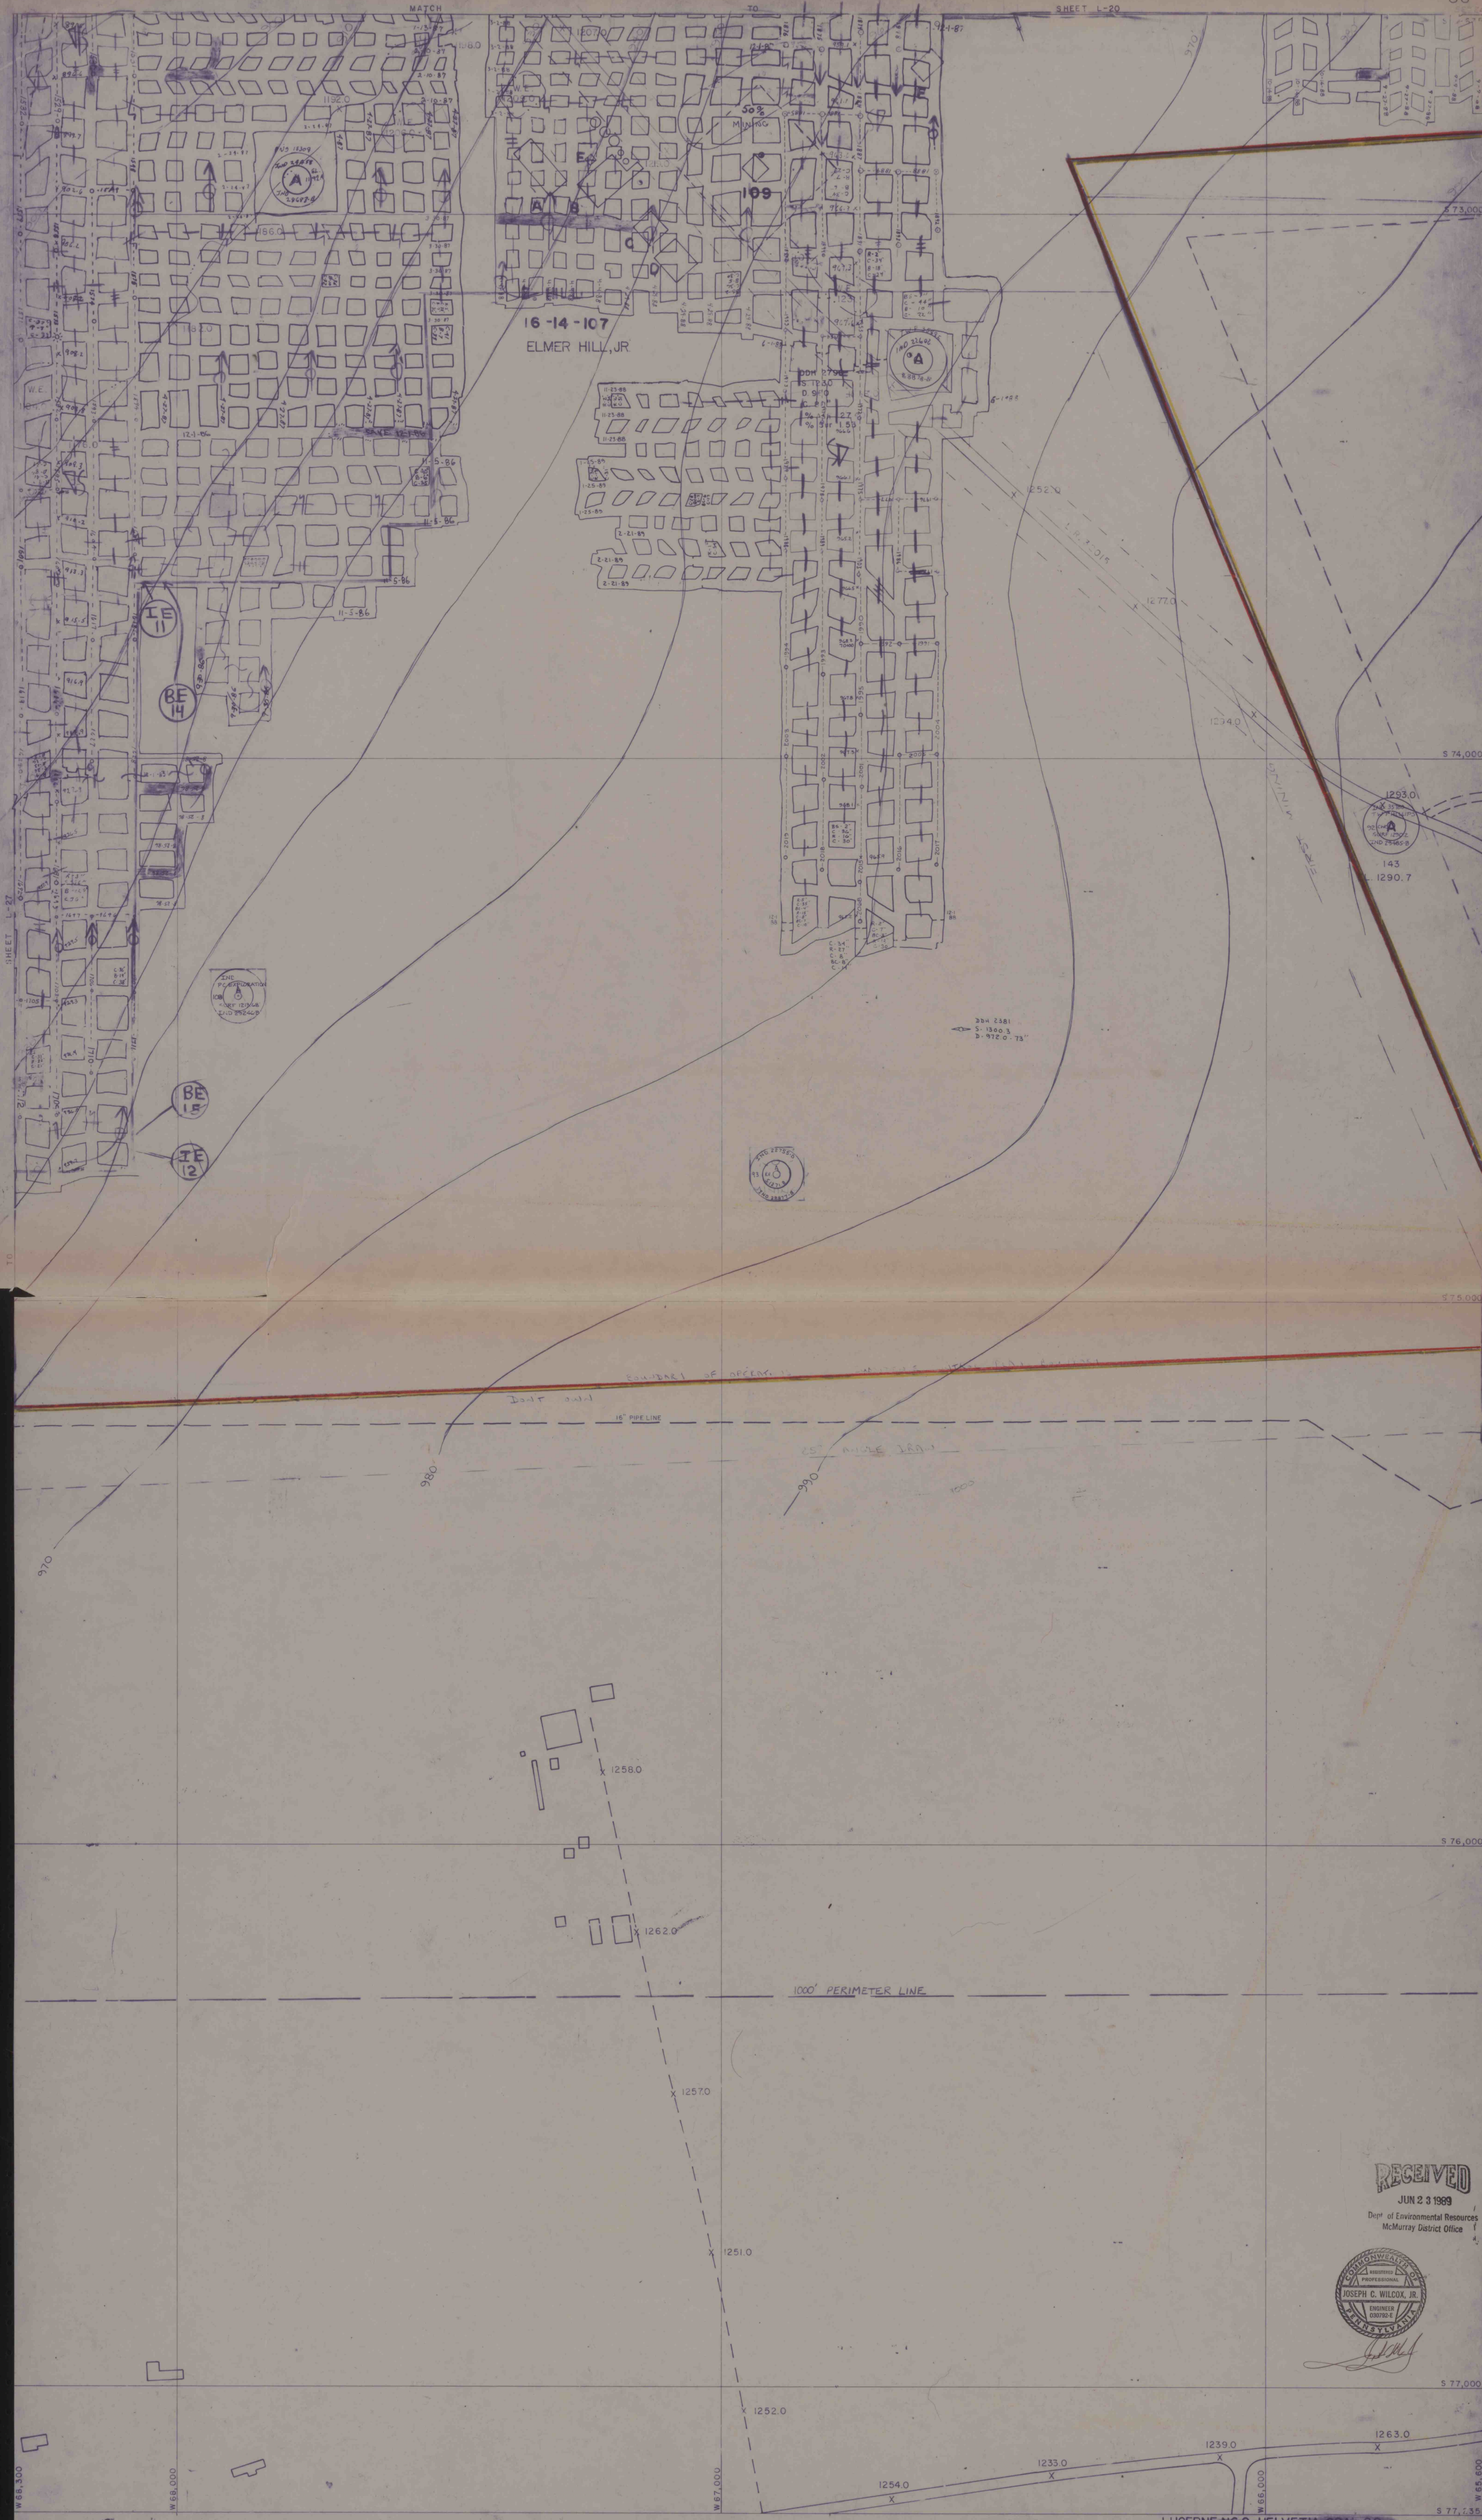

RECEIVED

JUN 23 1989
Dept of Environmental Resources
McMurray District Office

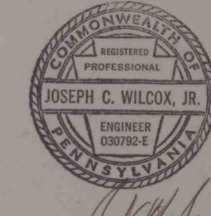

POSTED 6-1-89 CONTEMPLATED MINING 6-1-89 TO 12-1-89