


226 III SW
1 STRONGTOWN

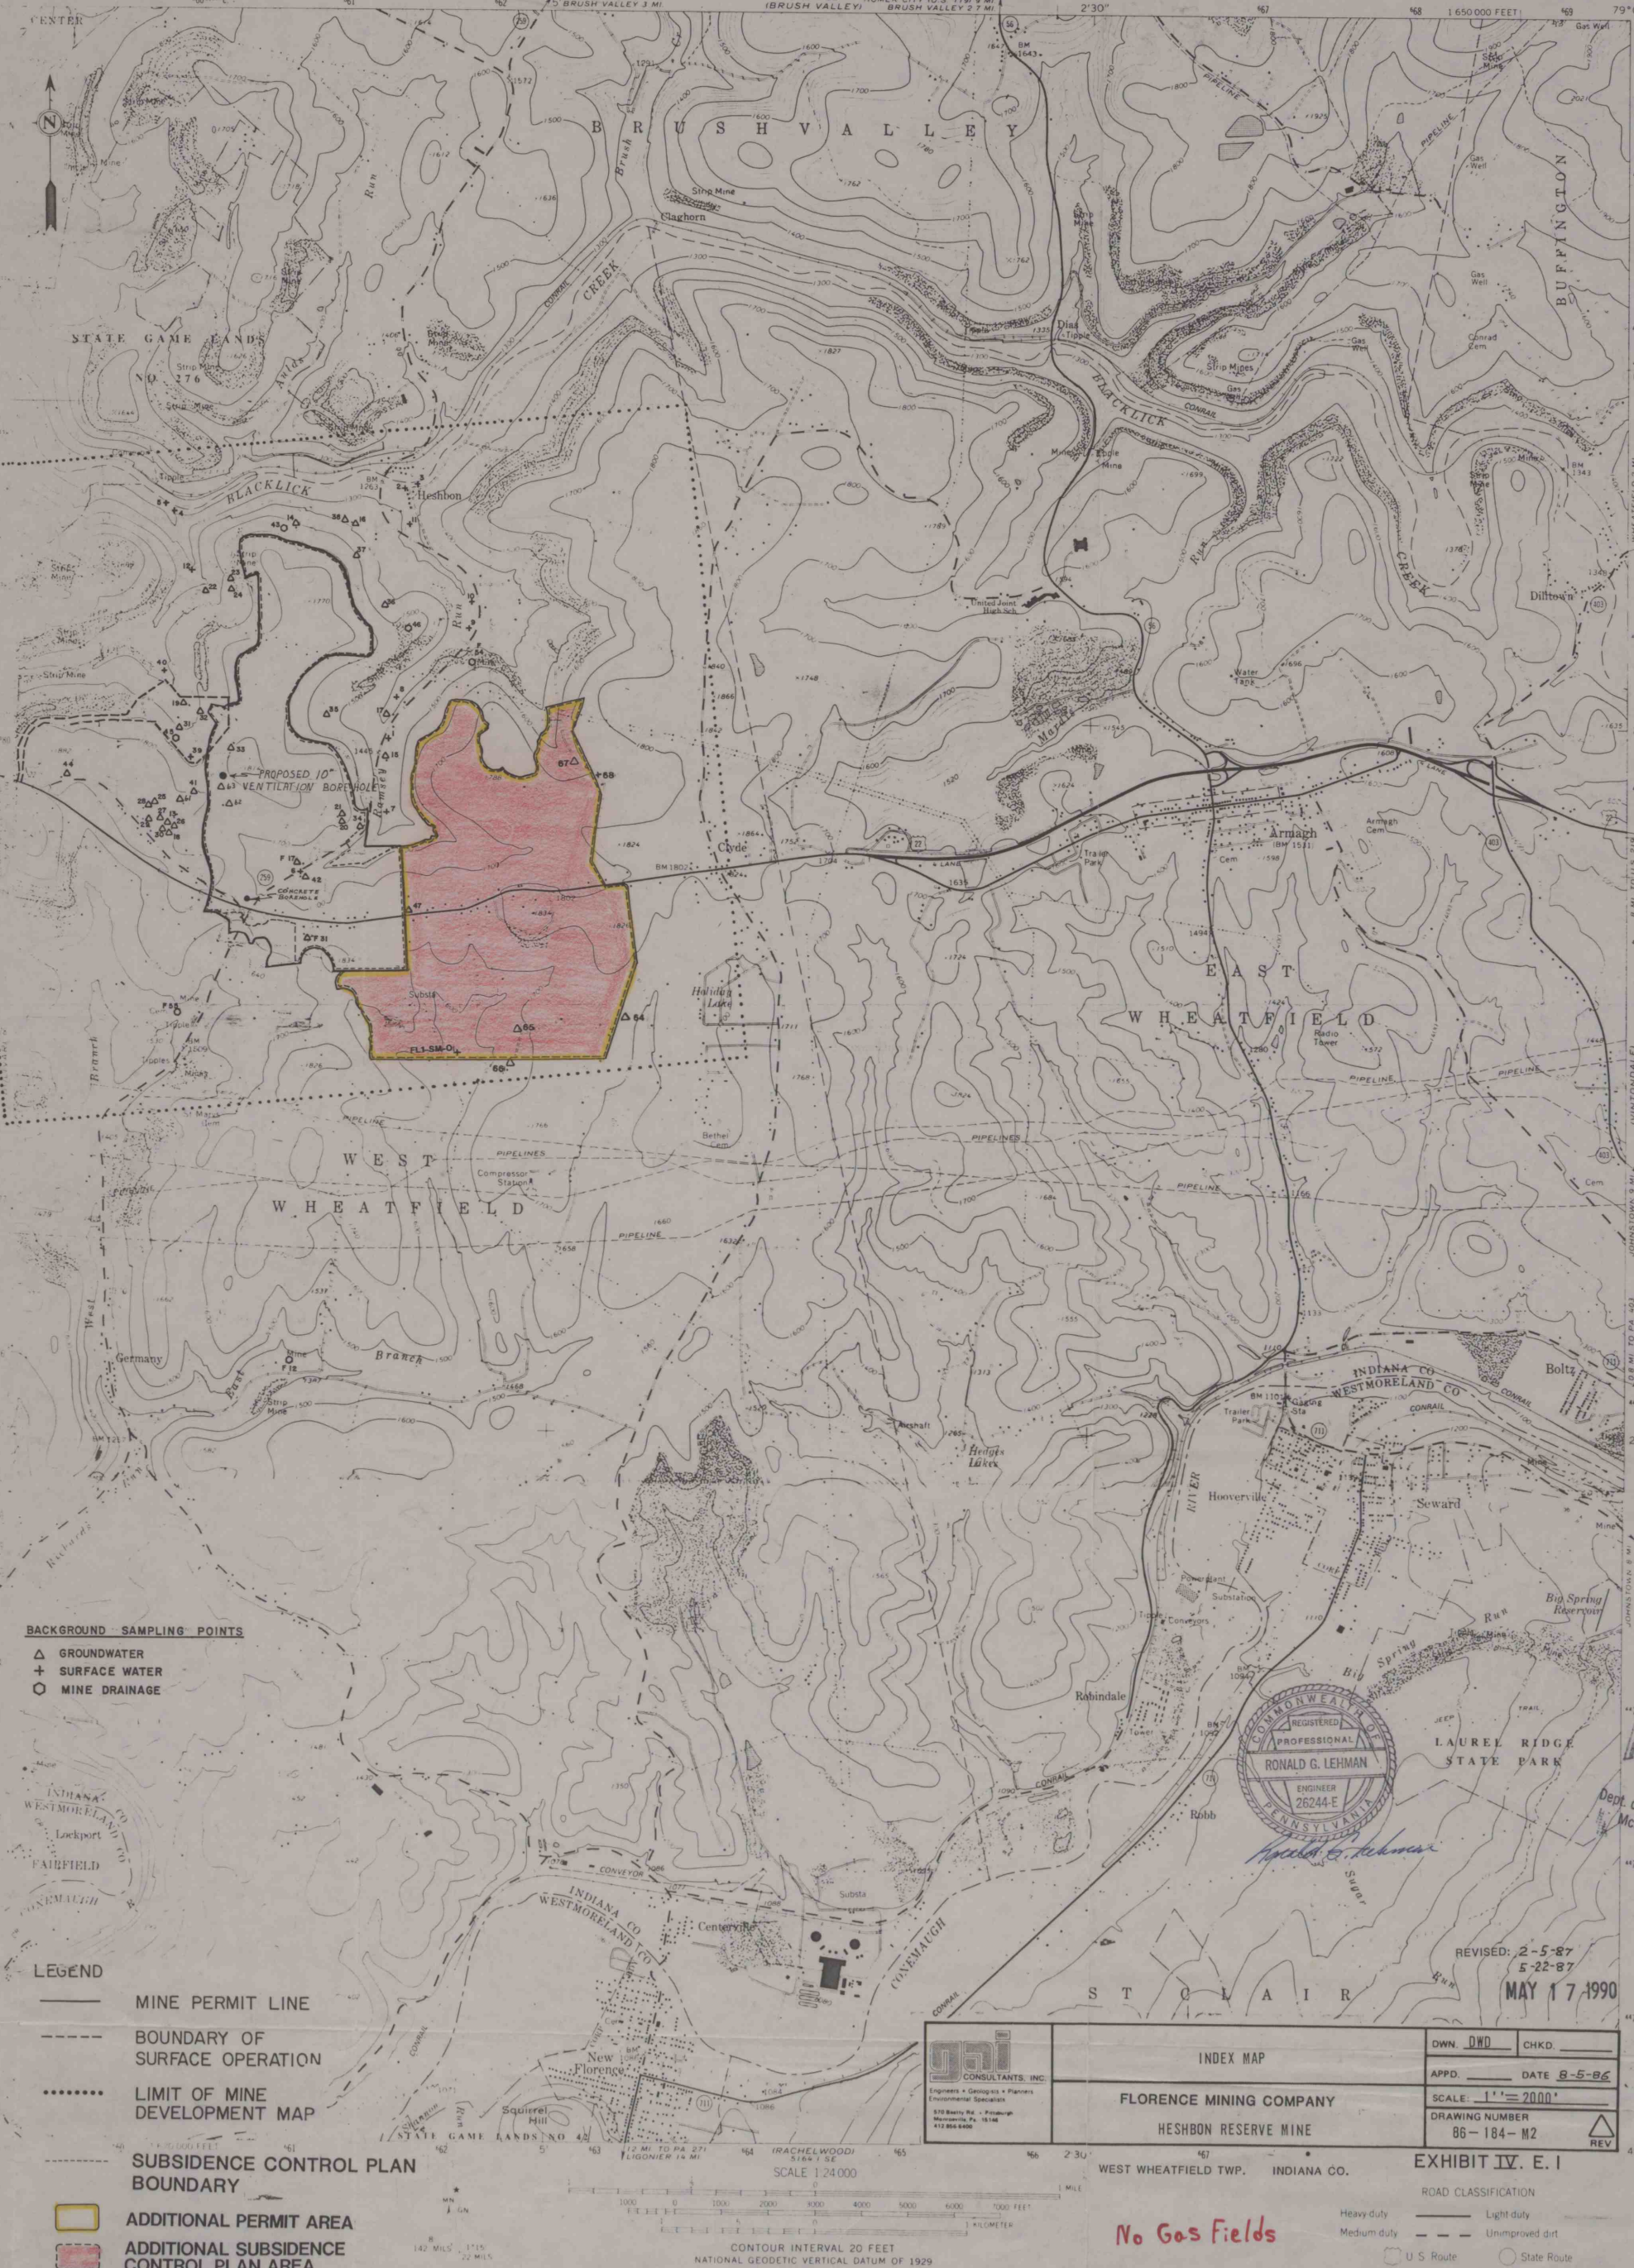

BACKGROUND SAMPLING POINTS
Δ GROUNDWATER
+ SURFACE WATER
○ MINE DRAINAGE

LEGEND
— MINE PERMIT LINE
--- BOUNDARY OF SURFACE OPERATION
..... LIMIT OF MINE DEVELOPMENT MAP
--- SUBSIDENCE CONTROL PLAN BOUNDARY
[Red Shaded Area] ADDITIONAL PERMIT AREA
[Pink Shaded Area] ADDITIONAL SUBSIDENCE CONTROL PLAN AREA

gai
CONSULTANTS, INC.
Engineers • Geologists • Planners
Environmental Specialists
570 Barry Rd. • Pittsburgh
McKeesport, Pa. 15106
412 856-6400

INDEX MAP	
FLORENCE MINING COMPANY	
HESHBON RESERVE MINE	
WEST WHEATFIELD TWP. INDIANA CO.	
OWN. DWD. CHKD.	APPD. DATE 8-5-86
SCALE: 1" = 2000'	
DRAWING NUMBER 86-184-M2	
REV	

RECEIVED
MAY 18 1990
Dept. of Environmental Resources
McMurray District Office

REVISED: 2-5-87
5-22-87
MAY 17 1990

No Gas Fields

ROAD CLASSIFICATION
Heavy duty — Light duty
Medium duty --- Unimproved dirt
○ U.S. Route ○ State Route

PENNSYLVANIA Heshbon topo
QUADRANGLE LOCATION
NEW FLORENCE, PA.

N4022 5-W7900/7.5
1964
PHOTOREVISED 1981
DMA 5164 1 NE-SERIES 1831

20 meters west as shown by dashed corner ticks
Fenced dashed lines indicate selected fence and field lines where
primarily visible on aerial photographs. This information is unchecked
There may be private inholdings within the boundaries of
the National State reservations shown on this map

THIS MAP COMPLIES WITH NATIONAL MAP ACCURACY STANDARDS
FOR SALE BY U.S. GEOLOGICAL SURVEY, RESTON, VIRGINIA 22092
A FOLDER DESCRIBING TOPOGRAPHIC MAPS AND SYMBOLS IS AVAILABLE ON REQUEST

Revisions shown in purple and woodland compiled in cooperation with
Commonwealth of Pennsylvania agencies from aerial photographs taken 1977
and other sources. This information not field checked. Map edited 1981

12301-117